

# **Appendix B**

---

## Geotechnical Study



**EN Engineering, LLC.**  
3000 Executive Parkway, Suite 505  
San Ramon, CA 94583

July 25, 2017  
Project No.: T200

Attention: Mr. Colin Lakin, Project Engineer

Project: Pacific Gas & Electric Co.  
R-893 Replacement Project (I-580 Crossing)  
L-131 MP 32.29  
Livermore, California

Subject: DESKTOP GEOLOGICAL/GEOTECHNICAL STUDY

- References:
1. *"Special Study Zones, Livermore 7.5-Minute Quadrangle, Alameda County, California, Official Map,"* prepared by California Department of Conservation, Division of Mines and Geology, dated January 1, 1982.
  2. *"USGS Open File Report 88-516, Plate-1 Geologic Map of the Livermore Gravels, Alameda County, California,"* prepared by Vincent Barlock, dated 1988.
  3. *"Geotechnical Log of Test Boring Sheet, Arroyo Las Positas Bridge,"* prepared by Caltrans, dated October 27, 2005.
  4. *"Seismic Hazard Zones, Livermore 7.5-Minute Quadrangle, Alameda County, California, Official Map,"* prepared by California Geologic Survey, dated August 27, 2008.
  5. *"Supplemental Geotechnical Investigation, Sage Residential Project – Tract 8121, Portola Avenue, Livermore, California,"* prepared by Berlogar Stevens & Associates, dated April 1, 2013.
  6. *"Pipeline – Design Basis Plan, R-893 Replacement Project,"* prepared by Pacific Gas & Electric Company, dated June 29, 2017.

Dear Mr. Lakin,

As requested, we have prepared this desktop geological / geotechnical study for the design and construction of Pacific Gas and Electric Company's (PG&E) proposed replacement of the R-893 24-inch gas transmission pipeline in Livermore, California. The site location in relation to surrounding streets and landmarks is shown in *Figure No. 1, Vicinity Map*. The purpose of this report is to provide a preliminary geological hazard assessment and geotechnical recommendations prior to completing our proposed geotechnical study. To develop this report, TGE has reviewed project alignment plans and documents, previous geotechnical information by Caltrans and Berlogar Stevens & Associates (see References No. 3 and 5 above) performed in the vicinity of the site, available geologic and seismic hazard maps for the area, and performed a site reconnaissance.

The proposed project consists of installing a 24-inch gas transmission pipeline beneath the I-580 Freeway by means of either Jack-and-Bore or Horizontal Directional Drilling (HDD). Five separate options and alignments are currently being considered for the installation as shown on *Figure No. 2, Plot Plan*. Option No. 3 is most desirable with option No. 5 a second choice. For each option, the trenchless installations will begin on the northside of the I-580 freeway within a new Shea Homes residential development and end within the gravel parking lot of G&M Farms on the south side of I-580. The beginning elevation of the project ranges from approximately 430 to 440 feet above mean sea level (MSL) depending on the option chosen, and ends at approximately 420 feet MSL. In addition to the I-580 freeway, the gas transmission line will cross Arroyo Las Positas, a small creek.

The study area is generally underlain by Surficial Deposits (Qu) as shown on *Figure No. 3, Regional Geology Map*. Based on review of boring logs in the vicinity of the project by Caltrans and Berlogar Stevens & Associates, these materials consist primarily of clay in a stiff to very stiff condition, with relatively thin interlayered zones of silty sand, clayey sand, poorly-graded sand and gravel.

During the site reconnaissance, standing water was observed within Arroyo Las Positas. Therefore, groundwater is anticipated within the project alignment. Caltrans encountered groundwater during their exploratory borings performed for the I-580 Arroyo Las Positas bridge overcrossing at elevations ranging from approximately 387 feet to 403 feet MSL. The exploratory borings performed for the Shea Homes development on the north side of the alignment did not encounter groundwater to the maximum depth explored of approximately 407 feet MSL.

Based on our review of the USGS fault map shown in *Figure No. 4, Regional Fault Map*, no known active faults with the potential for surface fault rupture are known to exist beneath the project alignment. Accordingly, the potential for surface rupture at the site due to faulting is considered very low during the design life of the proposed structures. A detailed fault investigation is not recommended. However, regional seismic activity is capable of producing high ground accelerations and strong ground shaking. The Seismic Hazard Zones Map (see *Figure No. 5*) indicates that the project alignment is within an area of liquefaction potential (i.e., area consisting of alluvial deposits with presence of shallow groundwater) and earthquake-induced landslide potential. The potential for liquefaction and landslides should be addressed by the design level geotechnical report.

The geotechnical borings in the area suggest that the project alignment is underlain primarily by clayey soils. Fine grained soils such as clay and silt are not suitable for use as fills in utility trenches. In addition, clay soils typically have a low electrical resistivity which can present a high potential for corrosion to buried ferrous materials. The design level geotechnical report should evaluate corrosion potential and provide mitigation considerations, if necessary.

A potential for scour exists within Arroyo Las Positas. Based on our preliminary review the potential for scour ranges from about 10 to 12 feet below existing ground surface. The design level geotechnical report should evaluate the potential scour depth to ensure the gas line is installed sufficiently below the maximum scour depth.

Construction considerations include groundwater and variable ground conditions along the project alignment. The design level geotechnical report should specifically address detailed construction recommendations related to installation of the pipeline by means of Jack-and-Bore and HDD methods.


TGE appreciates the opportunity to provide this geotechnical engineering service for this project and we look forward to continuing our role as your geotechnical engineering consultant. Please do not hesitate to contact the undersigned with any questions, comments, or concerns regarding this project.

Respectfully submitted,

**TRINITY Geotechnical Engineering, Inc.**

  
Jeffrey Magalong, PE  
President



  
Dennis Poland, PG, CEG  
Principal Engineering Geologist



Reviewed by,  
**VO Engineering, Inc.**

  
Van Olin, PE, GE  
Principal Geotechnical Engineer



7/25/17

Attachments: Figure No. 1 – Vicinity Map  
Figure No. 2 – Plot Plan  
Figure No. 3 – Regional Geology Map  
Figure No. 4 – Regional Fault Map  
Figure No. 5 – Seismic Hazard Zones Map


Appendix A – Caltrans Log of Test Boring Sheets  
Appendix B – Shea Homes Geotechnical Report

Distribution: (1) Addressee, via email





# FIGURES

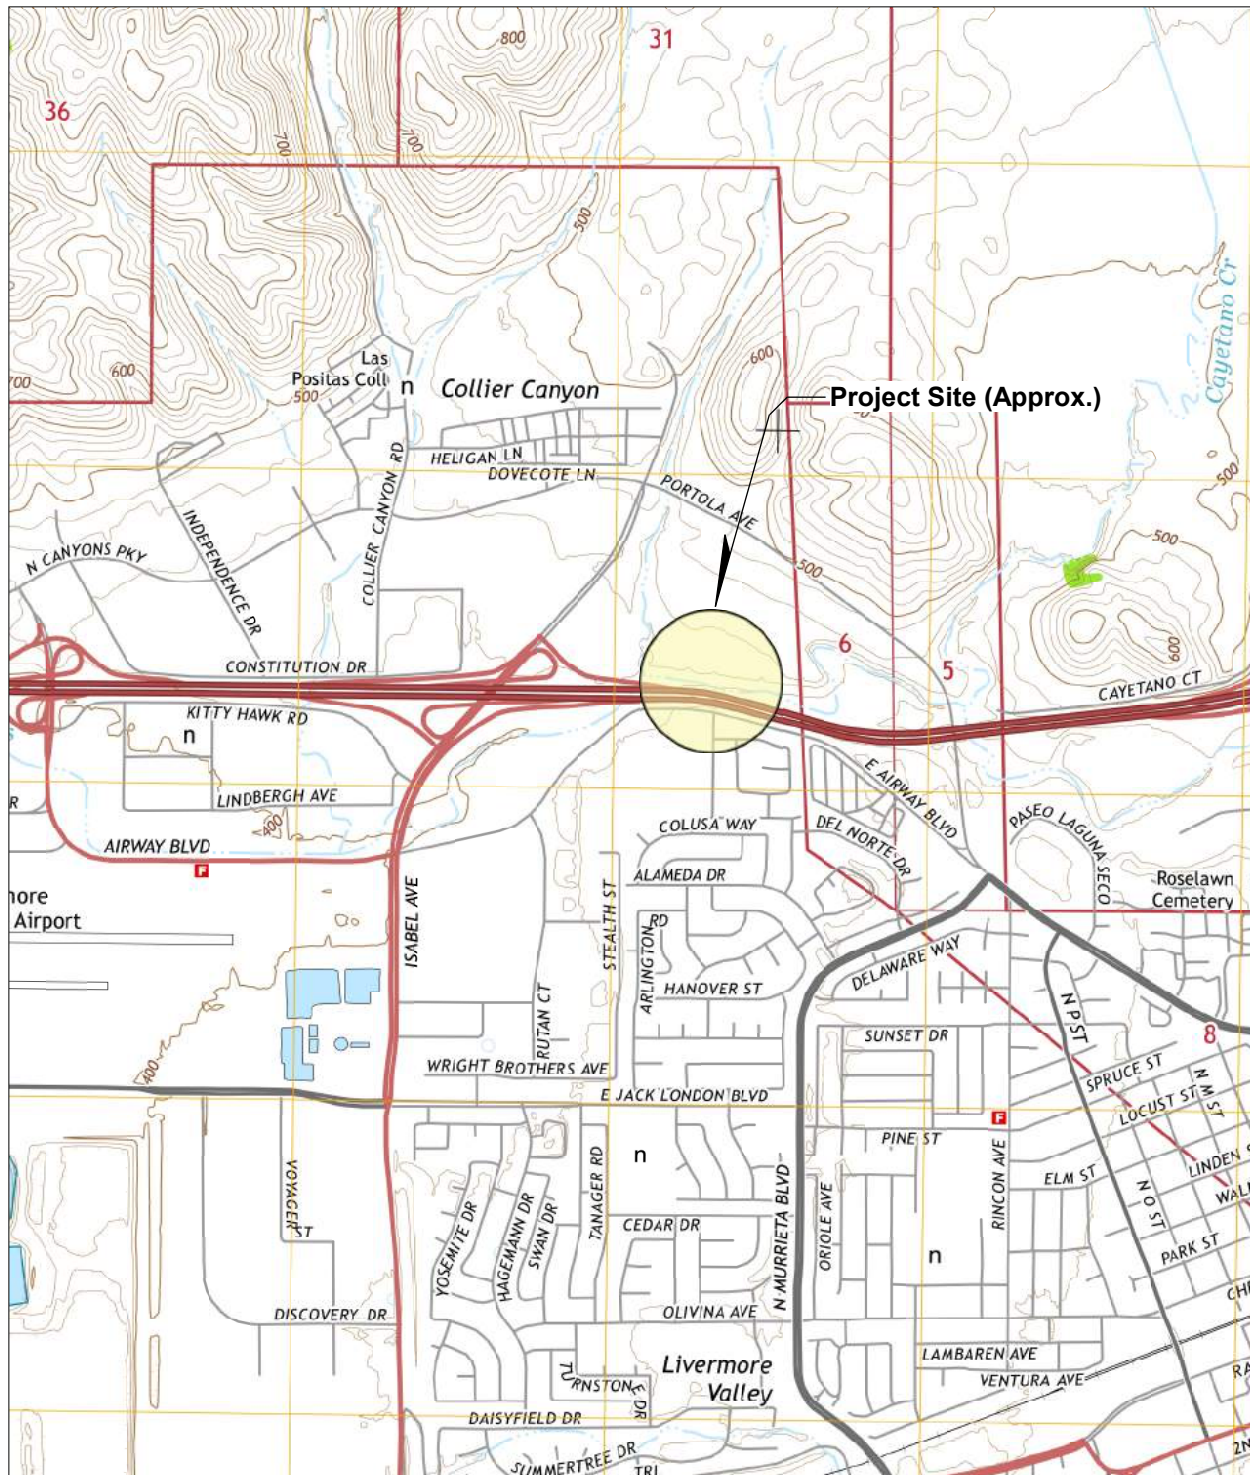

Reference: USGS 2015 Topographic Map (Livermore, CA - 7.5 Minute Quadrangle)




Gas Transmission & Distribution  
Pacific Gas and Electric Co.  
San Francisco, California

## Vicinity Map

R-893 Replacement Project  
Livermore, CA

TGE Project No.: T200

Figure No.: 1

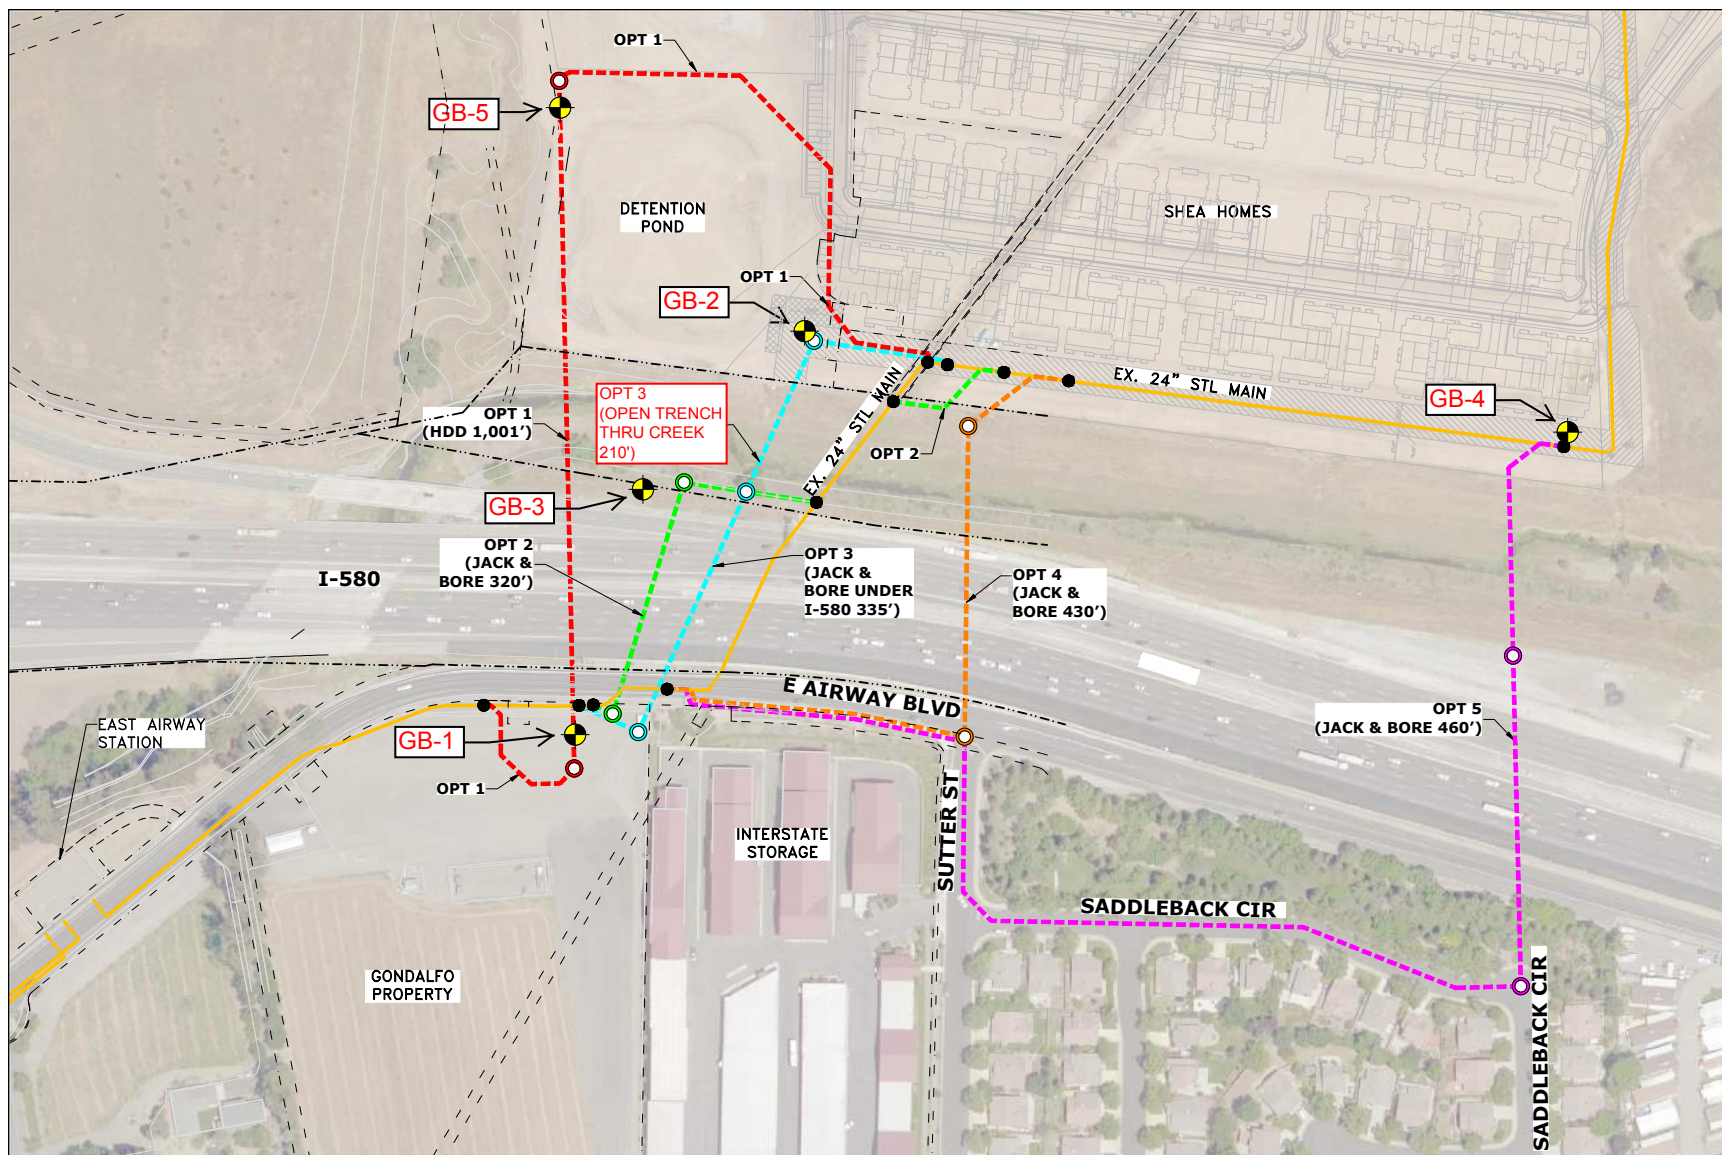

Reference: Pipeline - Design Basis Plan, R-893 Replacement Project, L-131 MP 32.29, Replace 24" Gas Pipeline - Livermore, CA, Dwg. No. 74008389, prepared by EN Engineering, dated 4/29/17.



#### Legend

- Prop. Boring Locations (Approx.)
- Prop. Bore/HDD Entry / Exit
- Prop. Tie-in
- Option 1
- Option 2 (Ruled out)
- Option 3
- Option 4
- Option 5

Gas Transmission & Distribution  
Pacific Gas and Electric Co.  
San Francisco, California


#### Plot Plan

**R-893 Replacement Project  
Livermore, CA**

TGE Project No.: T200

Figure No.: 2



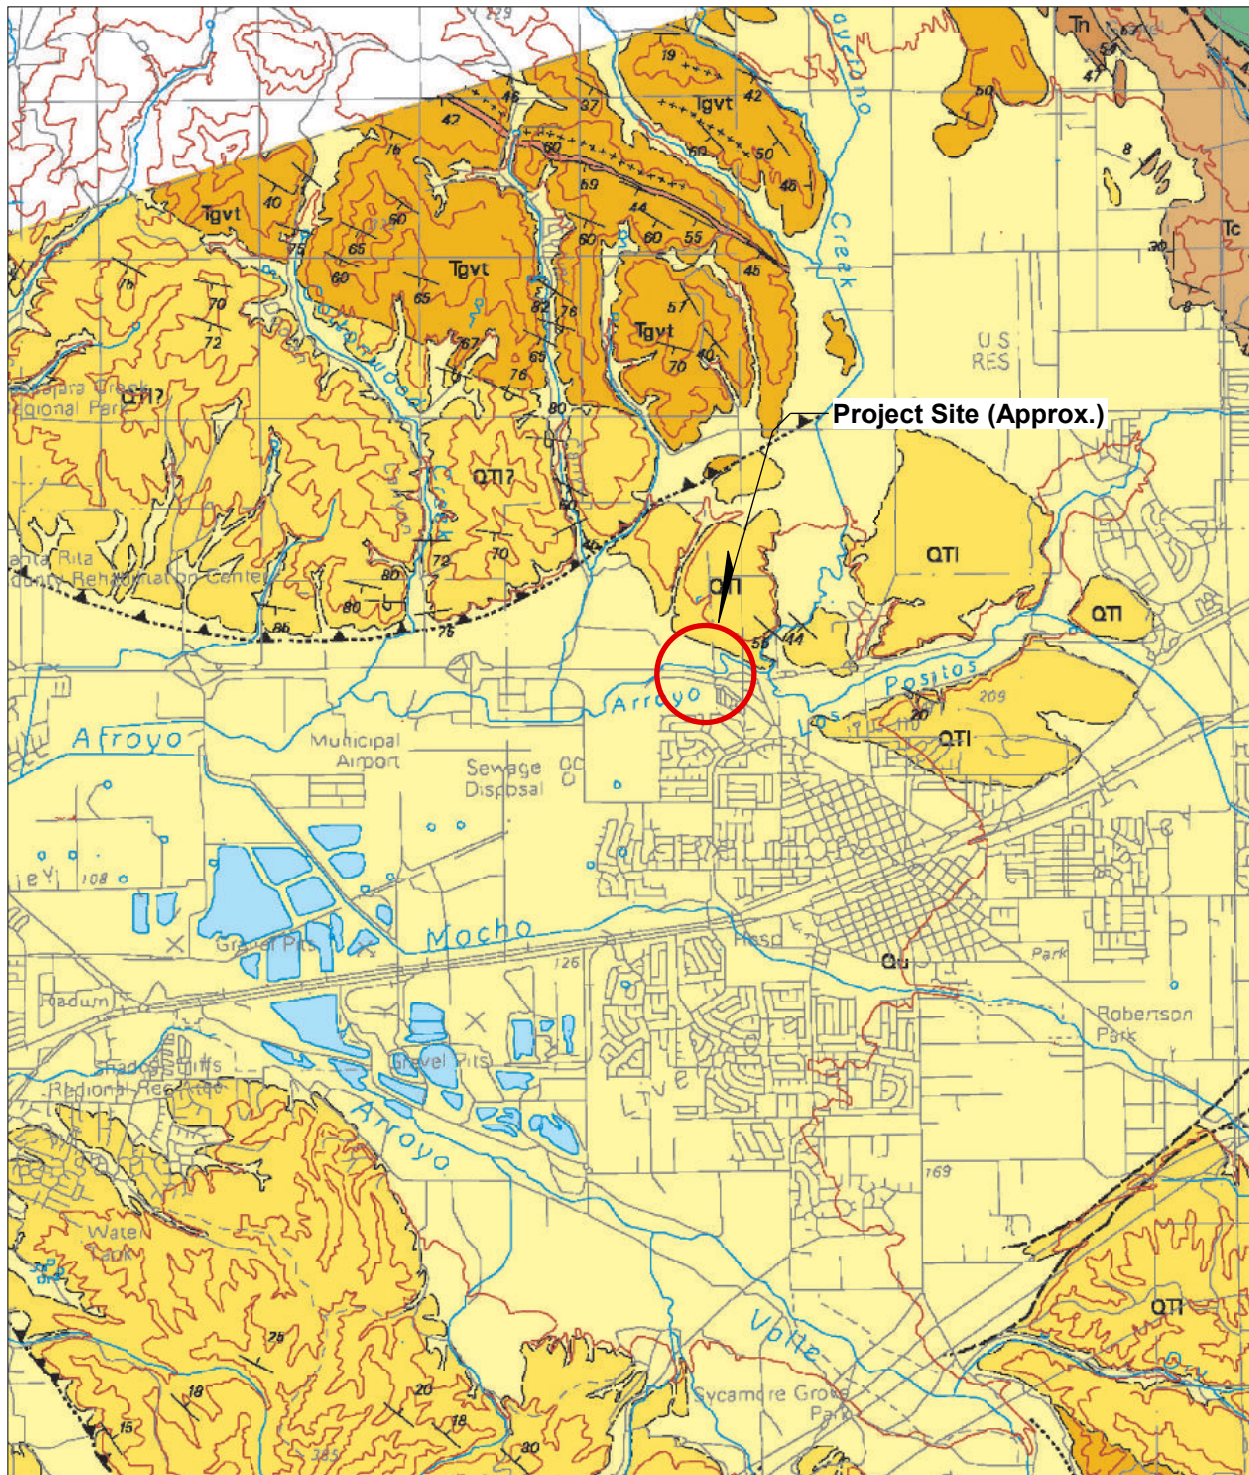

Reference: Preliminary Geologic Map Emphasizing Bedrock Formations in Alameda County, California: Derived from the Digital Database Open-File 96-252, dated 1996.

#### MAP UNITS

Qu - Surficial Deposits (undivided)



Gas Transmission & Distribution  
Pacific Gas and Electric Co.  
San Francisco, California


#### Regional Geology Map

R-893 Replacement Project  
Livermore, CA

TGE Project No.: T200

Figure No.: 3



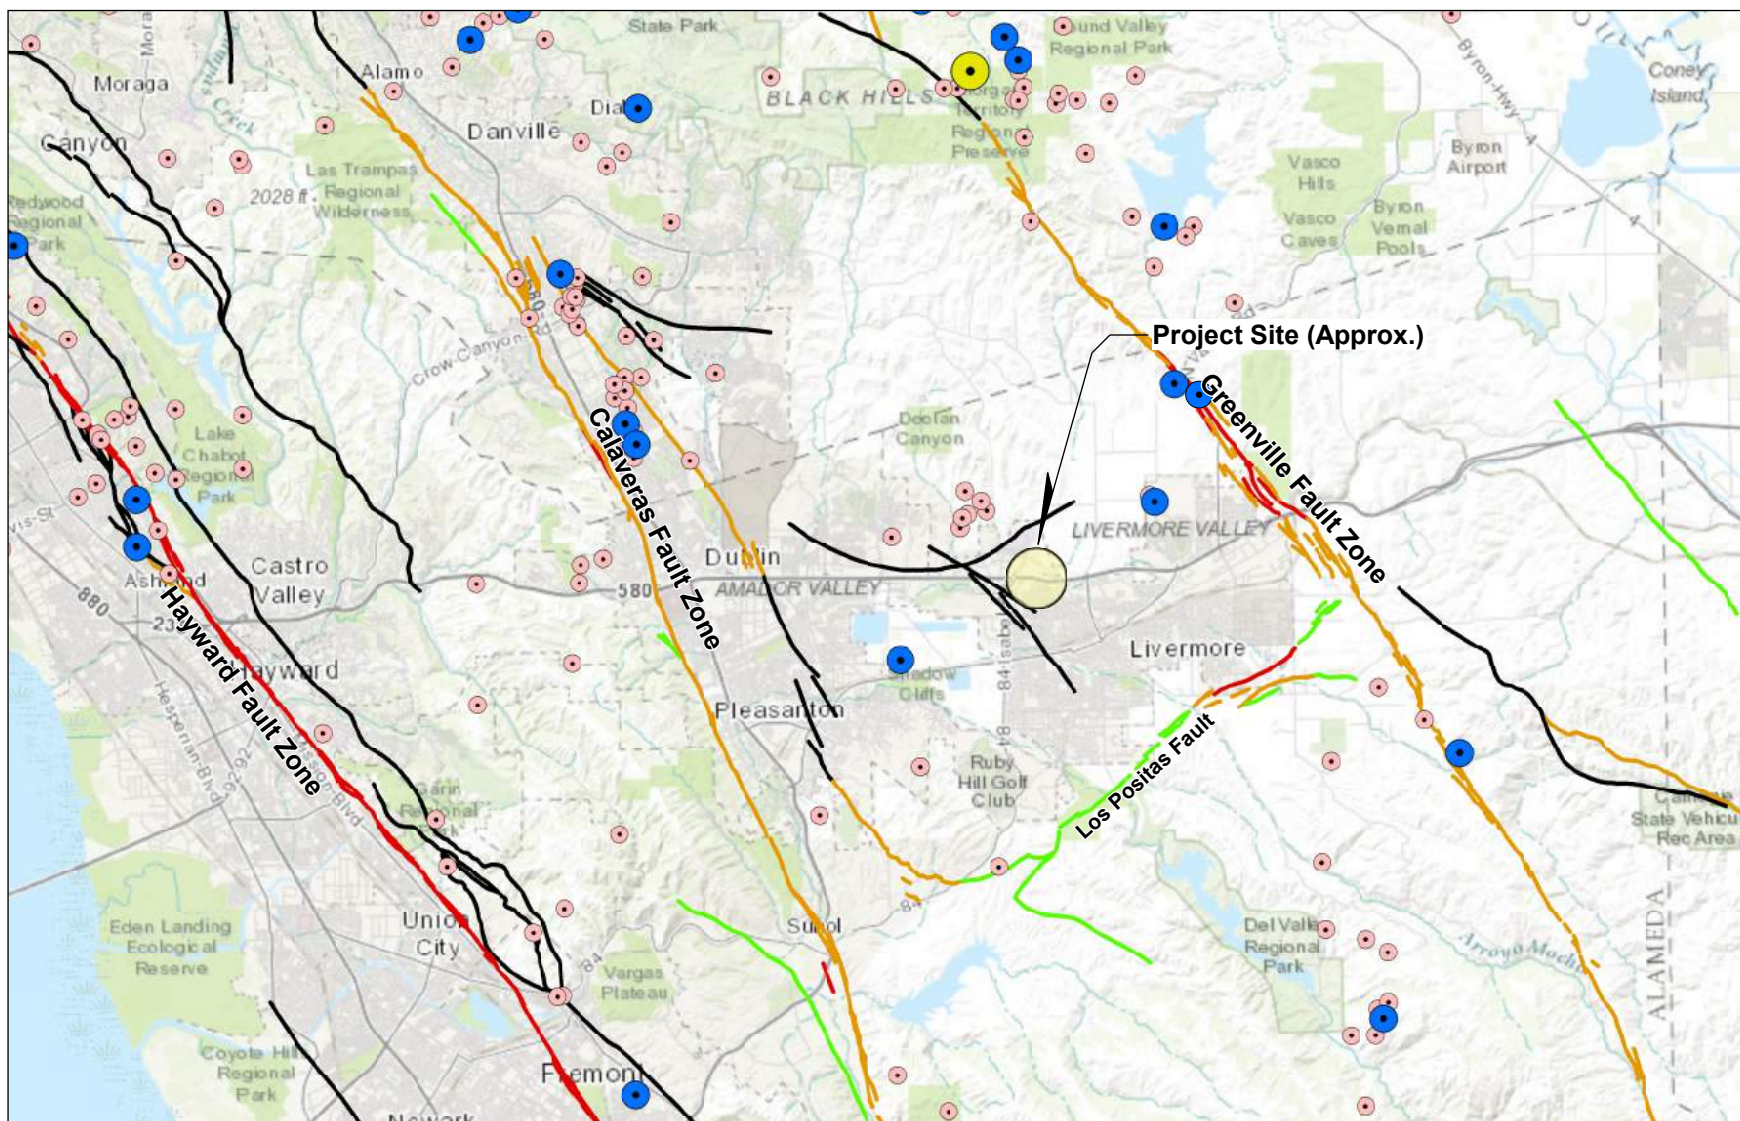

Reference: Esri; U.S. Geological Survey and California Geological Survey, 2006, Quaternary fold and fault database for the United States; USGS Earthquake Archives

**Quaternary Faults** - Faults are classified by age of last known movement.

Historic — <150 years ago    Holocene to Latest Pleistocene — <15,000 years ago    Late Quaternary — <130,000 years ago    Quaternary — >1.6 Ma



**Earthquake Epicenter  
by Magnitude**

- 3.0 - 3.9
- 4.0 - 4.9
- 5.0 - 5.9

Gas Transmission & Distribution  
**Pacific Gas and Electric Co.**  
San Francisco, California


## Regional Fault Map

**R-893 Replacement Project  
Livermore, CA**

TGE Project No.: T200

Figure No.: 4



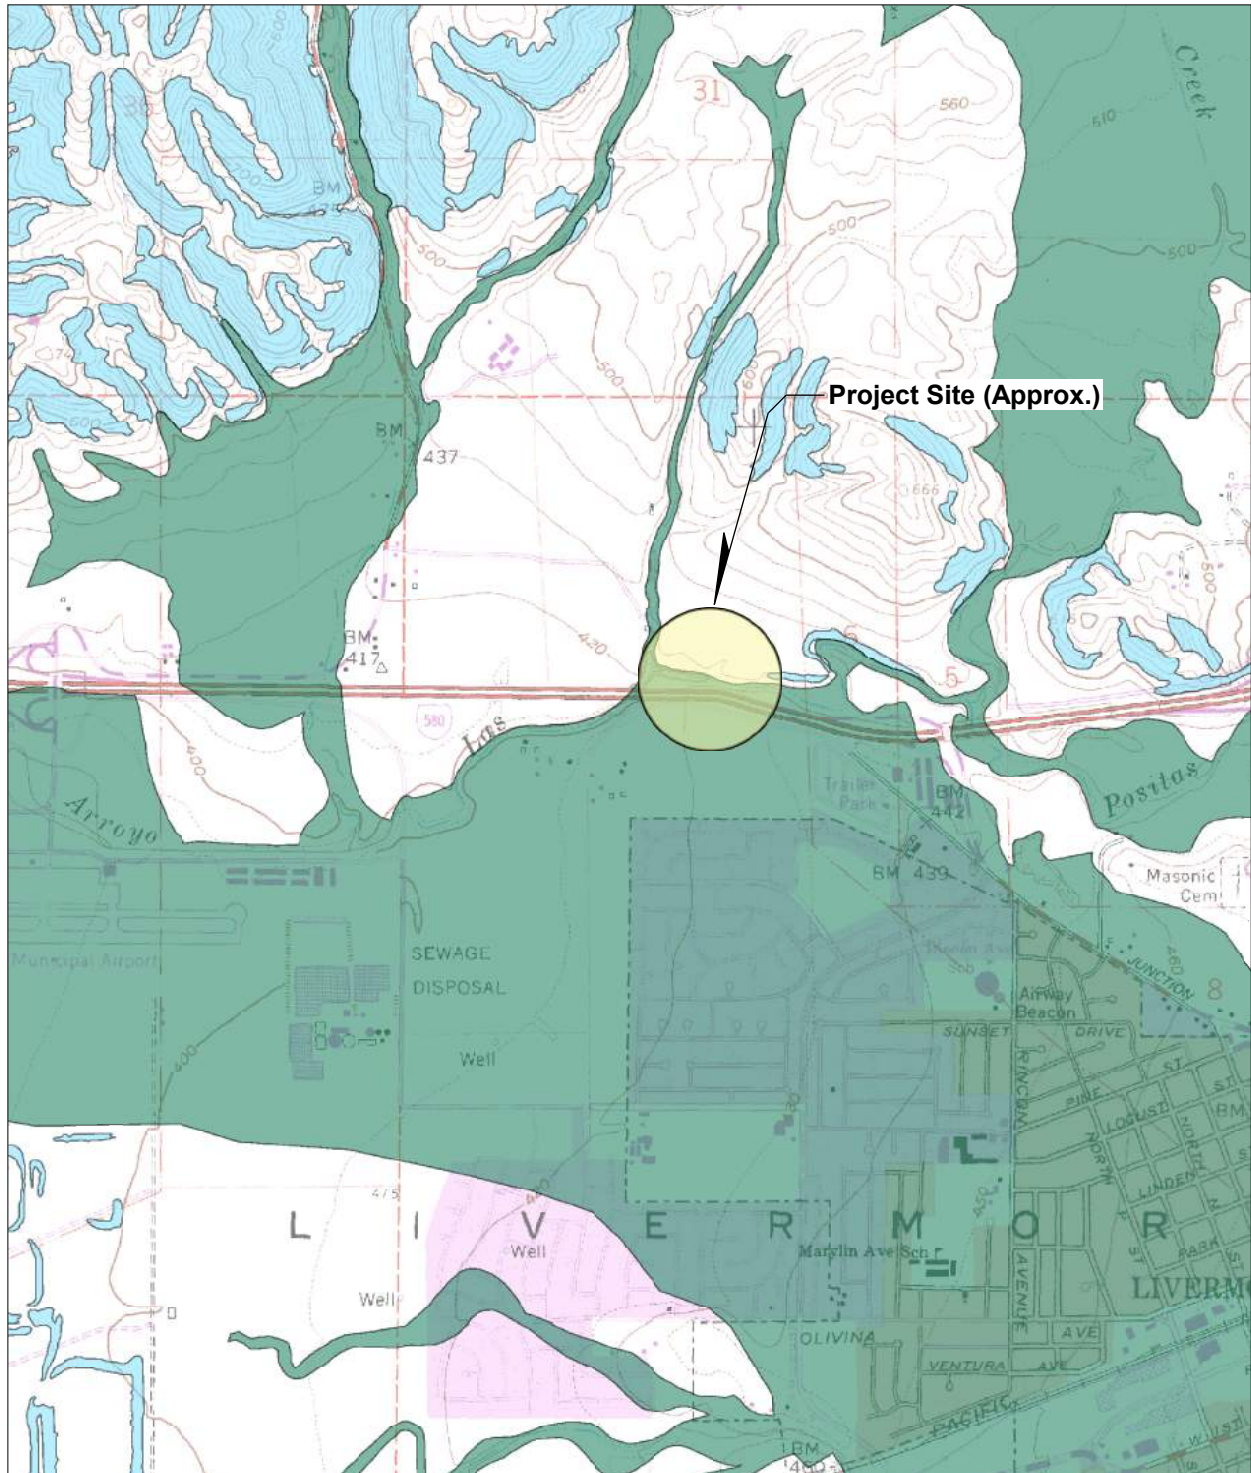

N  
Scale  
1:24000

Reference: CGS Earthquake Zones of Required Investigation, Livermore, Quadrangle, dated 2008

**MAP UNITS**

- Liquefaction Zones
- Earthquake-Induced Landslide Zones



Gas Transmission & Distribution  
Pacific Gas and Electric Co.  
San Francisco, California

**Seismic Hazard Zones Map**

**R-893 Replacement Project  
Livermore, CA**

TGE Project No.: T200

Figure No.: 5



# **APPENDIX A**


## **Caltrans Log of Test Boring Sheets**







CURVE DATA						
No.	RADIUS	DELTA	TANGENT	LENGTH	NORTHING	EASTING
①	599.395	14°48'26"	77.886	154.904	633453.6850	1885777.6987
②	210.000	37°10'54"	70.635	136.278	634309.0532	1885576.2420
③	1000.000	2°51'53"	25.005	50.000	633032.2448	1885591.5118
④	1213.167	1°59'48"	21.141	42.278	633444.4479	1885728.8504
⑤	1002.400	2°51'59"	25.078	50.146	633026.1240	1885628.2119

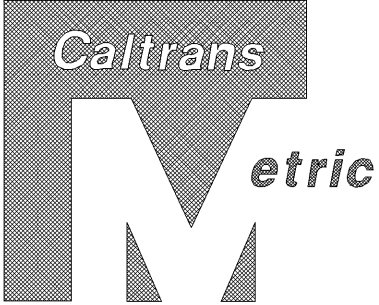

Dist 04

COUNTY Alameda

ROUTE 84,580

KILOMETER POST TOTAL PROJECT 46.4/47.2, 21.0/24.0

SHEET No. 18

TOTAL SHEETS 477

REGISTERED CIVIL ENGINEER

DATE 3/31/08

PLANS APPROVAL DATE 7-28-08

THE STATE OF CALIFORNIA OR ITS OFFICERS OR AGENTS SHALL NOT BE RESPONSIBLE FOR THE ACCURACY OR COMPLETENESS OF ELECTRONIC COPIES OF THIS PLAN SHEET.

CITY OF LIVERMORE 1052 SOUTH LIVERMORE AVENUE LIVERMORE, CA 94550


MARK THOMAS & COMPANY, INC. 5000 HOPYARD RD, SUITE 315 PLEASANTON, CA 94588

JIMMY W. SIMS

No. 35458

Exp. 09/30/09

CIVIL

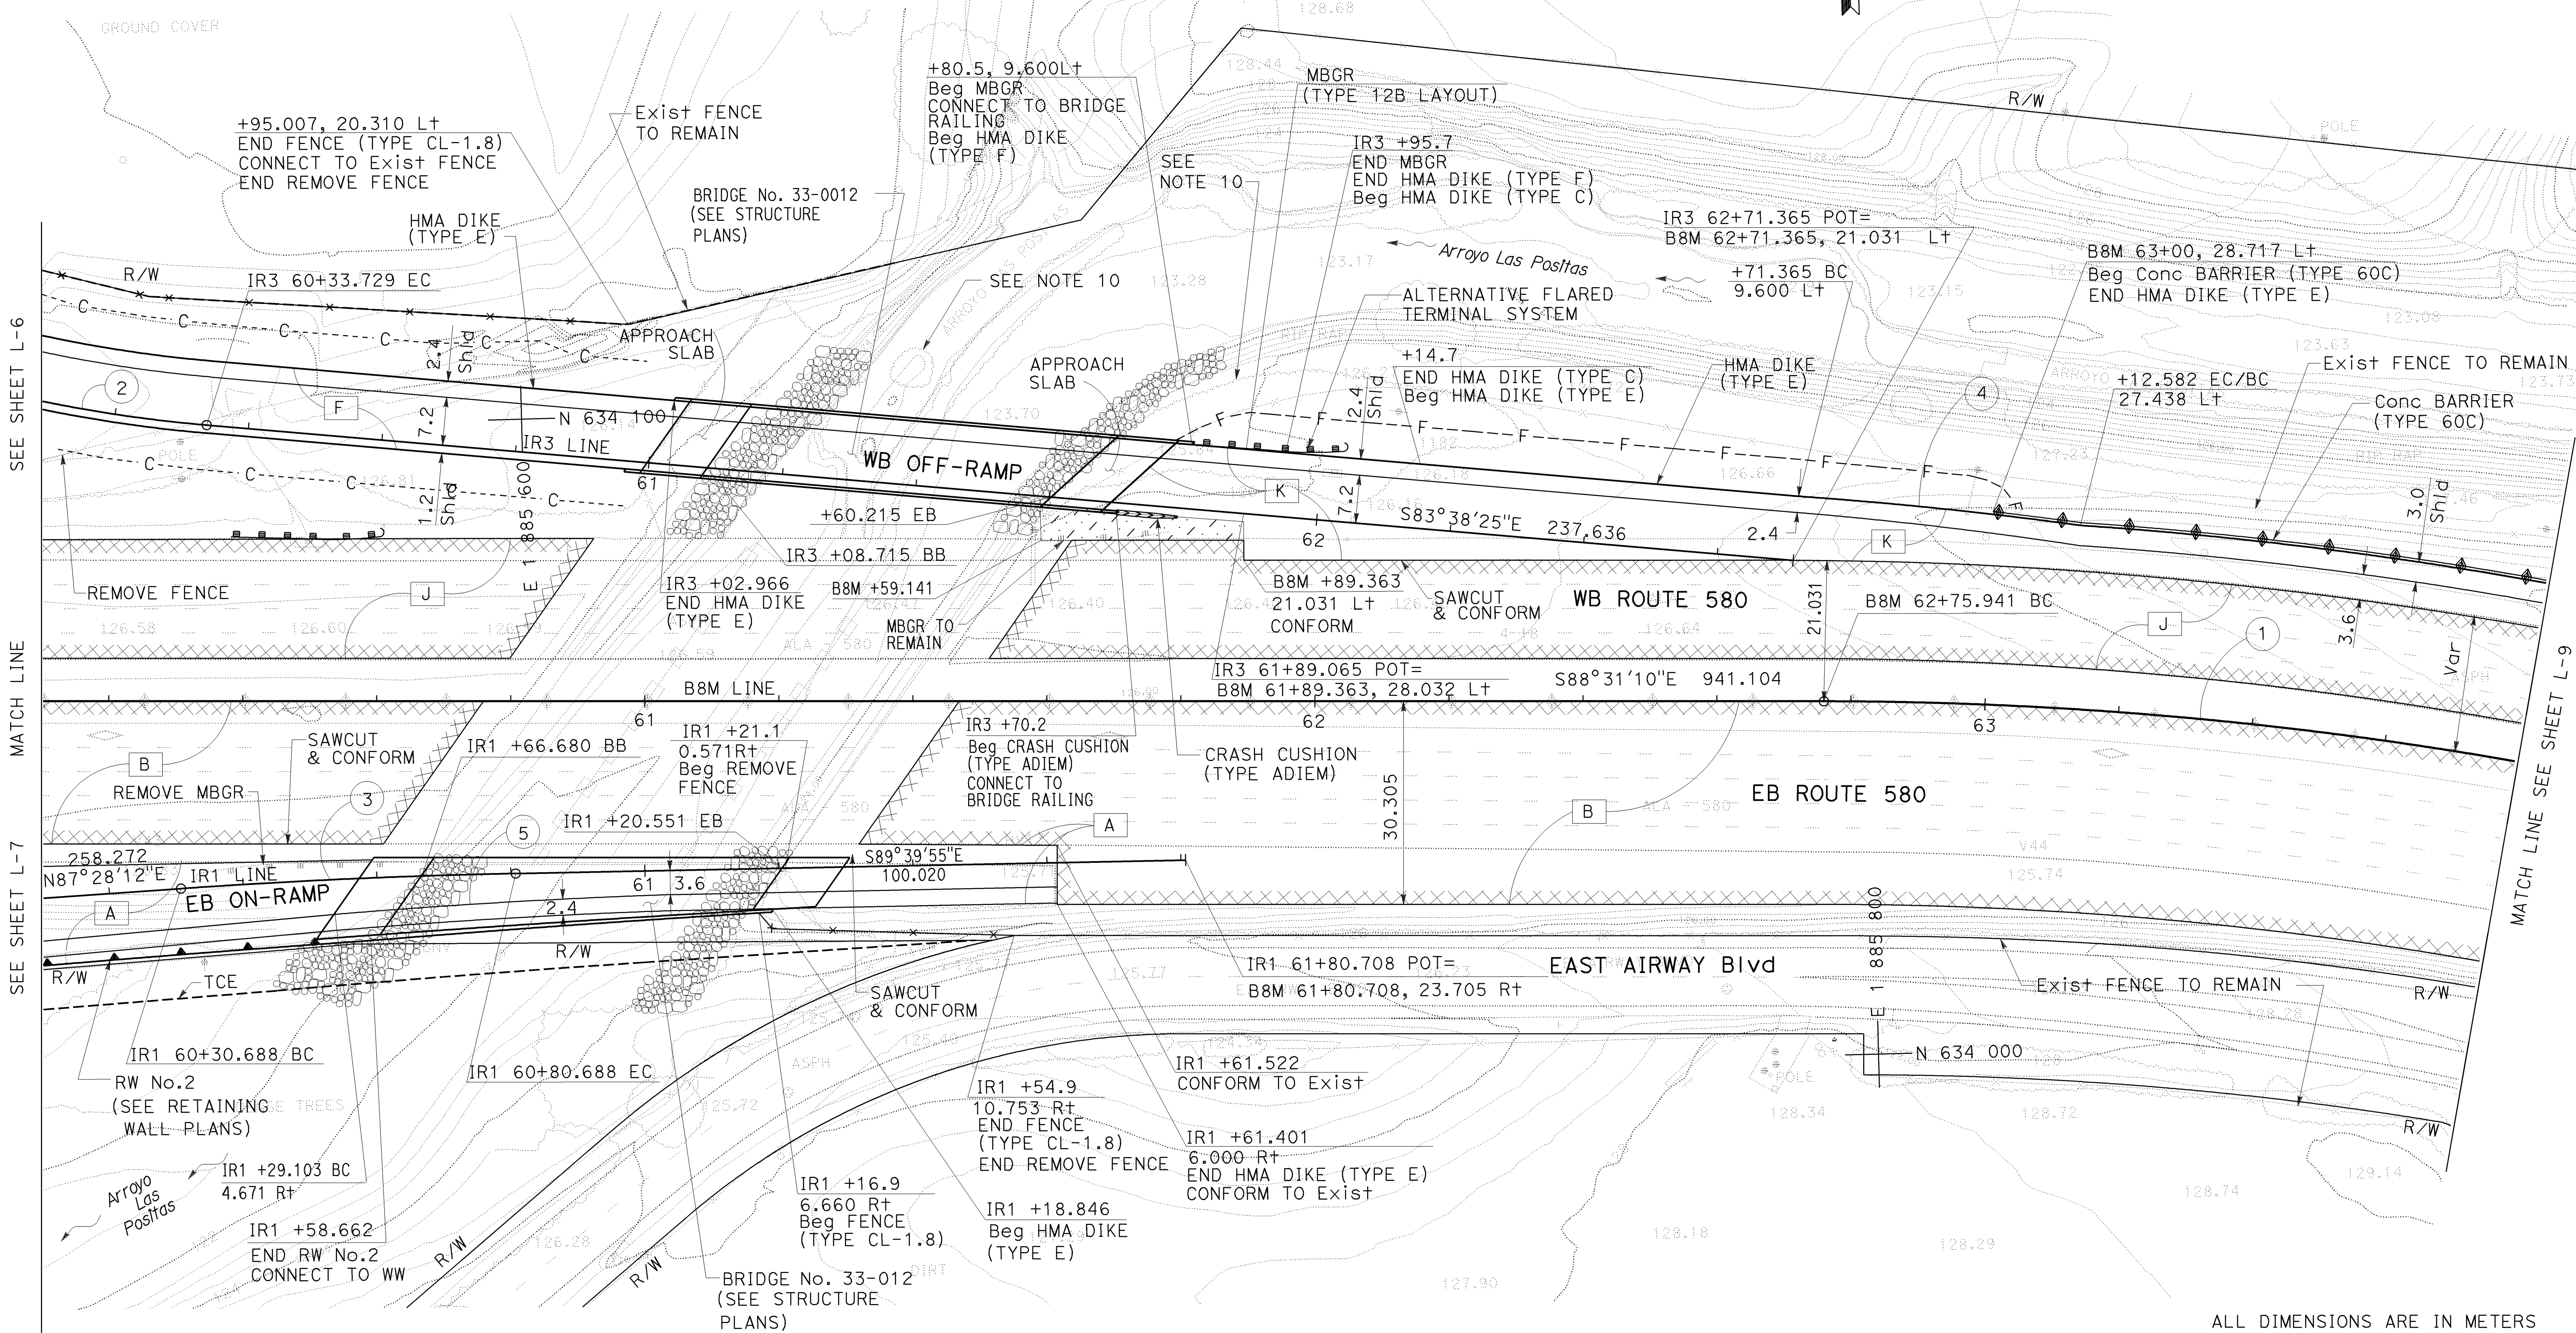

FOR NOTES, ABBREVIATIONS  
AND/OR LEGEND, SEE SHEET L-1

ALL DIMENSIONS ARE IN METERS  
UNLESS OTHERWISE SHOWN  
**LAYOUT**  
SCALE 1:500









Revisions made to this Log of Test Borings from the original 1970 Log of Test Borings are the addition of the following table and notes:

Boring	Station	Offset from "B8M" Line
B-1	60+71	15.9m± Lt.
B-3	60+69	18.3m± Rt.
B-4	59+28	15.2m± Lt.
B-5	60+08	15.9m± Rt.

- Notes:
- See the General Plan and/or Foundation Plan for Metric Stationing.
  - The data are the metric locations for the As-Built Test Borings referenced to the proposed new structure location. This table is presented on the As-Built Log of Test Boring sheet for the convenience of any bidder, contractor or other interested party.

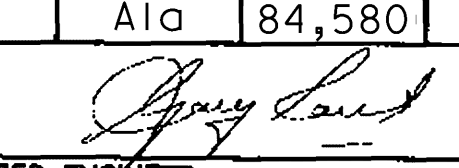
DIVISION OF ENGINEERING SERVICES - GEOTECHNICAL SERVICES					
As-Built Log of Test Borings sheet is considered an informational document only. As such, the State of California registration seal with signature, license number and registration certificate expiration date confirm that this is a true and accurate copy of the original document. This drawing is available and presented only for the convenience of any bidder, contractor or other interested party.					
DIST.	COUNTY	ROUTE	KILOMETER POST-TOTAL PROJECT	Sheet No.	Total Sheets
04	Ala	84,580	46.4/47.2,21.0/24.0	420	477
				2/22/08	
CERTIFIED ENGINEER				DATE	
ARROYO LAS POSITAS BRIDGE (WIDEN)					
LOG OF TEST BORINGS 3 OF 3					
NOTE: A COPY OF THIS LOG OF TEST BORINGS IS AVAILABLE AT OFFICE OF STRUCTURE MAINTENANCE AND INVESTIGATIONS, SACRAMENTO, CALIFORNIA				CU: 04257 EA: 171331	BRIDGE No. 33-0012
				Sheet 14	of 14

To accompany plans dated 7-28-08

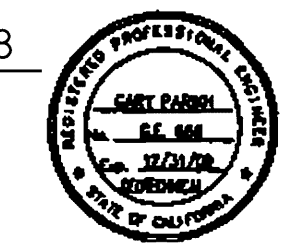

B8M 60+24 (Isabel Avenue/Route 580 Interchange Project control line station in metric) = B8 78+63.0 (As-built station in English)

**BM "B"**  
CHC disc 4" W of E  
and of S curb of  
Br. No. 33-12 L  
Elev. 413.25

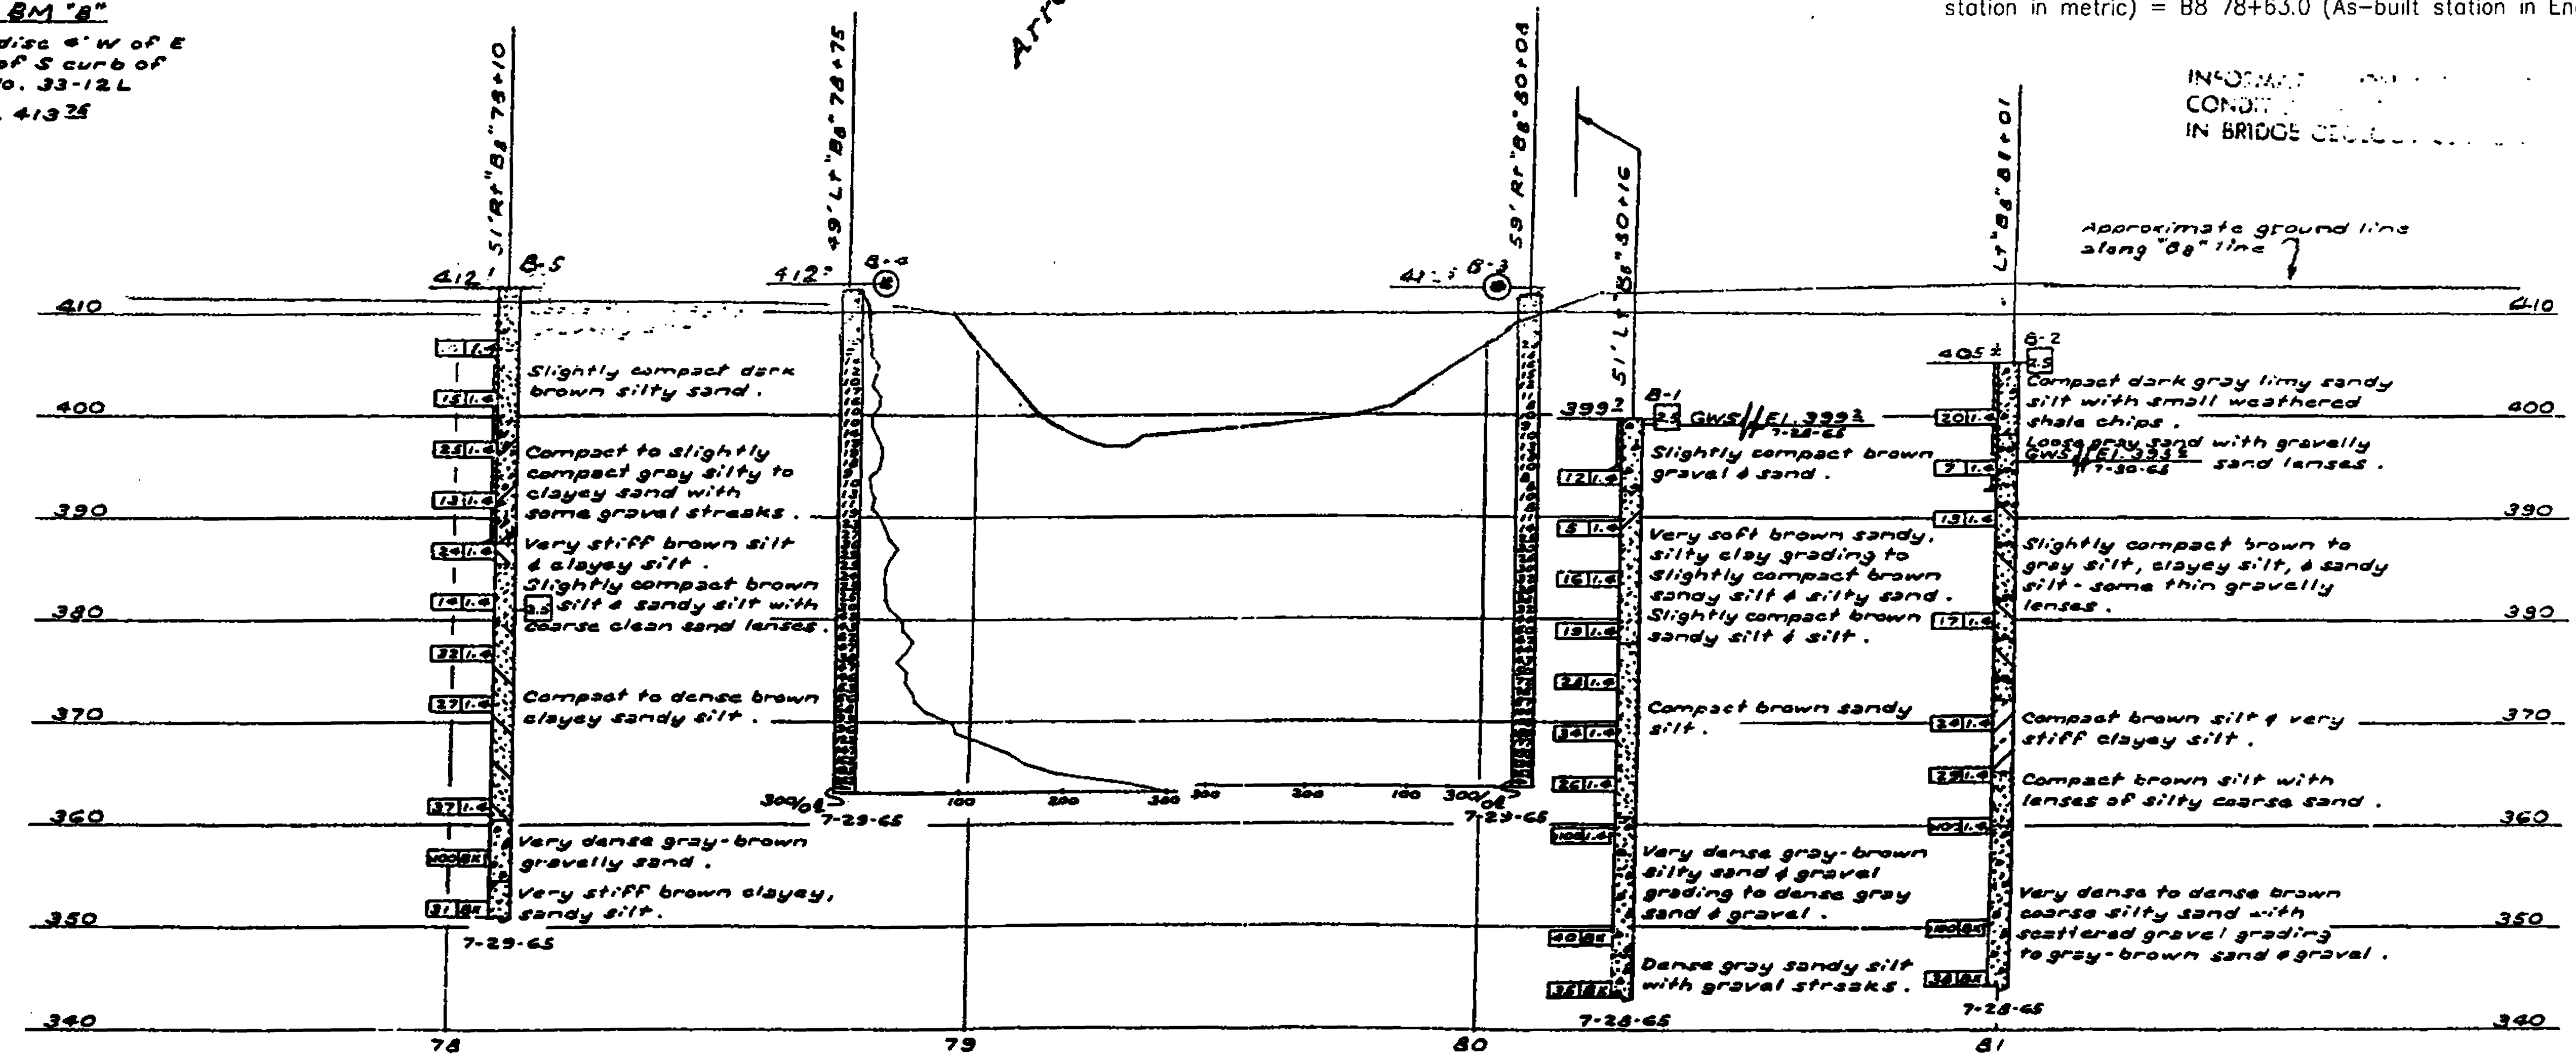


**PROFILE**  
Vert. 1"=10'  
Horiz. 1"=20'

**AS BUILT PLANS**  
Contract No. 04-136444  
Date Completed 9-25-72  
Document No. 6229

STATE OF CALIFORNIA DEPARTMENT OF PUBLIC WORKS DIVISION OF HIGHWAYS			
ARROYO LAS POSITAS BRIDGE			
LOG OF TEST BORINGS			
SCALE AS NOTED	BRIDGE 33-12	FILE	3312-B DRAWING
PREL. DRAWING NO. PR-3312-		10 10	

04204  
136441

Storage print bearing number

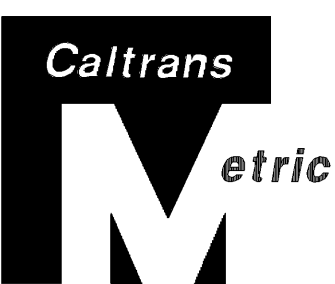


DIST	COUNTY	ROUTE	KILOMETER POST TOTAL PROJECT	SHEET No	TOTAL SHEETS
04	Ala	84,580	46.4/47.2, 21.0/24.0	423	477

**P.K. Chen**  
REGISTERED STRUCTURAL ENGINEER  
3-4-08  
7-28-08  
PLANS APPROVAL DATE

REGISTERED PROFESSIONAL ENGINEER  
PO-KANG CHEN  
No. S3112  
Exp. 9/30/09  
STRUCTURAL  
STATE OF CALIFORNIA

The State of California or its officers or agents shall not be responsible for the accuracy or completeness of electronic copies of this plan sheet.

CITY OF LIVERMORE  
3589 PACIFIC AVENUE  
LIVERMORE, CA 94550  
MARK THOMAS & COMPANY, INC.  
1960 ZANKER RD  
SAN JOSE, CA 95112

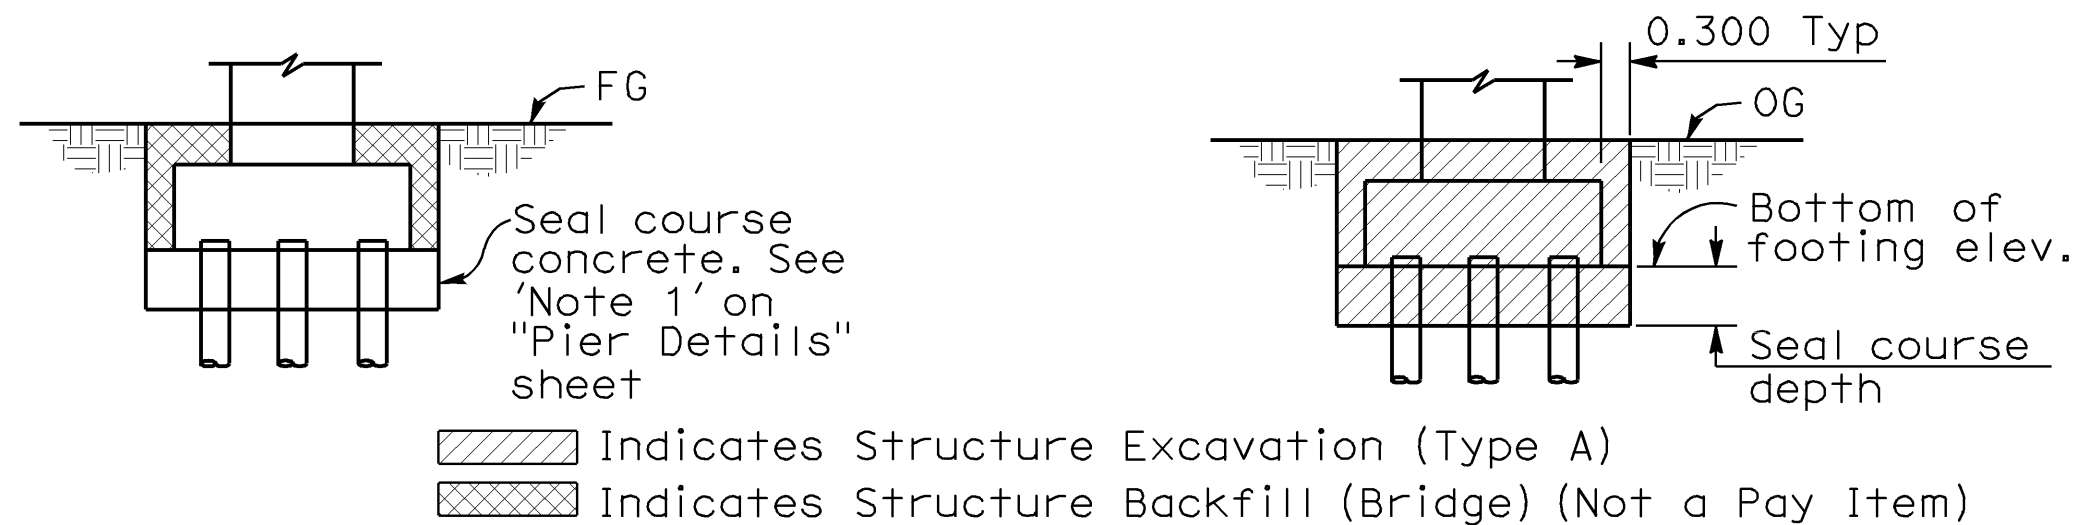


### BACKFILL AT PIERS

No scale

### EXCAVATION AT PIERS

No scale

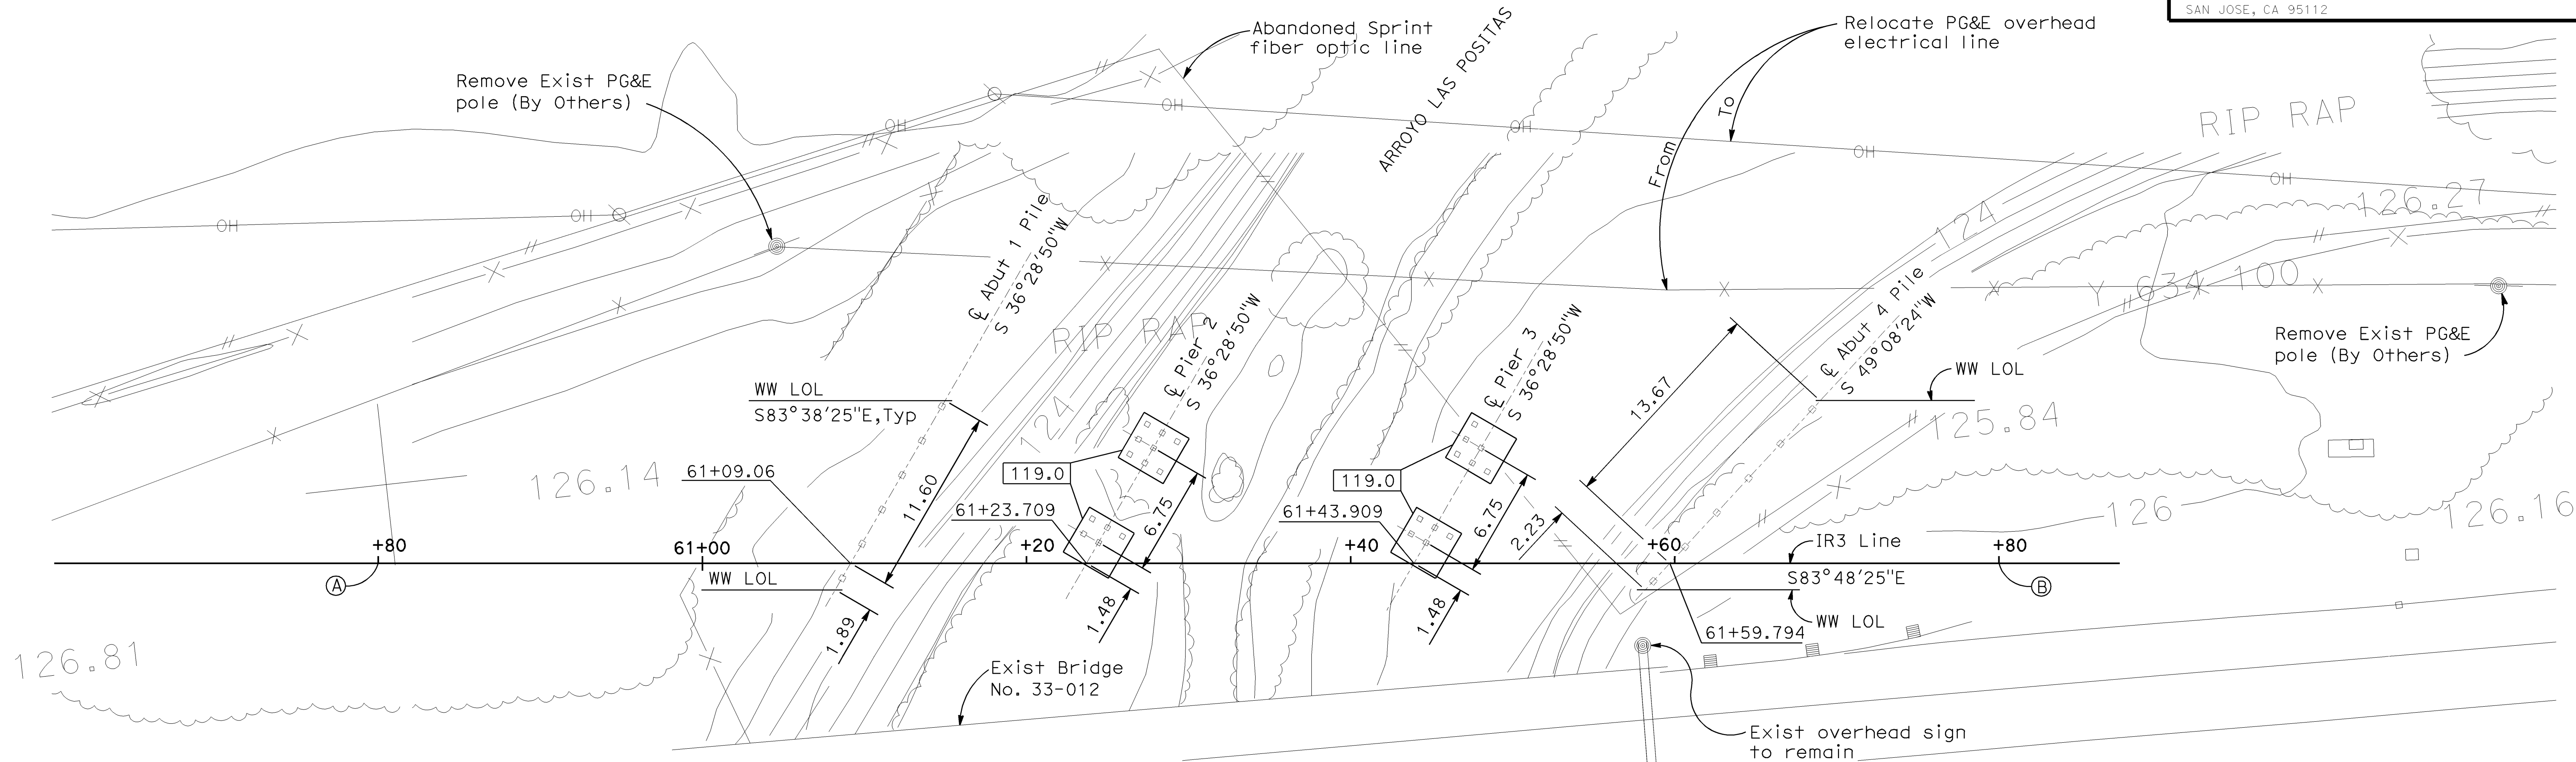

PLAN  
1:200

### BENCH MARKS

#### BENCHMARK NO. 1

Set nail and shiner on the Northerly side of West Bound Highway 580.  
Northing: 634081.3472  
Easting: 1885617.9549  
Elevation: 126.34 meters

#### BENCHMARK NO. 2

Aerial Panel HV-13, nail and shiner on the Southerly side of East Bound Highway 580  
Northing: 634032.7565  
Easting: 1885673.4027  
Elevation: 125.71 meters

### LEGEND

- Indicates bottom of footing elevation
- Indicates pile (not all piles shown)
- 126.61 Indicates spot elevation

Utilities shown are for reference only. For all above ground and underground utilities, see "Utility Plans".

### "IR3" LINE ALIGNMENT DATA

	North	East
① 60+80.00	1885598.967	634095.220
② 61+80.00	1885698.351	634084.143

### DATUM

North American Vertical Datum 1929 (NAD 83)

### HYDROLOGIC SUMMARY

Drainage area: 180 square kilometers

	DESIGN FLOOD	BASE FLOOD
Frequency (Years)	50	100
Discharge (Cubic Meters per Second)	212.40	254.58
Water Surface (Elevation at Bridge), m	124.23	124.43

Flood Plain Data are based upon information available when the plans were prepared and are shown to meet Federal requirements. The accuracy of said information is not warranted by the State and interested or affected parties should make their own investigation.

ALL DIMENSIONS AND ELEVATIONS ARE SHOWN IN METERS, EXCEPT AS NOTED

DESIGN OVERSIGHT  
3-14-08  
SIGN OFF DATE

SCALE:  
PHOTOGRAMMETRY AS OF:  
SURVEYED BY MTCO  
FIELD CHECKED BY MTCO

VERT. DATUM  
ALIGNMENT TIES  
DRAFTED BY  
CHECKED BY

HORZ. DATUM  
DESIGN BY T. WALKER  
DETAILS BY R. DAVIS  
QUANTITIES BY T. WALKER

DESIGN CHECKED BY P. CHEN  
CHECKED BY T. WALKER  
CHECKED BY R. DAVIS

PREPARED FOR THE  
STATE OF CALIFORNIA  
DEPARTMENT OF TRANSPORTATION

PO-KANG CHEN  
PROJECT ENGINEER

BRIDGE NO.  
33-0012S  
KILOMETER POST  
22.2

ARROYO LAS POSITAS BRIDGE  
FOUNDATION PLAN

FOUNDATION PLAN SHEET (METRIC) (REV. 10/27/05)

ORIGINAL SCALE IN MILLIMETERS FOR REDUCED PLANS  
0 10 20 30 40 50 60 70 80 90 100

CU 04257  
EA 171331

DISREGARD PRINTS BEARING EARLIER REVISION DATES  
4/25/06 5/31/07 10/17/07 1/28/08 3/4/08

REVISION DATES (PRELIMINARY STAGE ONLY)  
SHEET 3 OF 11



# **APPENDIX B**

## **Shea Homes Geotechnical Report**



SUPPLEMENTAL GEOTECHNICAL INVESTIGATION  
SAGE RESIDENTIAL PROJECT - TRACT 8121  
PORTOLA AVENUE  
LIVERMORE, CALIFORNIA

FOR  
SHEA HOMES  
April 1, 2013

Job No. 3498.100

BERLOGAR STEVENS & ASSOCIATES

Via E-mail and Mail

April 1, 2013  
Job No. 3498.100

BERLOGAR  
STEVENS &  
ASSOCIATES

Mr. David Best  
Shea Homes  
2580 Shea Center Drive  
Livermore, California 94551

Subject: Supplemental Geotechnical Investigation  
Sage Residential Project- Tract 8121  
Portola Avenue  
Livermore, California

Dear Mr. Best:

INTRODUCTION

Berlogar Stevens & Associates (BSA) has completed a supplemental geotechnical investigation for the Sage residential project in Livermore, California. The site is located between Portola Avenue and Highway 580, east of Isabel Drive as shown on Plate 1, Vicinity Map. A Geotechnical Investigation report has been prepared by TRC dated December 14, 2007. Our report presents the results of our investigation and provides updated recommendations for the design and construction of the subject project. Recommendations in this report are based on the following preliminary drawings provided by MacKay & Soms:

- Preliminary grading plan emailed to us on 3/4/13.
- Phase 1 Improvement Exhibit dated 2/14/13.
- Grading and Improvement Plans, Storm Drain Outfall dated February 2013.
- Gas Line Relocation, 2/21/13.
- Preliminary Earthwork (cut and fill map), 3/22/13.

The subject property is an approximately 59 acre site, of which approximately 37-acres on the east side will contain the Sage residential project. Approximately 3.5 acres on the southwest corner will be rezoned for a detention pond, as shown on Plate 2, Site Plan. The remainder is currently zoned commercial and has no specific uses that are yet defined. The residential component will be 2- and 3-story, multi-family residential structures. Grading for this project will involve cuts up to about 25 feet deep and fills up to 20 feet thick. The project will be graded in two or more phases, with Phase 1 (outlined on Plate 2) planned for the near future consisting of the following:

1. Sheet grading the commercial portion located along the western side of the site.
2. Constructing an approximately 10-foot deep, 300-foot square detention basin with a 15-foot wide gravel maintenance road around the perimeter. A south outfall into a tributary drainage channel will be constructed with approximately 200 feet of 24-inch diameter storm drain pipe







# EXPLORATORY BORING: EB-2

Sheet 1 of 1

DRILL RIG: MOBILE B-53

BORING TYPE: 8-INCH HOLLOW STEM AUGER

LOGGED BY: PL

START DATE: 8-18-06

FINISH DATE: 8-18-06

PROJECT NO: 1080-10G

PROJECT: SHEA CENTER II GARDEN DISTRICT

LOCATION: LIVERMORE, CA

COMPLETION DEPTH: 25.0 FT.

ELEVATION (FT)	DEPTH (FT)	SOIL LEGEND	MATERIAL DESCRIPTION AND REMARKS	SOIL TYPE	PENETRATION RESISTANCE (BLOWS/FT.)	SAMPLER	MOISTURE CONTENT (%)	DRY DENSITY (PCF)	PERCENT PASSING NO. 200 SIEVE	Undrained Shear Strength (ksf)			
										○ Pocket Penetrometer	△ Torvane	● Unconfined Compression	▲ U-U Triaxial Compression
432.0	0		SURFACE ELEVATION: 432.0 FT. (+/-)										
			LEAN CLAY WITH SAND (CL) very stiff to hard, moist, brown, moderate plasticity, fine sand, some caliche Liquid Limit = 35, Plasticity Index = 20		27	×	15	99	81				○
					54	×	19	106					
	5			CL	85/10"	×	18	110					
					39	×	19	108					
420.0			SILTY SAND (SM) medium dense, moist, brown, fine sand	SM									
418.0			SANDY LEAN CLAY (CL) very stiff, moist, brown, fine to medium sand, some caliche	CL	31	×	18	105					▲
414.5			SILTY SAND (SM) dense, moist, brown, fine sand	SM									
412.3			POORLY GRADED SAND WITH GRAVEL (SP) very dense, moist, brown, coarse sand, fine gravel	SP	78	×							
410.5			SANDY LEAN CLAY (CL) hard, moist, brown	CL	57	×	20	109					○
407.0	25		Bottom of Boring at 25 feet										
	30												

GROUND WATER OBSERVATIONS:

NO FREE GROUNDWATER ENCOUNTERED

LA CORP.GDT 10/29/07 SR\*



EB-2  
1080-10G

# EXPLORATORY BORING: EB-4

Sheet 1 of 1

DRILL RIG: MOBILE B-53

BORING TYPE: 8-INCH HOLLOW STEM AUGER

LOGGED BY: PL

START DATE: 8-18-06

FINISH DATE: 8-18-06

PROJECT NO: 1080-10G

PROJECT: SHEA CENTER II GARDEN DISTRICT

LOCATION: LIVERMORE, CA

COMPLETION DEPTH: 20.0 FT.

ELEVATION (FT)	DEPTH (FT)	SOIL LEGEND	MATERIAL DESCRIPTION AND REMARKS	SOIL TYPE	PENETRATION RESISTANCE (BLOWS/FT.)	SAMPLER	MOISTURE CONTENT (%)	DRY DENSITY (PCF)	PERCENT PASSING NO. 200 SIEVE	Undrained Shear Strength (ksf)			
										○ Pocket Penetrometer	△ Torvane	● Unconfined Compression	▲ U-U Triaxial Compression
436.0	0		SURFACE ELEVATION: 436.0 FT. (+/-) SANDY LEAN CLAY (CL) very stiff, moist, brown, fine sand	CL	33	✱	10	103					
432.8	3.2		SILTY SAND (SM) medium dense, moist, brown, fine to medium sand	SM	24	✱	18	106					
431.0	5.0		POORLY GRADED SAND WITH SILT (SP-SM) medium dense, moist, brown, fine to medium sand, some gravel	SP-SM	26	✱	7	105	10				
	10.0			SP-SM	53	✱	5	105	7				
422.3	13.7		SANDY LEAN CLAY (CL) very stiff, moist, brown, fine sand	CL	29	✱	14	115				▲	○
417.3	18.7		SILTY SAND WITH GRAVEL (SM) hard, moist, brown, fine to medium sand, fine gravel	SM	79	✱	12	114	15				
416.0	20.0		Bottom of Boring at 20 feet										

GROUND WATER OBSERVATIONS:

NO FREE GROUNDWATER ENCOUNTERED

LA CORP. GDT 10/29/07 SR\*



EB-4  
1080-10G



# EXPLORATORY BORING: EB-13

Sheet 1 of 1

DRILL RIG: TRACK RIG

BORING TYPE: 4-INCH SOLID STEM AUGER

LOGGED BY: PL

START DATE: 4-16-07

FINISH DATE: 4-16-07

PROJECT NO: 1080-10G

PROJECT: SHEA CENTER II GARDEN DISTRICT

LOCATION: LIVERMORE, CA

COMPLETION DEPTH: 25.5 FT.

ELEVATION (FT)	DEPTH (FT)	SOIL LEGEND	MATERIAL DESCRIPTION AND REMARKS	SOIL TYPE	PENETRATION RESISTANCE (BLOWS/FT.)	SAMPLER	MOISTURE CONTENT (%)	DRY DENSITY (PCF)	PERCENT PASSING NO. 200 SIEVE	Undrained Shear Strength (ksf)			
										○ Pocket Penetrometer	△ Torvane	● Unconfined Compression	▲ U-U Triaxial Compression
432.5	0		SURFACE ELEVATION: 432.5 FT. (+/-)										
			LEAN CLAY (CL) stiff, moist, dark brown	CL	37	16	105						
427.5	5		LEAN CLAY (CL) very stiff to hard, moist, gray brown with white streaks, some fine sand, some caliche		76/11"	12	105						
	10		increase sand		53/6"	10	97						
	15			CL	53/6"	17	105						
	20				54/6"	17	110						
					54/6"								
408.8	25		SILTY SAND (SM) dense, moist, light brown, fine sand	SM	85	14	100						
407.3 407.0			LEAN CLAY (CL) very stiff, moist, gray brown with white streaks Bottom of Boring at 25.5 feet	CL	51/6"	15	112						

LA CORP.GDT 10/29/07 SR\*

GROUND WATER OBSERVATIONS:

NO FREE GROUNDWATER ENCOUNTERED



EB-13  
1080-10G

# EXPLORATORY BORING: EB-14

Sheet 1 of 1

DRILL RIG: TRACK RIG

BORING TYPE: 4-INCH SOLID STEM AUGER

LOGGED BY: PL

START DATE: 4-16-07

FINISH DATE: 4-16-07

PROJECT NO: 1080-10G

PROJECT: SHEA CENTER II GARDEN DISTRICT

LOCATION: LIVERMORE, CA

COMPLETION DEPTH: 19.0 FT.

ELEVATION (FT)	DEPTH (FT)	SOIL LEGEND	MATERIAL DESCRIPTION AND REMARKS	SOIL TYPE	PENETRATION RESISTANCE (BLOWS/FT.)	SAMPLER	MOISTURE CONTENT (%)	DRY DENSITY (PCF)	PERCENT PASSING NO. 200 SIEVE	Undrained Shear Strength (ksf)			
										1.0	2.0	3.0	4.0
425.0	0		<b>SURFACE ELEVATION: 425.0 FT. (+/-)</b>										
			<b>LEAN CLAY WITH SAND (CL)</b> stiff to very stiff, moist, dark brown, medium to coarse sand	CL	44	X	12	105					
420.0	5		<b>SILTY CLAY (CL)</b> very stiff to hard, moist, gray brown with white streaks, some caliche		89/9.5"	X	15	105					
	10		some fine sand	CL	53/6"	X	13	100					
	15		Liquid Limit = 45, Plasticity Index = 28		54/6"	X	18	97					
			trace coarse sand		76	X	14	108					
406.0					89	X	17	104					
	20		Bottom of Boring at 19.0 feet										
	25												
	30												

GROUND WATER OBSERVATIONS:

NO FREE GROUNDWATER ENCOUNTERED

LA CORP.GDT 10/29/07 SR\*



BB-14  
1080-10G