

---

## **APPENDIX J**

# **PRELIMINARY DRAINAGE REPORT**



**This page intentionally left blank**

## Technical Memorandum



---

Date: **December 10, 2019**  
Author: **James Enriquez, P.E.**  
Subject: **Yorba Linda Boulevard Widening Project  
Preliminary Drainage Report**

---

### Project

The proposed project is located on the east side of the City of Yorba Linda on the border with Anaheim Hills. The project consists of roadway widening improvements at select locations along Yorba Linda Boulevard between La Palma Avenue and Santa Ana Canyon Road in order to provide additional carrying capacity and alleviate traffic congestion. This section of Yorba Linda Boulevard is a heavily used corridor, includes an interchange with State Route 91 (SR-91) and provides the primary ingress/egress for the Savi Ranch retail center.

The purpose of this technical memorandum is to evaluate the effects of the roadway widening on existing drainage systems and provide preliminary recommendations for drainage improvements to mitigate any adverse effects. This memorandum also provides preliminary recommendations for storm water quality improvements that will be finalized in a project-specific Water Quality Management Plan (WQMP) prepared during the final design of the project.

### Description

The project area is tributary to two existing storm drain systems; one owned and operated by the City of Anaheim and the other by Caltrans as shown in the Hydrology Map in Attachment 2 and described below:

- **Drainage Areas A and B:** The majority of the project area, Drainage Areas A and B, are tributary to a 60-inch RCP storm drain located in Pullman Avenue that is owned and operated by the City of Anaheim. The as-built plans for this storm drain system, including laterals, are included in Attachment 4 and include City of Anaheim Plan Nos. 14761 through 14773. Areas A and B drain to two existing catch basins located on Savi Ranch Parkway east of Pullman Avenue connected to Lines D-5 and D-6 of the system (Plan Nos. 14767 and 14769).
- **Drainage Area C:** Drainage Area C is tributary to existing catch basins located on the west side of Weir Canyon Rd immediately south of the SR-91 eastbound offramp. These catch basins are part of the drainage system constructed for the SR-91/Yorba Linda Boulevard interchange.

### Calculation and Methodology

#### Hydrology

The hydrology analysis was performed in accordance with the Orange County Hydrology Manual (Published in 1986) and the Addendum No. 1 (Published in 1995). A 25-year Design Storm frequency was used because the existing storm drain system servicing the project area was designed for a 25-year Design Storm.

Hydrologic calculations were completed using the computer software HydroWIN (RATSCx 2016) Version 23.0 (Release date 07/01/2016). The software is distributed by Advanced Engineering Software (AES) at [www.advancedengineeringsoftware.com](http://www.advancedengineeringsoftware.com). The use of this software is in accordance with the Orange County Hydrology Manual. The software defines subareas and routing paths by means of node numbers with designated data relating to elevation, path of travel distances, soil group, land use type, and conveyance type. The hydrology map and accompanying data used in the computer modeling are included in Attachment 2.

## **Hydraulics**

Hydraulics calculations for the existing mainline storm drain on Pullman Street were completed using the computer software Water Surface and Pressure Gradient Hydraulic Analysis System Program (WSPGW) Version 14.08 distributed by CIVILDESIGN Corporation at [www.civildesign.com](http://www.civildesign.com). Hydraulic performance of catch basin connector pipes was checked using a Microsoft Excel spreadsheet developed by the Los Angeles County Department of Public Works for catch basins connected in series.

The size of catch basin opening was calculated using FlowMaster V8i (SELECTseries 1) distributed by Bentley Systems, Inc. at [www.bentley.com](http://www.bentley.com). This software uses FHWA HEC 22 methodology.

Hydraulic calculations are included in Attachment 3.

## **Hydrologic and Hydraulic Results & Recommendations**

### **Drainage Areas A and B**

The proposed project results in a net increase in the runoff to the existing 60-inch RCP storm drain in Pullman Avenue. Most of the increased runoff is a result of the widening of Yorba Linda Boulevard between La Palma Avenue and Savi Ranch Parkway. This area adds 0.73 acres of impervious drainage area that currently falls directly into the Santa Ana River. The 25-year runoff to the two catch basins located on Savi Ranch Parkway east of Pullman Avenue increases from 19.1 cfs<sup>1</sup> to 26.0 cfs (See Table 1). The WSPGW hydraulic calculations in Attachment 3 show that the existing storm drain pipes have adequate capacity to convey the added flow and no improvements to the conduits are recommended. The water surface in the 60-inch mainline increases by a maximum of 0.064 ft. The water surface in the connector pipes for these two catch basins, Lines D-5 and D-6 (Plan Nos. 14767 and 14769), also increases by an insignificant amount and the “V” Depth calculation sheets show that the catch basins and connector pipes have over 1 ft of reserve hydraulic head at peak flow despite an increase of 0.89 ft of required head resulting from the increased flow rate. Such a minimal impact to hydraulic performance keeps the design of the storm drain well within City and County design standards.

Table 2 shows the summary of the catch basin sizing calculations included in Attachment 3. The catch basin on the north side of Savi Ranch Parkway serves Drainage Area A. Runoff from Drainage Area A increases from 6.4 cfs to 13.36 cfs and requires replacement of the existing 6-ft wide catch basin with a 17-ft wide catch basin to maintain the existing depth and spread on the street. The catch basin on the south side of the street serves Drainage Area B. The flow from Drainage Area B decreases slightly and the 6-ft wide catch basin will remain in place.

### **Drainage Area C**

The proposed project results in an insignificant increase (0.02 cfs) in the runoff to the existing catch basins on Weir Canyon Road resulting from a slight increase in impervious area (0.09 acres). No drainage improvements are recommended at this location.

---

<sup>1</sup> 25-year Design Storm flow rate shown on City of Anaheim Plan No. 14769. Existing condition hydrology was not modeled because the plan shows the existing design capacity.

**TABLE 1: HYDROLOGY RESULTS (25-Year Design Storm)**

Drainage Area	Existing		Proposed		Notes
	Total Area (Acre)	25-year Runoff (CFS)	Total Area (Acres)	25-year Runoff (CFS)	
Area A	--	6.4	5.87	13.36	Existing condition not modeled since as-built plans show design flow rate.
Area B	--	12.7	5.23	12.64	Existing condition not modeled since as-built plans show design flow rate.
Area C	1.5	5.41	1.5	5.43	Increased flow due to negligible increase in impervious area.

**TABLE 2: CATCH BASIN SIZING RESULTS (25-Year Design Storm)**

Drainage Area	Existing		Proposed		Notes
	25-year Runoff (CFS)	Catch Basin Width (FT)	25-year Runoff (CFS)	Catch Basin Width (FT)	
Area A	6.4	6.0	13.36	17.0	
Area B	12.7	6.0	12.64	6.0	
Area C					Two existing grating catch basins to remain due to insignificant flow increase of 0.02 cfs.

## Water Quality Management Plan Recommendations

The project is located within the Santa Ana Region in the North Orange County Permit Area. The project is classified as a Priority Project per Table 7.II-2 of Section 7.II-1.2 of the Model WQMP because it consists of the construction of more than 5,000 SF of roadway surface. The project also adds 52,811 SF of impervious area (2,371 SF for S/E corner of Yorba Linda Blvd & Savi Ranch Pkwy; 3,920 SF for N/W corner of Yorba Linda Blvd & Santa Ana Cyn Rd; and 46,520 for the east side of Yorba Linda Blvd).

For public agency projects classified as Priority Projects, Section 7.II-1.5 of the Model WQMP requires implementation of United States Environmental Protection Agency (USEPA) guidance, “Managing Wet Weather with Green Infrastructure: Green Streets” Manual (Green Streets) in a manner consistent with the maximum extent practicable (MEP) standard. Table 3 lists the types of infrastructure recommended by the Green Streets Manual and the applicability to this project.

As indicated in Table 3, the width of the proposed street widening has been limited to the minimum width required to achieve the desired traffic volume capacity enhancements and pedestrian and bike improvements. Permeable pavement is not appropriate for the volume and weight of vehicular traffic traveling on these roadways. The recommended storm water treatment is a combination of landscaped planters and biofiltration vaults.

Filterra Vaults were considered but did not provide the required treatment volume due to the configuration of the drainage areas. Since the existing underground drainage systems in the area do not extend into the project area, surface drainage for the entire project area (Drainage Areas A and B) is conveyed in the street gutter to an existing system on Savi Ranch Parkway just east of Pullman Avenue. Drainage Area C is also conveyed in the gutter to existing catch basins on Weir Canyon Road just south of the eastbound SR-91

offramp. By the time runoff is caught by the underground storm drain system, the amount of accumulated runoff exceeds the treatment volume capacity of Filterra Vaults.

Therefore, Modular Wetlands System Linear vaults (manufactured by BioClean) are recommended for this project. These are larger biofiltration vaults designed for flow-based treatment with the capacity to treat larger areas. The recommended locations and approximate sizes of the vaults are shown in the Hydrology Map in Attachment 2. The product information for these vaults is included in Attachment 5.

The vaults recommended for Drainage Areas A and B are located on Savi Ranch Parkway between Pullman Avenue and Yorba Linda Boulevard. Right-of-way acquisition will be required for these vaults since the existing sidewalk is 8 feet wide and the proposed vaults are 9 feet wide. Right-of-way acquisition will also need to include additional width to provide the desired sidewalk width around the back of the planted vault. It shall also be noted that these four vaults are located within the City of Anaheim. The right-of-way to be acquired for the widening of Weir Canyon Road north of Santa Ana Canyon Road will also need to include right-of-way for the proposed vault.

The final design for the project will include the preparation of a final Water Quality Management Plan and refinement of the design of the biofiltration vaults.

**TABLE 3: GREEN STREETS INFRASTRUCTURE MATRIX**


Infrastructure Recommended in Green Streets Manual	Implementation Notes
Alternative Street Design (Street Widths)	The purpose of the project is to widen existing roadways. The amount of widening recommended is limited to the minimum width that will achieve the required volume capacity enhancements and pedestrian/bike improvements.
Bioretention Curb Extensions and Sidewalk Planters	The existing and proposed street configuration do not accommodate curb extensions. Modular Wetlands System Linear vaults are recommended within the sidewalk areas at select locations and include landscaping (See Hydrology Map in Attachment 2 for proposed locations).
Permeable Pavement	Permeable pavement is not appropriate for the volume and weight of vehicular traffic on these roadways.
Sidewalk Trees and Tree Boxes	Modular Wetlands System Linear vaults are recommended within the sidewalk areas at select locations and include landscaping (See Hydrology Map in Attachment 2 for proposed locations).

# ATTACHMENT 1

---

PROPOSED IMPROVEMENTS EXHIBITS


---

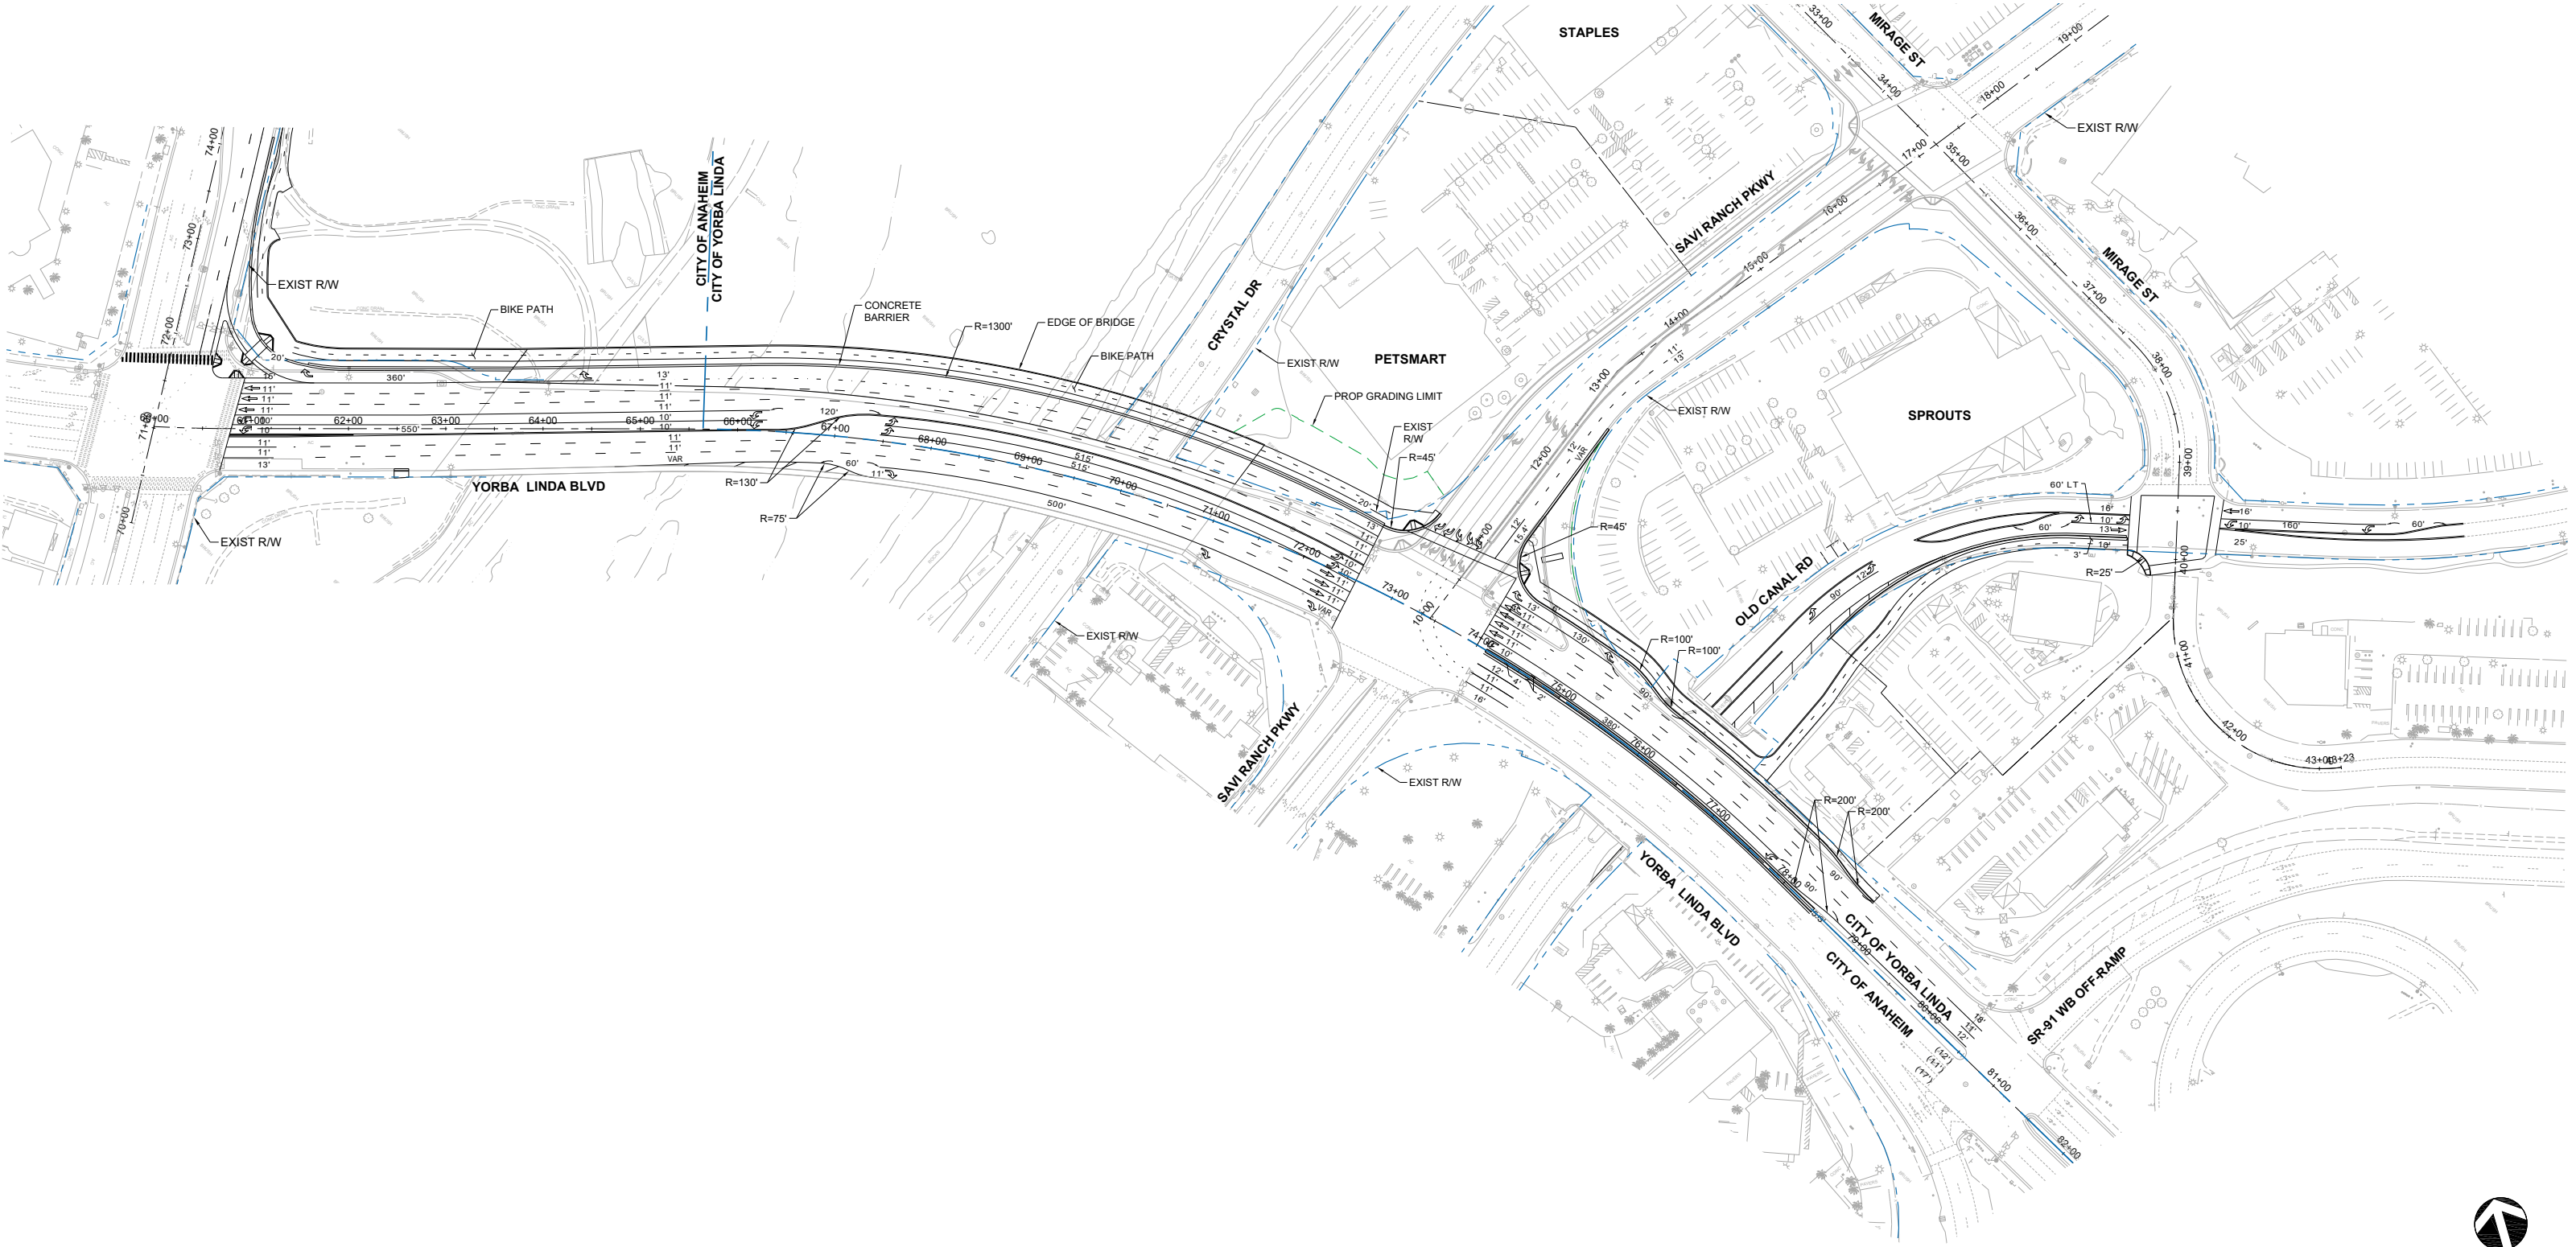


**YORBA LINDA BOULEVARD WIDENING**  
LA PALMA AVENUE TO SR-91 RAMPS






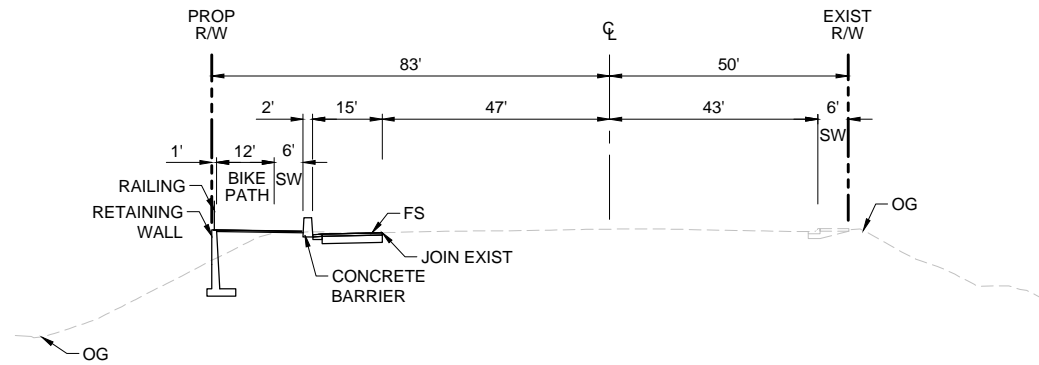


**YORBA LINDA BLVD**  
SECTION A-A

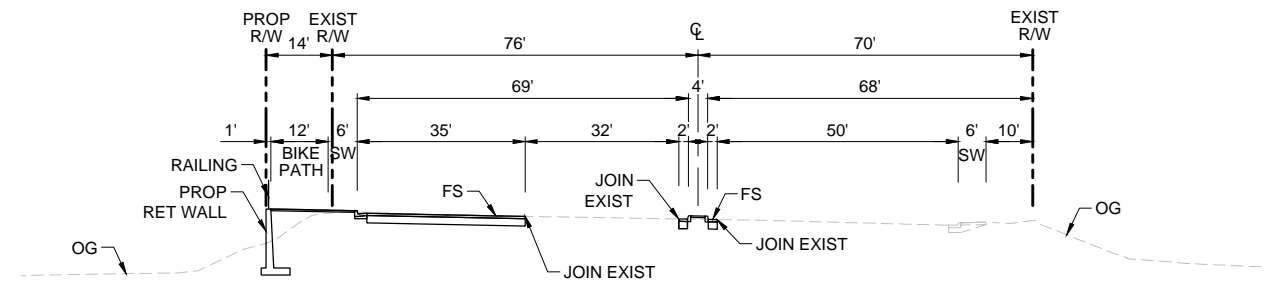


**YORBA LINDA BLVD**  
SECTION D-D

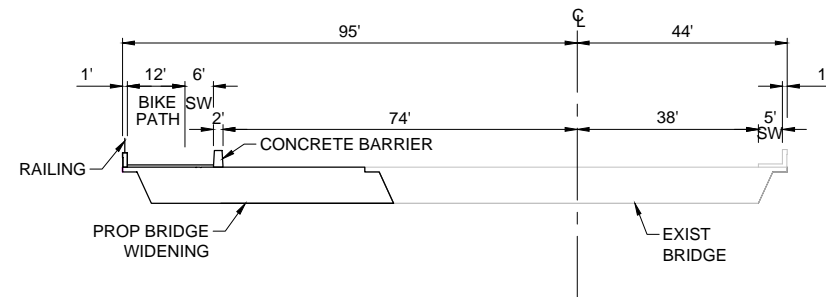


**YORBA LINDA BLVD**  
SECTION B-B

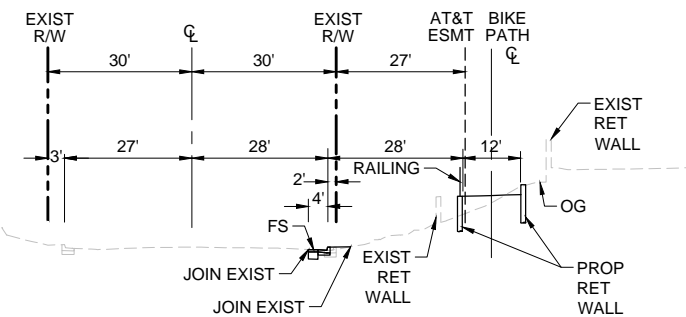


**OLD CANAL RD**  
SECTION E-E

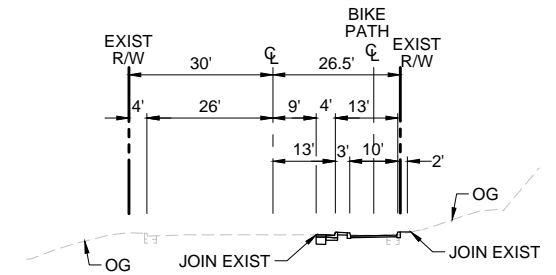

**OLD CANAL RD**  
SECTION F-F

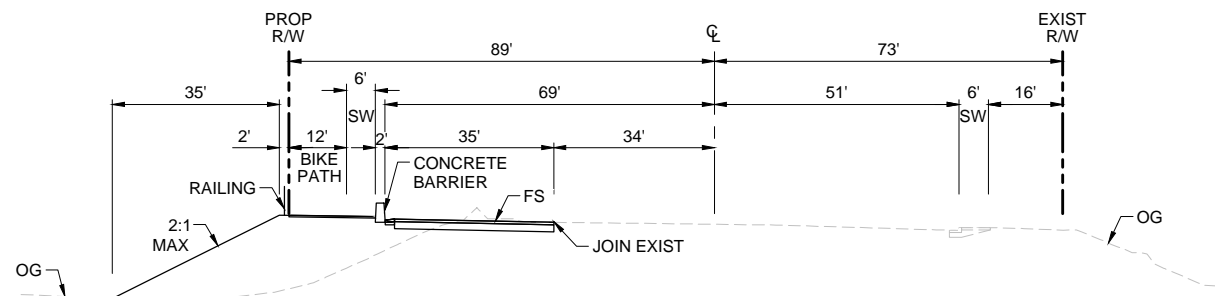

**YORBA LINDA BLVD**  
SECTION C-C

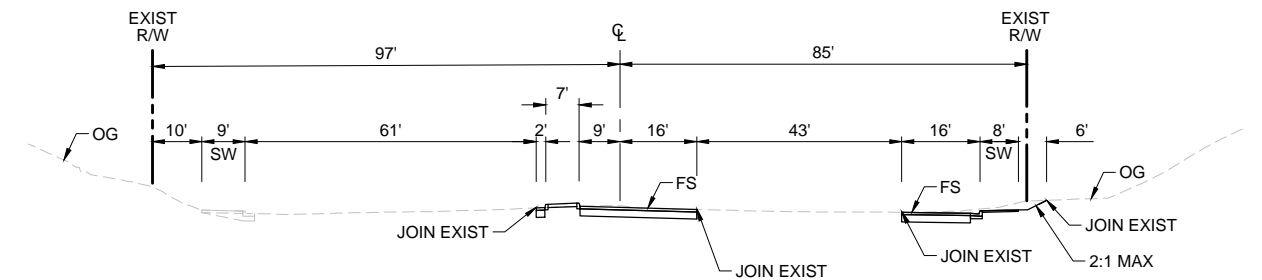

**WEIR CANYON RD**  
SECTION G-G

**PRELIMINARY ENGINEERING  
NOT FOR CONSTRUCTION**



PLANS PREPARED BY:  
**HNTB**  
200 E. SANDPOINT AVE, SUITE 200  
SANTA ANA, CA 92707  
(714) 460-1600

DESIGNED BY: DATE:  
DRAWN BY: DATE:  
CHECKED BY: DATE:

UNDER THE SUPERVISION OF:  
DAVID M. EAMES RCE # 55501 DATE:



REVISIONS					
No.	DATE	BY	DESCRIPTION	APP'D BY	DATE

BENCH MARK:

APPROVALS		
DIVISION	BY	DATE
DESIGN		
TRAFFIC		
RIGHT OF WAY		
UTILITIES		
PROJECT MANAGER		
APPROVED		
CHIEF ENGINEER	RCE #	DATE

**CITY OF YORBA LINDA AND  
CITY OF ANAHEIM  
YORBA LINDA BLVD/WEIR CANYON RD WIDENING  
CROSS SECTIONS**

DWG SHEET 11 OF XX




# ATTACHMENT 2

---

## HYDROLOGIC MAPS AND CALCULATIONS

---



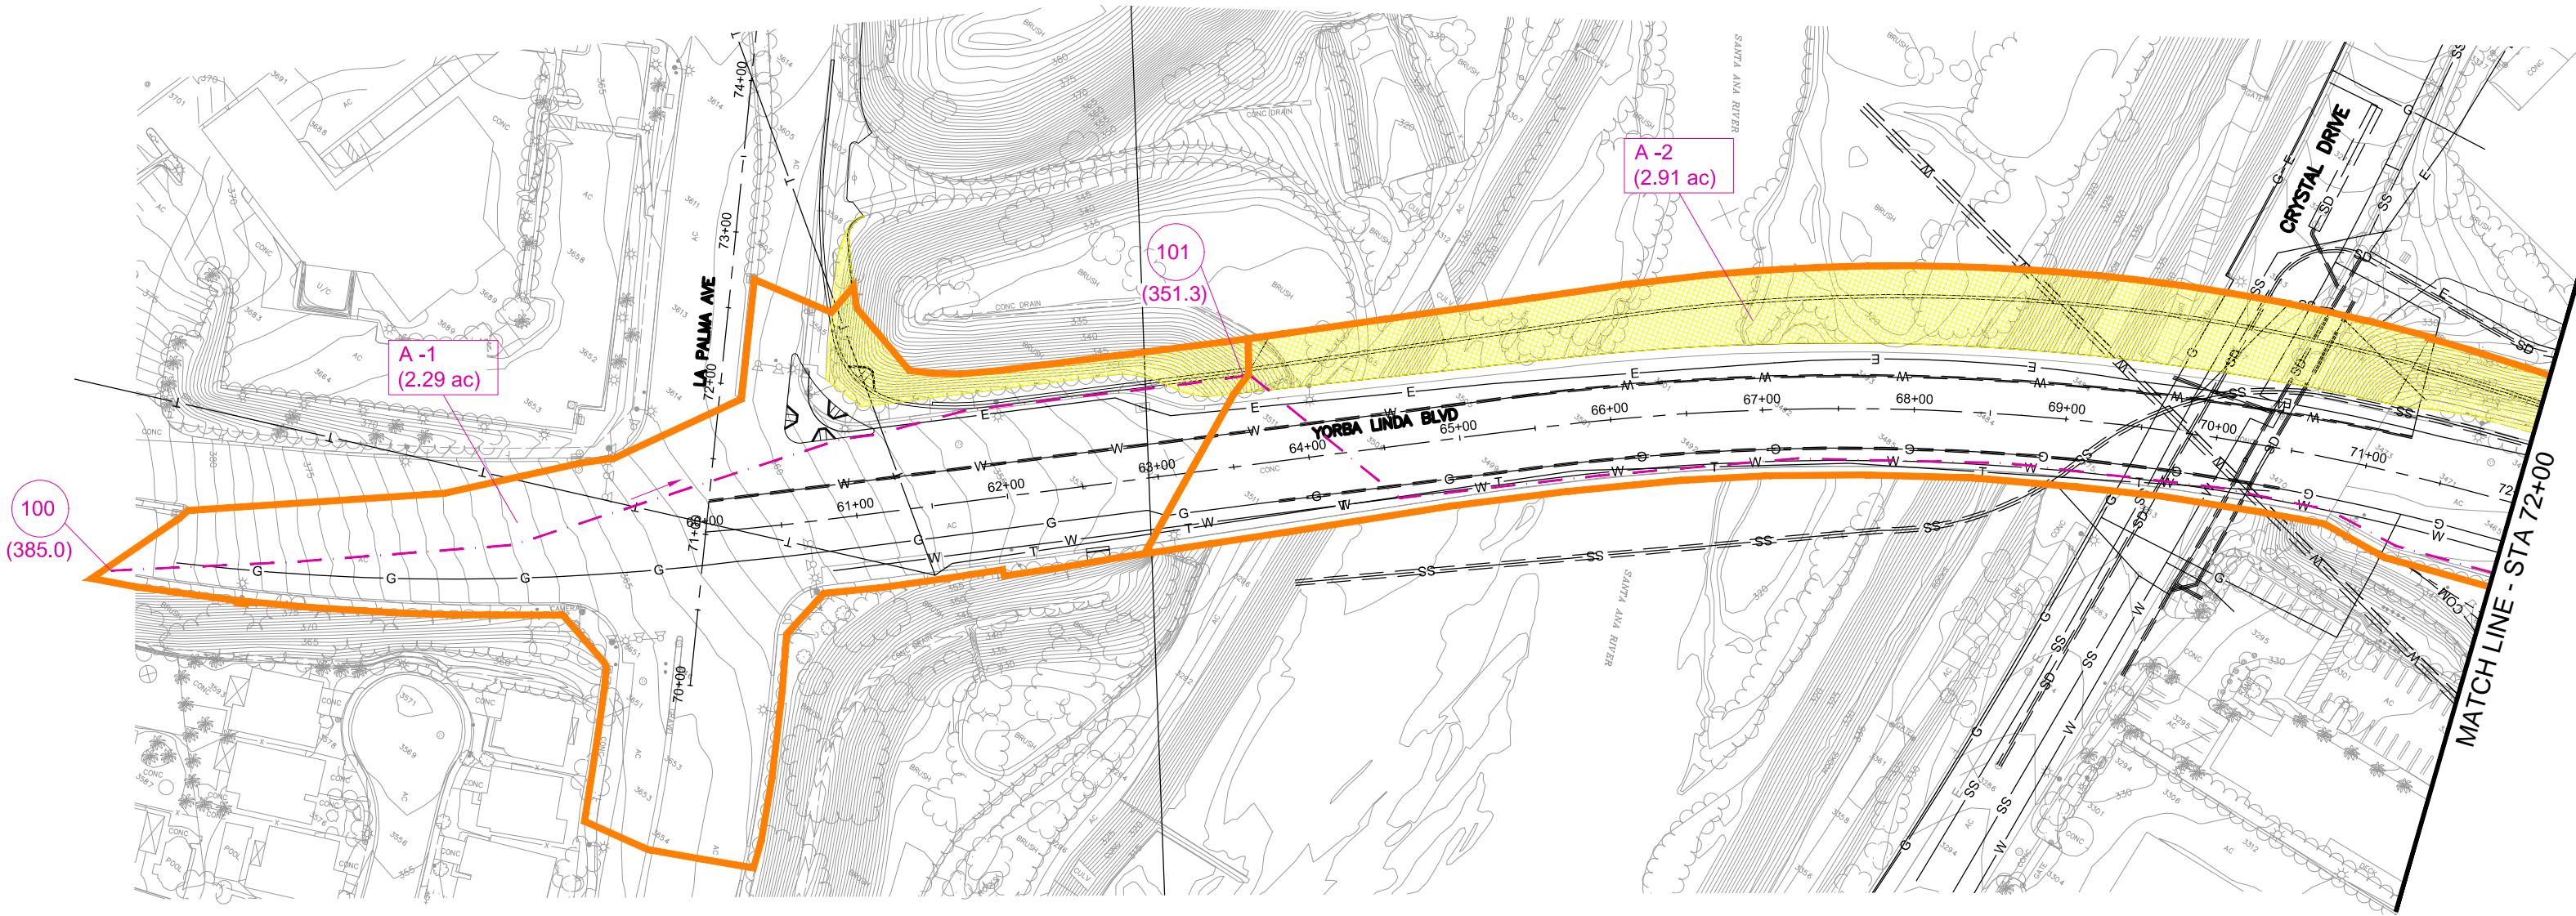

**LEGEND**


- DRAINAGE SUB-AREA BOUNDARY
- TIME OF CONCENTRATION FLOW PATH
- PROPOSED STORM DRAIN
- EXISTING STORM DRAIN
- ADDED IMPERVIOUS AREA (IMP)
- DRAINAGE SUB-AREA DESIGNATION (AREA IN ACRE)
- NODE NUMBER (ELEVATION)

**YORBA LINDA BOULEVARD/WEIR CANYON ROAD WIDENING**

HYDROLOGY MAP EXHIBIT - PROPOSED CONDITION





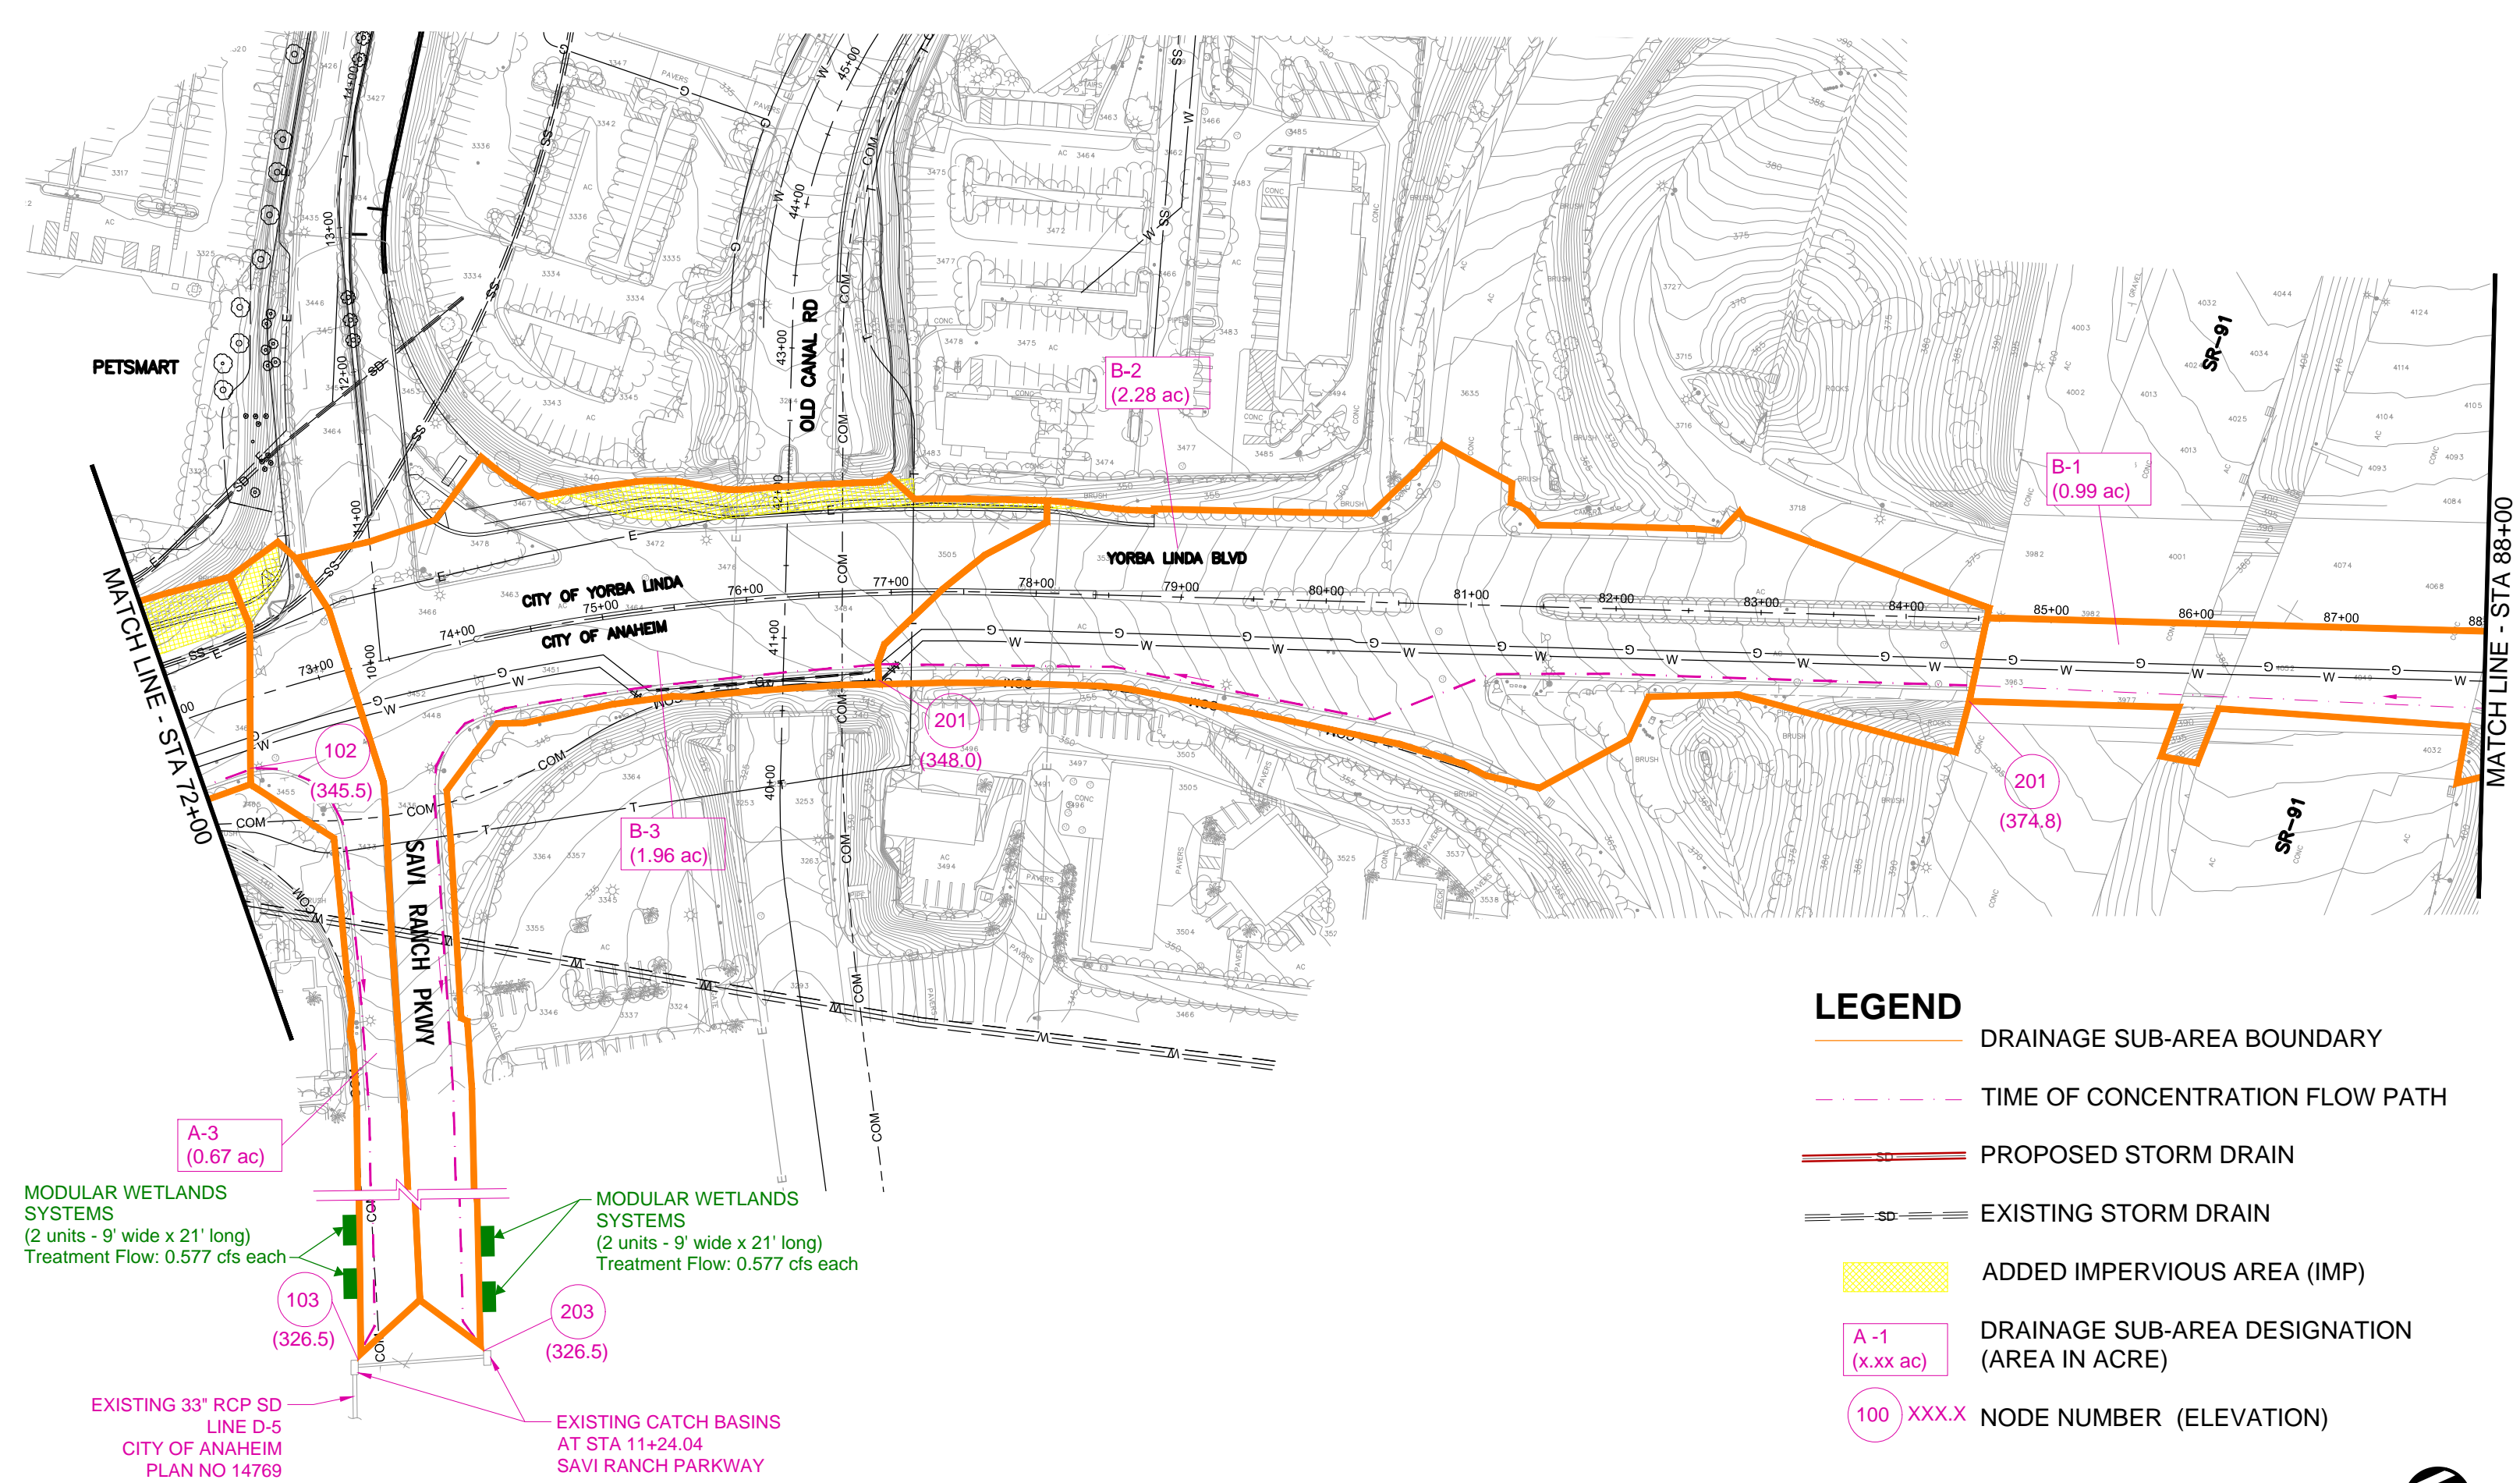

## LEGEND


- DRAINAGE SUB-AREA BOUNDARY
- TIME OF CONCENTRATION FLOW PATH
- == SD == PROPOSED STORM DRAIN
- == SD == EXISTING STORM DRAIN
- ADDED IMPERVIOUS AREA (IMP)
- A - 1  
(x.xx ac) DRAINAGE SUB-AREA DESIGNATION  
(AREA IN ACRE)
- 100 XXX.X NODE NUMBER (ELEVATION)

# YORBA LINDA BOULEVARD/WEIR CANYON ROAD WIDENING

## HYDROLOGY MAP EXHIBIT - PROPOSED CONDITION







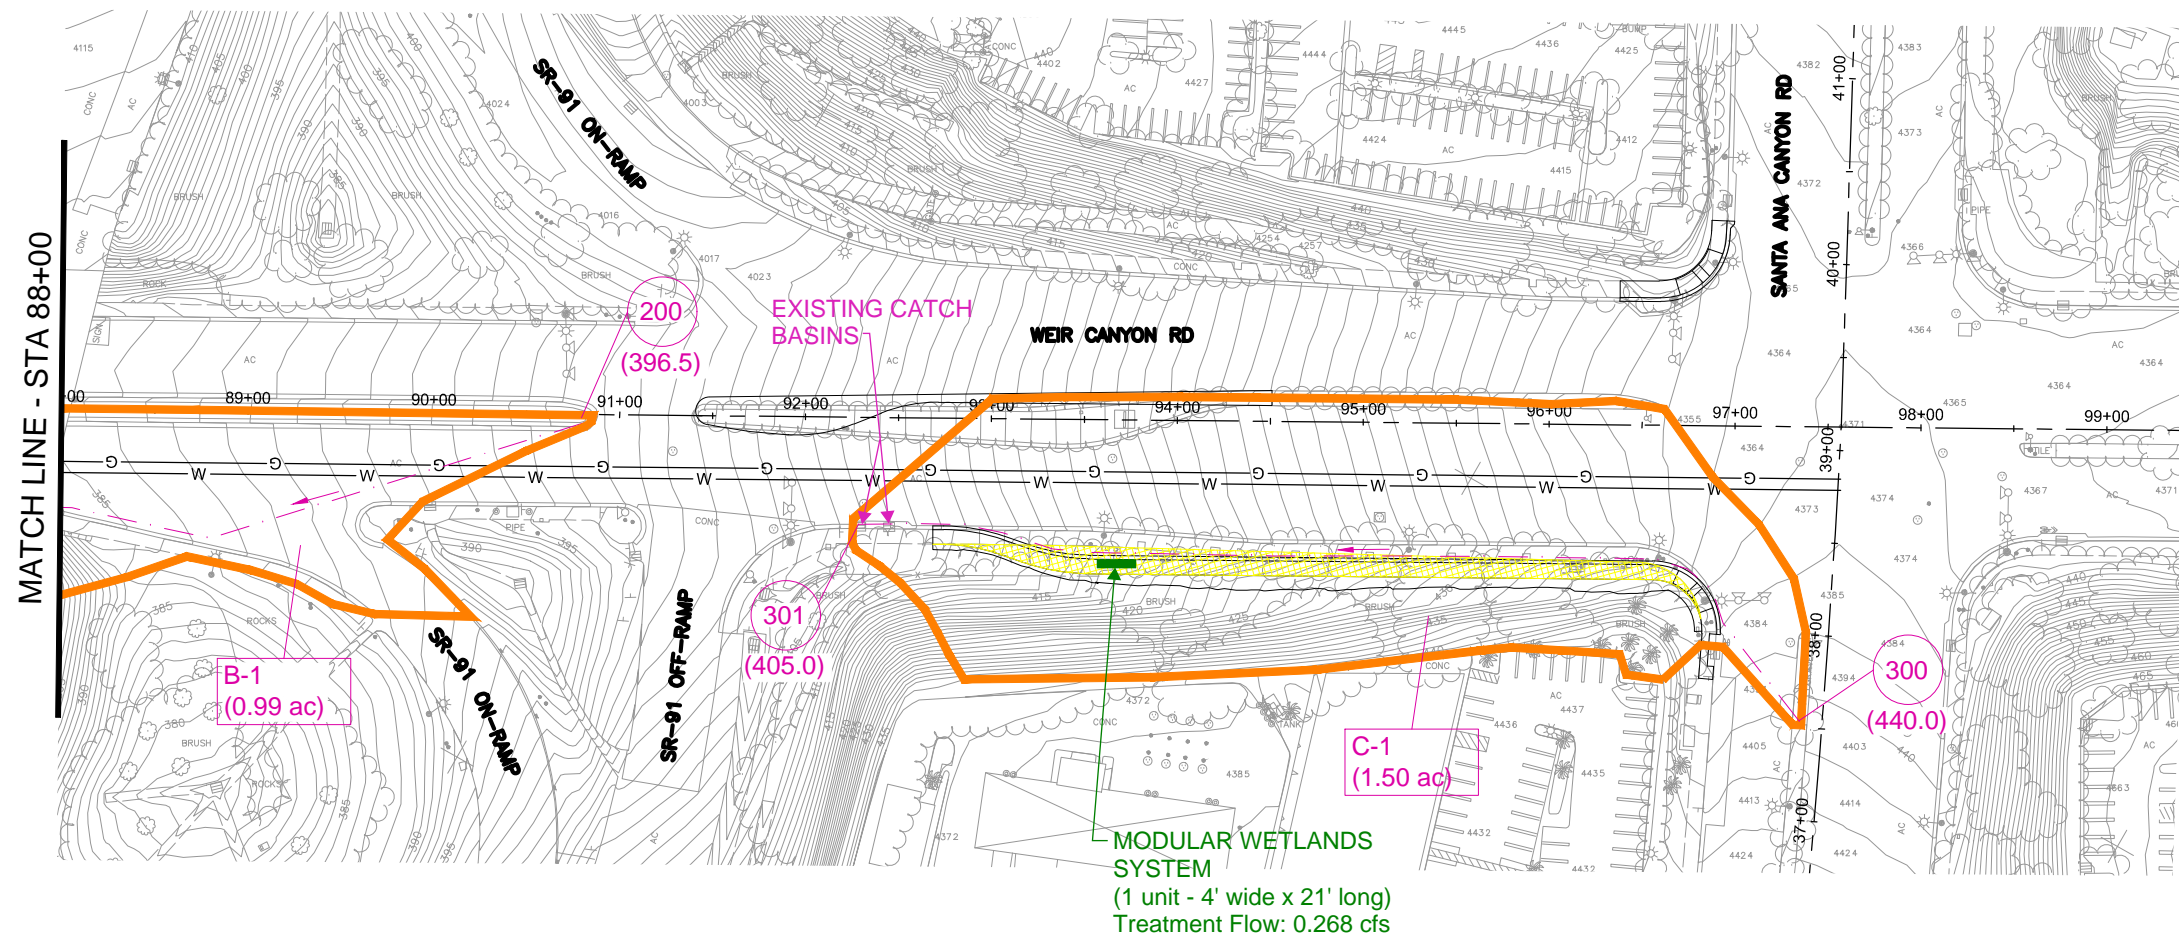


# LEGEND

- DRAINAGE SUB-AREA BOUNDARY
- - - TIME OF CONCENTRATION FLOW PATH
- = = = PROPOSED STORM DRAIN
- = = = EXISTING STORM DRAIN
- ADDED IMPERVIOUS AREA (IMP)
- A - 1  
(x.xx ac) DRAINAGE SUB-AREA DESIGNATION  
(AREA IN ACRE)
- 100 XXX.X NODE NUMBER (ELEVATION)

## YORBA LINDA BOULEVARD/WEIR CANYON ROAD WIDENING HYDROLOGY MAP EXHIBIT - PROPOSED CONDITION



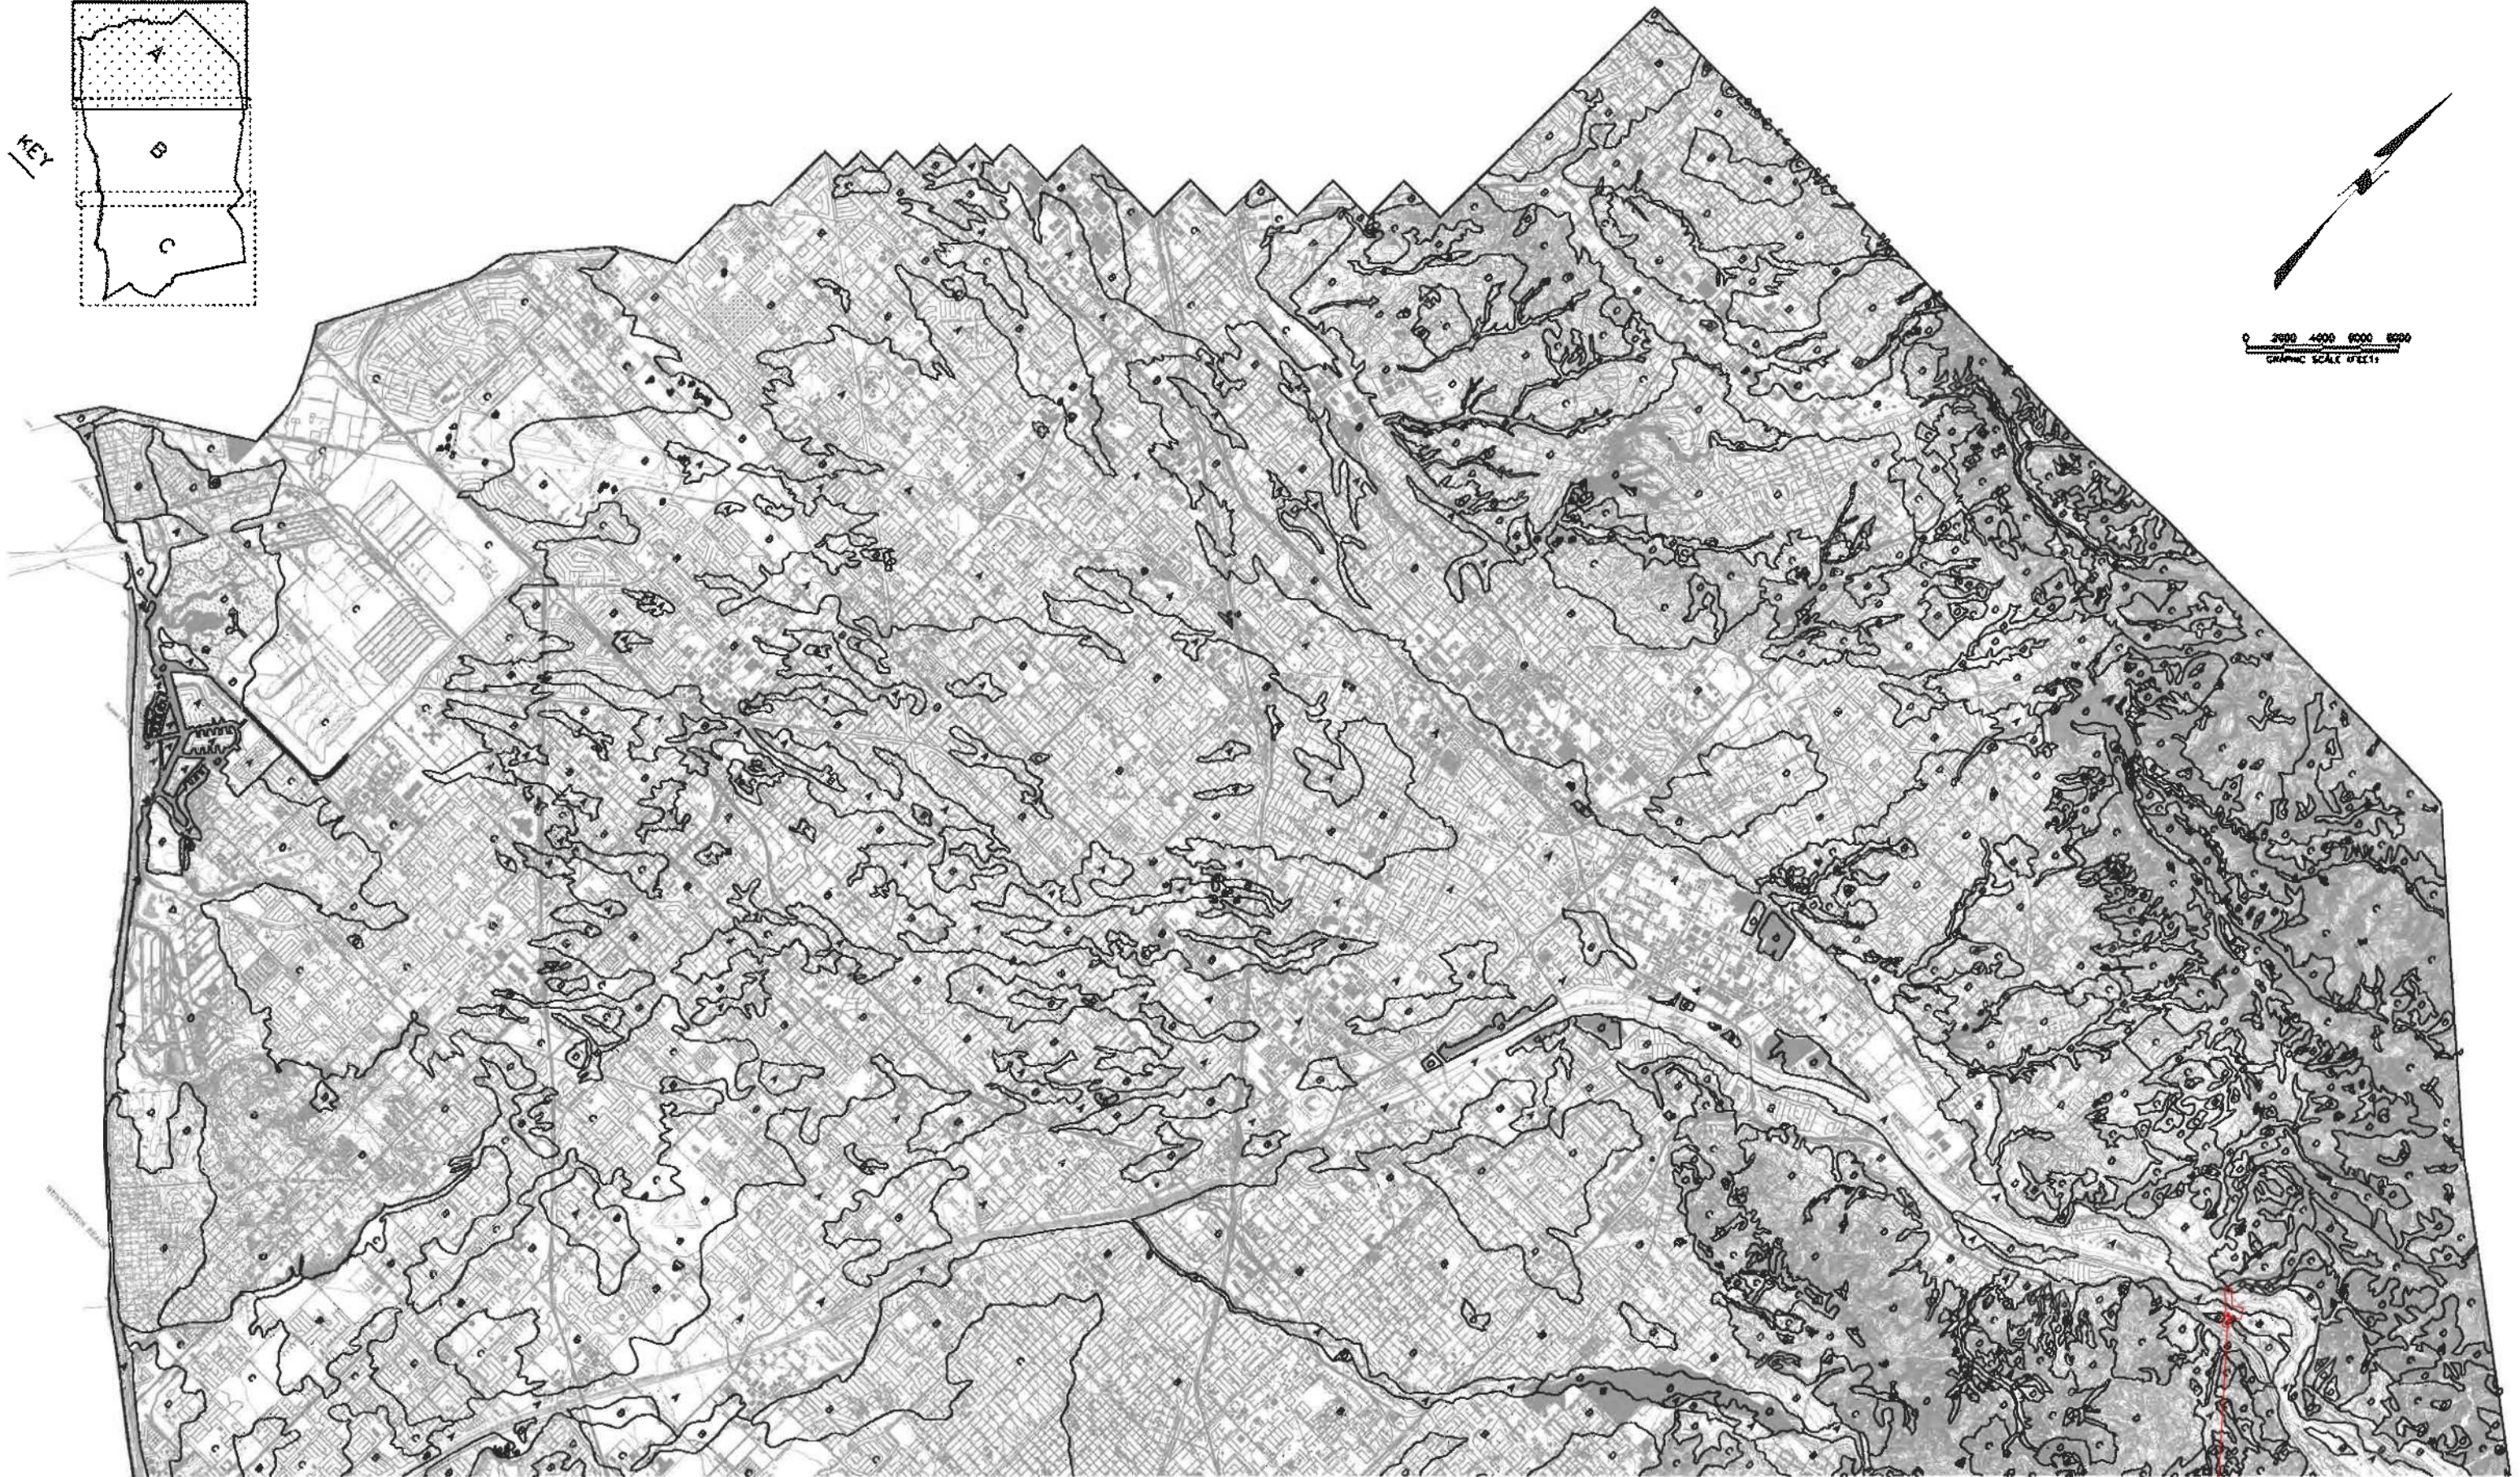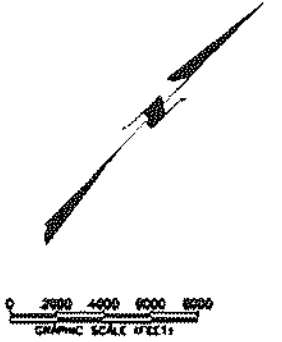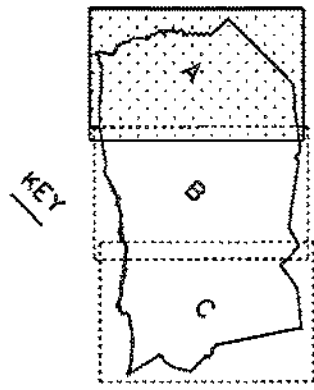

**Project Site**

LEGEND				
A	B	C	D	HYDROLOGIC SOIL GROUPS
				HYDROLOGIC SOIL GROUP BOUNDARY

SOURCES:	
BASE MAP	ORANGE COUNTY/RESOURCES & DEVELOPMENT MANAGEMENT DEPT GEOMATICS AND LAND INFORMATION SYSTEMS DIVISION
SOIL GROUPS	SOIL SURVEY OF ORANGE COUNTY AND WESTERN PART OF RIVERSIDE COUNTY, CALIFORNIA, USDA, SOIL CONSERVATION SERVICE, 1978.



Hydrology Data										
Yorba Linda Boulevard Widening Project										
(Soil Type B)										
Sub Area		Process Code	Starting Node		Ending Node		Distance between nodes (ft)	Area by Land Use Type (Ac)		Comments
No.	Area (Ac)		No.	Elev (ft)	No.	Elev (ft)		a <sub>p</sub>	a <sub>i</sub>	
A-1	2.29		100.0	385.0	101.0	351.3	761.0	0.00	2.29	Initial Subarea
A-2	2.91		101.0	351.3	102.0	345.5	890.0	0.00	2.91	Street Flow Analysis Thru Subarea
A-3	0.67		102.0	345.5	103.0	326.5	545.0	0.00	0.67	Street Flow Analysis Thru Subarea
B-1	0.99		200.0	396.5	201.0	374.8	643.0	0.00	0.99	Initial Subarea
B-2	2.28		201.0	374.8	202.0	348.0	758.0	0.00	2.28	Street Flow Analysis Thru Subarea
B-3	1.96		202.0	348.0	203.0	326.5	825.0	0.00	1.96	Street Flow Analysis Thru Subarea
C-1	1.50		300.0	440.0	301.0	405.0	552.0	0.58	0.92	Initial Subarea (Existing)
C-1	1.50		300.0	440.0	301.0	405.0	552.0	0.49	1.01	Initial Subarea (Proposed)
<b>TOTAL:</b>	<b>14.10</b>							<b>1.07</b>	<b>13.03</b>	



# YORBAEX3.RES

\*\*\*\*\*

RATIONAL METHOD HYDROLOGY COMPUTER PROGRAM PACKAGE  
(Reference: 1986 ORANGE COUNTY HYDROLOGY CRITERION)  
(c) Copyright 1983-2016 Advanced Engineering Software (aes)  
Ver. 23.0 Release Date: 07/01/2016 License ID 1436

Analysis prepared by:

## \*\*\*\*\* DESCRIPTION OF STUDY \*\*\*\*\*

\* HNTB Corporation \*  
\* Yorba Linda Blvd Widening Project \*  
\* Drainage Area C (Existing) \*  
\*\*\*\*\*

FILE NAME: YORBAEX3.DAT

TIME/DATE OF STUDY: 11:30 12/12/2019

## =====

### USER SPECIFIED HYDROLOGY AND HYDRAULIC MODEL INFORMATION:

## =====

#### --\*TIME-OF-CONCENTRATION MODEL\*--

USER SPECIFIED STORM EVENT(YEAR) = 25.00

SPECIFIED MINIMUM PIPE SIZE(INCH) = 18.00

SPECIFIED PERCENT OF GRADIENTS(DECIMAL) TO USE FOR FRICTION SLOPE = 1.00

\*DATA BANK RAINFALL USED\*

\*ANTECEDENT MOISTURE CONDITION (AMC) II ASSUMED FOR RATIONAL METHOD\*

#### \*USER-DEFINED STREET-SECTIONS FOR COUPLED PIPEFLOW AND STREETFLOW MODEL\*

NO.	HALF- WIDTH (FT)	CROWN TO CROSSFALL (FT)	STREET-CROSSFALL: IN- / OUT-/PARK- SIDE / SIDE/ WAY	CURB HEIGHT (FT)	GUTTER-GEOMETRIES: WIDTH LIP HIKE (FT) (FT) (FT)	MANNING FACTOR (n)
1	30.0	20.0	0.018/0.018/0.020	0.67	2.00 0.0313 0.167	0.0150

#### GLOBAL STREET FLOW-DEPTH CONSTRAINTS:

1. Relative Flow-Depth = 0.00 FEET

as (Maximum Allowable Street Flow Depth) - (Top-of-Curb)

2. (Depth)\*(Velocity) Constraint = 6.0 (FT\*FT/S)

\*SIZE PIPE WITH A FLOW CAPACITY GREATER THAN

OR EQUAL TO THE UPSTREAM TRIBUTARY PIPE.\*

\*USER-SPECIFIED MINIMUM TOPOGRAPHIC SLOPE ADJUSTMENT NOT SELECTED

# YORBAEX3.RES

\*\*\*\*\*

FLOW PROCESS FROM NODE 300.00 TO NODE 301.00 IS CODE = 21

-----

>>>>RATIONAL METHOD INITIAL SUBAREA ANALYSIS<<<<<

>>USE TIME-OF-CONCENTRATION NOMOGRAPH FOR INITIAL SUBAREA<<

=====

INITIAL SUBAREA FLOW-LENGTH(FEET) = 552.00

ELEVATION DATA: UPSTREAM(FEET) = 440.00 DOWNSTREAM(FEET) = 405.00

$T_c = K * [(LENGTH ** 3.00) / (ELEVATION CHANGE)] ** 0.20$

SUBAREA ANALYSIS USED MINIMUM  $T_c$ (MIN.) = 6.595

\* 25 YEAR RAINFALL INTENSITY(INCH/HR) = 4.124

SUBAREA  $T_c$  AND LOSS RATE DATA(AMC II):

DEVELOPMENT TYPE/ LAND USE	SCS SOIL GROUP	AREA (ACRES)	Fp (INCH/HR)	Ap (DECIMAL)	SCS CN	$T_c$ (MIN.)
PUBLIC PARK	B	0.58	0.30	0.850	56	10.48
COMMERCIAL	B	0.92	0.30	0.100	56	6.60

SUBAREA AVERAGE PERVIOUS LOSS RATE,  $F_p$ (INCH/HR) = 0.30

SUBAREA AVERAGE PERVIOUS AREA FRACTION,  $A_p$  = 0.390

SUBAREA RUNOFF(CFS) = 5.41

TOTAL AREA(ACRES) = 1.50 PEAK FLOW RATE(CFS) = 5.41

=====

END OF STUDY SUMMARY:

TOTAL AREA(ACRES) = 1.5  $T_c$ (MIN.) = 6.60

EFFECTIVE AREA(ACRES) = 1.50 AREA-AVERAGED  $F_m$ (INCH/HR)= 0.12

AREA-AVERAGED  $F_p$ (INCH/HR) = 0.30 AREA-AVERAGED  $A_p$  = 0.390

PEAK FLOW RATE(CFS) = 5.41

=====

=====

END OF RATIONAL METHOD ANALYSIS

↑

# YORBAPR1.RES

\*\*\*\*\*

RATIONAL METHOD HYDROLOGY COMPUTER PROGRAM PACKAGE  
(Reference: 1986 ORANGE COUNTY HYDROLOGY CRITERION)  
(c) Copyright 1983-2016 Advanced Engineering Software (aes)  
Ver. 23.0 Release Date: 07/01/2016 License ID 1436

Analysis prepared by:

## \*\*\*\*\* DESCRIPTION OF STUDY \*\*\*\*\*

\* HNTB Corporation \*  
\* Yorba Linda Lbd Widening Project \*  
\* Drainage Area A (Proposed) \*  
\*\*\*\*\*

FILE NAME: YORBAPR1.DAT  
TIME/DATE OF STUDY: 11:31 12/12/2019

## =====

### USER SPECIFIED HYDROLOGY AND HYDRAULIC MODEL INFORMATION:

## =====

#### --\*TIME-OF-CONCENTRATION MODEL\*--

USER SPECIFIED STORM EVENT(YEAR) = 25.00  
SPECIFIED MINIMUM PIPE SIZE(INCH) = 18.00  
SPECIFIED PERCENT OF GRADIENTS(DECIMAL) TO USE FOR FRICTION SLOPE = 1.00  
\*DATA BANK RAINFALL USED\*  
\*ANTECEDENT MOISTURE CONDITION (AMC) II ASSUMED FOR RATIONAL METHOD\*

#### \*USER-DEFINED STREET-SECTIONS FOR COUPLED PIPEFLOW AND STREETFLOW MODEL\*

NO.	HALF- WIDTH (FT)	CROWN TO CROSSFALL (FT)	STREET-CROSSFALL: IN- / OUT- / PARK- SIDE / SIDE / WAY	CURB HEIGHT (FT)	GUTTER-GEOMETRIES: WIDTH LIP HIKE (FT) (FT) (FT)	MANNING FACTOR (n)
1	30.0	20.0	0.018/0.018/0.020	0.67	2.00 0.0313 0.167	0.0150

#### GLOBAL STREET FLOW-DEPTH CONSTRAINTS:

1. Relative Flow-Depth = 0.00 FEET  
as (Maximum Allowable Street Flow Depth) - (Top-of-Curb)
  2. (Depth)\*(Velocity) Constraint = 6.0 (FT\*FT/S)
- \*SIZE PIPE WITH A FLOW CAPACITY GREATER THAN  
OR EQUAL TO THE UPSTREAM TRIBUTARY PIPE.\*  
\*USER-SPECIFIED MINIMUM TOPOGRAPHIC SLOPE ADJUSTMENT NOT SELECTED

YORBAPR1.RES

\*\*\*\*\*

FLOW PROCESS FROM NODE 100.00 TO NODE 101.00 IS CODE = 21

>>>>RATIONAL METHOD INITIAL SUBAREA ANALYSIS<<<<<  
>>USE TIME-OF-CONCENTRATION NOMOGRAPH FOR INITIAL SUBAREA<<

=====

INITIAL SUBAREA FLOW-LENGTH(FEET) = 761.00  
ELEVATION DATA: UPSTREAM(FEET) = 385.00 DOWNSTREAM(FEET) = 351.30

$T_c = K * [(LENGTH ** 3.00) / (ELEVATION CHANGE)] ** 0.20$   
SUBAREA ANALYSIS USED MINIMUM  $T_c$ (MIN.) = 8.057  
\* 25 YEAR RAINFALL INTENSITY(INCH/HR) = 3.682  
SUBAREA  $T_c$  AND LOSS RATE DATA(AMC II):

DEVELOPMENT TYPE/ LAND USE	SCS SOIL GROUP	AREA (ACRES)	Fp (INCH/HR)	Ap (DECIMAL)	SCS CN	$T_c$ (MIN.)
COMMERCIAL	B	2.29	0.30	0.100	56	8.06

SUBAREA AVERAGE PERVIOUS LOSS RATE, Fp(INCH/HR) = 0.30  
SUBAREA AVERAGE PERVIOUS AREA FRACTION, Ap = 0.100  
SUBAREA RUNOFF(CFS) = 7.53  
TOTAL AREA(ACRES) = 2.29 PEAK FLOW RATE(CFS) = 7.53

\*\*\*\*\*

FLOW PROCESS FROM NODE 101.00 TO NODE 102.00 IS CODE = 62

>>>>COMPUTE STREET FLOW TRAVEL TIME THRU SUBAREA<<<<<  
>>>>(STREET TABLE SECTION # 1 USED)<<<<<

=====

UPSTREAM ELEVATION(FEET) = 351.30 DOWNSTREAM ELEVATION(FEET) = 345.50  
STREET LENGTH(FEET) = 890.00 CURB HEIGHT(INCHES) = 8.0  
STREET HALFWIDTH(FEET) = 30.00

DISTANCE FROM CROWN TO CROSSFALL GRADEBREAK(FEET) = 20.00  
INSIDE STREET CROSSFALL(DECIMAL) = 0.018  
OUTSIDE STREET CROSSFALL(DECIMAL) = 0.018

SPECIFIED NUMBER OF HALFSTREETS CARRYING RUNOFF = 1  
STREET PARKWAY CROSSFALL(DECIMAL) = 0.020  
Manning's FRICTION FACTOR for Streetflow Section(curbs-to-curbs) = 0.0150  
Manning's FRICTION FACTOR for Back-of-Walk Flow Section = 0.0200

\*\*TRAVEL TIME COMPUTED USING ESTIMATED FLOW(CFS) = 11.09  
STREETFLOW MODEL RESULTS USING ESTIMATED FLOW:  
STREET FLOW DEPTH(FEET) = 0.54  
HALFSTREET FLOOD WIDTH(FEET) = 21.05  
AVERAGE FLOW VELOCITY(FEET/SEC.) = 2.67  
PRODUCT OF DEPTH&VELOCITY(FT\*FT/SEC.) = 1.44  
STREET FLOW TRAVEL TIME(MIN.) = 5.55  $T_c$ (MIN.) = 13.61  
\* 25 YEAR RAINFALL INTENSITY(INCH/HR) = 2.737

## YORBAPR1.RES

## SUBAREA LOSS RATE DATA(AMC II):

DEVELOPMENT TYPE/ LAND USE	SCS SOIL GROUP	AREA (ACRES)	Fp (INCH/HR)	Ap (DECIMAL)	SCS CN
COMMERCIAL	B	2.91	0.30	0.100	56

SUBAREA AVERAGE PERVIOUS LOSS RATE, Fp(INCH/HR) = 0.30  
 SUBAREA AVERAGE PERVIOUS AREA FRACTION, Ap = 0.100  
 SUBAREA AREA(ACRES) = 2.91 SUBAREA RUNOFF(CFS) = 7.09  
 EFFECTIVE AREA(ACRES) = 5.20 AREA-AVERAGED Fm(INCH/HR) = 0.03  
 AREA-AVERAGED Fp(INCH/HR) = 0.30 AREA-AVERAGED Ap = 0.10  
 TOTAL AREA(ACRES) = 5.2 PEAK FLOW RATE(CFS) = 12.67

## END OF SUBAREA STREET FLOW HYDRAULICS:

DEPTH(FEET) = 0.56 HALFSTREET FLOOD WIDTH(FEET) = 22.23  
 FLOW VELOCITY(FEET/SEC.) = 2.75 DEPTH\*VELOCITY(FT\*FT/SEC.) = 1.54  
 LONGEST FLOWPATH FROM NODE 100.00 TO NODE 102.00 = 1651.00 FEET.

\*\*\*\*\*

FLOW PROCESS FROM NODE 102.00 TO NODE 103.00 IS CODE = 62

-----  
 >>>>COMPUTE STREET FLOW TRAVEL TIME THRU SUBAREA<<<<<

>>>>(STREET TABLE SECTION # 1 USED)<<<<<

=====

UPSTREAM ELEVATION(FEET) = 345.50 DOWNSTREAM ELEVATION(FEET) = 326.50  
 STREET LENGTH(FEET) = 545.00 CURB HEIGHT(INCHES) = 8.0  
 STREET HALFWIDTH(FEET) = 30.00

DISTANCE FROM CROWN TO CROSSFALL GRADEBREAK(FEET) = 20.00  
 INSIDE STREET CROSSFALL(DECIMAL) = 0.018  
 OUTSIDE STREET CROSSFALL(DECIMAL) = 0.018

SPECIFIED NUMBER OF HALFSTREETS CARRYING RUNOFF = 1  
 STREET PARKWAY CROSSFALL(DECIMAL) = 0.020  
 Manning's FRICTION FACTOR for Streetflow Section(curbs-to-curbs) = 0.0150  
 Manning's FRICTION FACTOR for Back-of-Walk Flow Section = 0.0200

\*\*TRAVEL TIME COMPUTED USING ESTIMATED FLOW(CFS) = 13.43  
 STREETFLOW MODEL RESULTS USING ESTIMATED FLOW:  
 STREET FLOW DEPTH(FEET) = 0.45  
 HALFSTREET FLOOD WIDTH(FEET) = 16.21  
 AVERAGE FLOW VELOCITY(FEET/SEC.) = 5.29  
 PRODUCT OF DEPTH&VELOCITY(FT\*FT/SEC.) = 2.39  
 STREET FLOW TRAVEL TIME(MIN.) = 1.72 Tc(MIN.) = 15.33  
 \* 25 YEAR RAINFALL INTENSITY(INCH/HR) = 2.558

## SUBAREA LOSS RATE DATA(AMC II):

DEVELOPMENT TYPE/ LAND USE	SCS SOIL GROUP	AREA (ACRES)	Fp (INCH/HR)	Ap (DECIMAL)	SCS CN
COMMERCIAL	B	0.67	0.30	0.100	56

SUBAREA AVERAGE PERVIOUS LOSS RATE, Fp(INCH/HR) = 0.30

YORBAPR1.RES

SUBAREA AVERAGE PERVIOUS AREA FRACTION,  $A_p = 0.100$   
SUBAREA AREA(ACRES) = 0.67 SUBAREA RUNOFF(CFS) = 1.52  
EFFECTIVE AREA(ACRES) = 5.87 AREA-AVERAGED  $F_m$ (INCH/HR) = 0.03  
AREA-AVERAGED  $F_p$ (INCH/HR) = 0.30 AREA-AVERAGED  $A_p = 0.10$   
TOTAL AREA(ACRES) = 5.9 PEAK FLOW RATE(CFS) = 13.36

END OF SUBAREA STREET FLOW HYDRAULICS:

DEPTH(FEET) = 0.45 HALFSTREET FLOOD WIDTH(FEET) = 16.21  
FLOW VELOCITY(FEET/SEC.) = 5.26 DEPTH\*VELOCITY(FT\*FT/SEC.) = 2.38  
LONGEST FLOWPATH FROM NODE 100.00 TO NODE 103.00 = 2196.00 FEET.

=====

END OF STUDY SUMMARY:

TOTAL AREA(ACRES) = 5.9 TC(MIN.) = 15.33  
EFFECTIVE AREA(ACRES) = 5.87 AREA-AVERAGED  $F_m$ (INCH/HR)= 0.03  
AREA-AVERAGED  $F_p$ (INCH/HR) = 0.30 AREA-AVERAGED  $A_p = 0.100$   
PEAK FLOW RATE(CFS) = 13.36

=====

END OF RATIONAL METHOD ANALYSIS



# YORBAPR2.RES

\*\*\*\*\*

RATIONAL METHOD HYDROLOGY COMPUTER PROGRAM PACKAGE  
(Reference: 1986 ORANGE COUNTY HYDROLOGY CRITERION)  
(c) Copyright 1983-2016 Advanced Engineering Software (aes)  
Ver. 23.0 Release Date: 07/01/2016 License ID 1436

Analysis prepared by:

## \*\*\*\*\* DESCRIPTION OF STUDY \*\*\*\*\*

\* HNTB Corporation \*  
\* Yorba Linda Blvd Widening Project \*  
\* Drainage Area B (Proposed) \*  
\*\*\*\*\*

FILE NAME: YORBAPR2.DAT  
TIME/DATE OF STUDY: 11:32 12/12/2019

## =====

### USER SPECIFIED HYDROLOGY AND HYDRAULIC MODEL INFORMATION:

## =====

#### --\*TIME-OF-CONCENTRATION MODEL\*--

USER SPECIFIED STORM EVENT(YEAR) = 25.00  
SPECIFIED MINIMUM PIPE SIZE(INCH) = 18.00  
SPECIFIED PERCENT OF GRADIENTS(DECIMAL) TO USE FOR FRICTION SLOPE = 1.00  
\*DATA BANK RAINFALL USED\*  
\*ANTECEDENT MOISTURE CONDITION (AMC) II ASSUMED FOR RATIONAL METHOD\*

#### \*USER-DEFINED STREET-SECTIONS FOR COUPLED PIPEFLOW AND STREETFLOW MODEL\*

NO.	HALF- WIDTH (FT)	CROWN TO CROSSFALL (FT)	STREET-CROSSFALL: IN- / OUT- / PARK- SIDE / SIDE / WAY	CURB HEIGHT (FT)	GUTTER-GEOMETRIES: WIDTH LIP HIKE (FT) (FT) (FT)	MANNING FACTOR (n)
1	30.0	20.0	0.018/0.018/0.020	0.67	2.00 0.0313 0.167	0.0150

#### GLOBAL STREET FLOW-DEPTH CONSTRAINTS:

1. Relative Flow-Depth = 0.00 FEET  
as (Maximum Allowable Street Flow Depth) - (Top-of-Curb)
2. (Depth)\*(Velocity) Constraint = 6.0 (FT\*FT/S)

\*SIZE PIPE WITH A FLOW CAPACITY GREATER THAN  
OR EQUAL TO THE UPSTREAM TRIBUTARY PIPE.\*

\*USER-SPECIFIED MINIMUM TOPOGRAPHIC SLOPE ADJUSTMENT NOT SELECTED

## YORBAPR2.RES

\*\*\*\*\*

FLOW PROCESS FROM NODE 200.00 TO NODE 201.00 IS CODE = 21

-----  
 >>>>RATIONAL METHOD INITIAL SUBAREA ANALYSIS<<<<<  
 >>USE TIME-OF-CONCENTRATION NOMOGRAPH FOR INITIAL SUBAREA<<  
 =====

INITIAL SUBAREA FLOW-LENGTH(FEET) = 643.00  
 ELEVATION DATA: UPSTREAM(FEET) = 396.50 DOWNSTREAM(FEET) = 374.80

$T_c = K * [(LENGTH ** 3.00) / (ELEVATION CHANGE)] ** 0.20$

SUBAREA ANALYSIS USED MINIMUM  $T_c$ (MIN.) = 7.953

\* 25 YEAR RAINFALL INTENSITY(INCH/HR) = 3.709

SUBAREA  $T_c$  AND LOSS RATE DATA(AMC II):

DEVELOPMENT TYPE/ LAND USE	SCS SOIL GROUP	AREA (ACRES)	Fp (INCH/HR)	Ap (DECIMAL)	SCS CN	$T_c$ (MIN.)
COMMERCIAL	B	0.99	0.30	0.100	56	7.95

SUBAREA AVERAGE PERVIOUS LOSS RATE, Fp(INCH/HR) = 0.30

SUBAREA AVERAGE PERVIOUS AREA FRACTION, Ap = 0.100

SUBAREA RUNOFF(CFS) = 3.28

TOTAL AREA(ACRES) = 0.99 PEAK FLOW RATE(CFS) = 3.28

\*\*\*\*\*

FLOW PROCESS FROM NODE 201.00 TO NODE 202.00 IS CODE = 62

-----  
 >>>>COMPUTE STREET FLOW TRAVEL TIME THRU SUBAREA<<<<<  
 >>>>(STREET TABLE SECTION # 1 USED)<<<<<  
 =====

UPSTREAM ELEVATION(FEET) = 374.80 DOWNSTREAM ELEVATION(FEET) = 348.00  
 STREET LENGTH(FEET) = 758.00 CURB HEIGHT(INCHES) = 8.0  
 STREET HALFWIDTH(FEET) = 30.00

DISTANCE FROM CROWN TO CROSSFALL GRADEBREAK(FEET) = 20.00

INSIDE STREET CROSSFALL(DECIMAL) = 0.018

OUTSIDE STREET CROSSFALL(DECIMAL) = 0.018

SPECIFIED NUMBER OF HALFSTREETS CARRYING RUNOFF = 1

STREET PARKWAY CROSSFALL(DECIMAL) = 0.020

Manning's FRICTION FACTOR for Streetflow Section(curbs-to-curbs) = 0.0150

Manning's FRICTION FACTOR for Back-of-Walk Flow Section = 0.0200

\*\*TRAVEL TIME COMPUTED USING ESTIMATED FLOW(CFS) = 6.46

STREETFLOW MODEL RESULTS USING ESTIMATED FLOW:

STREET FLOW DEPTH(FEET) = 0.37

HALFSTREET FLOOD WIDTH(FEET) = 11.84

AVERAGE FLOW VELOCITY(FEET/SEC.) = 4.47

PRODUCT OF DEPTH&VELOCITY(FT\*FT/SEC.) = 1.67

STREET FLOW TRAVEL TIME(MIN.) = 2.82  $T_c$ (MIN.) = 10.78

\* 25 YEAR RAINFALL INTENSITY(INCH/HR) = 3.123



YORBAPR2.RES

SUBAREA LOSS RATE DATA(AMC II):

DEVELOPMENT TYPE/ LAND USE	SCS SOIL GROUP	AREA (ACRES)	Fp (INCH/HR)	Ap (DECIMAL)	SCS CN
COMMERCIAL	B	2.28	0.30	0.100	56

SUBAREA AVERAGE PERVIOUS LOSS RATE, Fp(INCH/HR) = 0.30  
 SUBAREA AVERAGE PERVIOUS AREA FRACTION, Ap = 0.100  
 SUBAREA AREA(ACRES) = 2.28 SUBAREA RUNOFF(CFS) = 6.35  
 EFFECTIVE AREA(ACRES) = 3.27 AREA-AVERAGED Fm(INCH/HR) = 0.03  
 AREA-AVERAGED Fp(INCH/HR) = 0.30 AREA-AVERAGED Ap = 0.10  
 TOTAL AREA(ACRES) = 3.3 PEAK FLOW RATE(CFS) = 9.10

END OF SUBAREA STREET FLOW HYDRAULICS:

DEPTH(FEET) = 0.41 HALFSTREET FLOOD WIDTH(FEET) = 13.71  
 FLOW VELOCITY(FEET/SEC.) = 4.86 DEPTH\*VELOCITY(FT\*FT/SEC.) = 1.98  
 LONGEST FLOWPATH FROM NODE 200.00 TO NODE 202.00 = 1401.00 FEET.

\*\*\*\*\*

FLOW PROCESS FROM NODE 202.00 TO NODE 203.00 IS CODE = 62

>>>>COMPUTE STREET FLOW TRAVEL TIME THRU SUBAREA<<<<<  
 >>>>(STREET TABLE SECTION # 1 USED)<<<<<

=====

UPSTREAM ELEVATION(FEET) = 348.00 DOWNSTREAM ELEVATION(FEET) = 326.50  
 STREET LENGTH(FEET) = 825.00 CURB HEIGHT(INCHES) = 8.0  
 STREET HALFWIDTH(FEET) = 30.00

DISTANCE FROM CROWN TO CROSSFALL GRADEBREAK(FEET) = 20.00  
 INSIDE STREET CROSSFALL(DECIMAL) = 0.018  
 OUTSIDE STREET CROSSFALL(DECIMAL) = 0.018

SPECIFIED NUMBER OF HALFSTREETS CARRYING RUNOFF = 1  
 STREET PARKWAY CROSSFALL(DECIMAL) = 0.020  
 Manning's FRICTION FACTOR for Streetflow Section(curbs-to-curbs) = 0.0150  
 Manning's FRICTION FACTOR for Back-of-Walk Flow Section = 0.0200

\*\*TRAVEL TIME COMPUTED USING ESTIMATED FLOW(CFS) = 11.47  
 STREETFLOW MODEL RESULTS USING ESTIMATED FLOW:  
 STREET FLOW DEPTH(FEET) = 0.45  
 HALFSTREET FLOOD WIDTH(FEET) = 16.13  
 AVERAGE FLOW VELOCITY(FEET/SEC.) = 4.56  
 PRODUCT OF DEPTH&VELOCITY(FT\*FT/SEC.) = 2.05  
 STREET FLOW TRAVEL TIME(MIN.) = 3.02 Tc(MIN.) = 13.80  
 \* 25 YEAR RAINFALL INTENSITY(INCH/HR) = 2.716

SUBAREA LOSS RATE DATA(AMC II):

DEVELOPMENT TYPE/ LAND USE	SCS SOIL GROUP	AREA (ACRES)	Fp (INCH/HR)	Ap (DECIMAL)	SCS CN
COMMERCIAL	B	1.96	0.30	0.100	56

SUBAREA AVERAGE PERVIOUS LOSS RATE, Fp(INCH/HR) = 0.30

YORBAPR2.RES

SUBAREA AVERAGE PERVIOUS AREA FRACTION,  $A_p = 0.100$   
SUBAREA AREA(ACRES) = 1.96 SUBAREA RUNOFF(CFS) = 4.74  
EFFECTIVE AREA(ACRES) = 5.23 AREA-AVERAGED  $F_m$ (INCH/HR) = 0.03  
AREA-AVERAGED  $F_p$ (INCH/HR) = 0.30 AREA-AVERAGED  $A_p = 0.10$   
TOTAL AREA(ACRES) = 5.2 PEAK FLOW RATE(CFS) = 12.64

END OF SUBAREA STREET FLOW HYDRAULICS:

DEPTH(FEET) = 0.46 HALFSTREET FLOOD WIDTH(FEET) = 16.84  
FLOW VELOCITY(FEET/SEC.) = 4.64 DEPTH\*VELOCITY(FT\*FT/SEC.) = 2.15  
LONGEST FLOWPATH FROM NODE 200.00 TO NODE 203.00 = 2226.00 FEET.

=====

END OF STUDY SUMMARY:

TOTAL AREA(ACRES) = 5.2 TC(MIN.) = 13.80  
EFFECTIVE AREA(ACRES) = 5.23 AREA-AVERAGED  $F_m$ (INCH/HR)= 0.03  
AREA-AVERAGED  $F_p$ (INCH/HR) = 0.30 AREA-AVERAGED  $A_p = 0.100$   
PEAK FLOW RATE(CFS) = 12.64

=====

END OF RATIONAL METHOD ANALYSIS



# YORBAPR3.RES

\*\*\*\*\*

RATIONAL METHOD HYDROLOGY COMPUTER PROGRAM PACKAGE  
(Reference: 1986 ORANGE COUNTY HYDROLOGY CRITERION)  
(c) Copyright 1983-2016 Advanced Engineering Software (aes)  
Ver. 23.0 Release Date: 07/01/2016 License ID 1436

Analysis prepared by:

## \*\*\*\*\* DESCRIPTION OF STUDY \*\*\*\*\*

\* HNTB Corporation \*  
\* Yorba Linda Blvd Widening Project \*  
\* Drainage Area C (Proposed) \*  
\*\*\*\*\*

FILE NAME: YORBAPR3.DAT

TIME/DATE OF STUDY: 11:33 12/12/2019

## =====

### USER SPECIFIED HYDROLOGY AND HYDRAULIC MODEL INFORMATION:

## =====

#### --\*TIME-OF-CONCENTRATION MODEL\*--

USER SPECIFIED STORM EVENT(YEAR) = 25.00

SPECIFIED MINIMUM PIPE SIZE(INCH) = 18.00

SPECIFIED PERCENT OF GRADIENTS(DECIMAL) TO USE FOR FRICTION SLOPE = 1.00

\*DATA BANK RAINFALL USED\*

\*ANTECEDENT MOISTURE CONDITION (AMC) II ASSUMED FOR RATIONAL METHOD\*

#### \*USER-DEFINED STREET-SECTIONS FOR COUPLED PIPEFLOW AND STREETFLOW MODEL\*

NO.	HALF- WIDTH (FT)	CROWN TO CROSSFALL (FT)	STREET-CROSSFALL: IN- / OUT-/PARK- SIDE / SIDE/ WAY	CURB HEIGHT (FT)	GUTTER-GEOMETRIES: WIDTH LIP HIKE (FT) (FT) (FT)	MANNING FACTOR (n)
1	30.0	20.0	0.018/0.018/0.020	0.67	2.00 0.0313 0.167	0.0150

#### GLOBAL STREET FLOW-DEPTH CONSTRAINTS:

1. Relative Flow-Depth = 0.00 FEET

as (Maximum Allowable Street Flow Depth) - (Top-of-Curb)

2. (Depth)\*(Velocity) Constraint = 6.0 (FT\*FT/S)

\*SIZE PIPE WITH A FLOW CAPACITY GREATER THAN

OR EQUAL TO THE UPSTREAM TRIBUTARY PIPE.\*

\*USER-SPECIFIED MINIMUM TOPOGRAPHIC SLOPE ADJUSTMENT NOT SELECTED

YORBAPR3.RES

\*\*\*\*\*

FLOW PROCESS FROM NODE 300.00 TO NODE 301.00 IS CODE = 21

>>>>RATIONAL METHOD INITIAL SUBAREA ANALYSIS<<<<<  
>>USE TIME-OF-CONCENTRATION NOMOGRAPH FOR INITIAL SUBAREA<<

=====

INITIAL SUBAREA FLOW-LENGTH(FEET) = 552.00  
ELEVATION DATA: UPSTREAM(FEET) = 440.00 DOWNSTREAM(FEET) = 405.00

$T_c = K * [(LENGTH ** 3.00) / (ELEVATION CHANGE)] ** 0.20$

SUBAREA ANALYSIS USED MINIMUM  $T_c$ (MIN.) = 6.595

\* 25 YEAR RAINFALL INTENSITY(INCH/HR) = 4.124

SUBAREA  $T_c$  AND LOSS RATE DATA(AMC II):

DEVELOPMENT TYPE/ LAND USE	SCS SOIL GROUP	AREA (ACRES)	Fp (INCH/HR)	Ap (DECIMAL)	SCS CN	$T_c$ (MIN.)
PUBLIC PARK	B	0.49	0.30	0.850	56	10.48
COMMERCIAL	B	1.01	0.30	0.100	56	6.60

SUBAREA AVERAGE PERVIOUS LOSS RATE,  $F_p$ (INCH/HR) = 0.30

SUBAREA AVERAGE PERVIOUS AREA FRACTION,  $A_p$  = 0.345

SUBAREA RUNOFF(CFS) = 5.43

TOTAL AREA(ACRES) = 1.50 PEAK FLOW RATE(CFS) = 5.43

=====

END OF STUDY SUMMARY:

TOTAL AREA(ACRES) = 1.5  $T_c$ (MIN.) = 6.60

EFFECTIVE AREA(ACRES) = 1.50 AREA-AVERAGED  $F_m$ (INCH/HR) = 0.10

AREA-AVERAGED  $F_p$ (INCH/HR) = 0.30 AREA-AVERAGED  $A_p$  = 0.345

PEAK FLOW RATE(CFS) = 5.43

=====

END OF RATIONAL METHOD ANALYSIS

↑

# ATTACHMENT 3

---

## HYDRAULIC CALCULATIONS

---

T1 YORBA LINDA PULLMAN ST DRAIN (Q=25YR) - ASBUILT PLANS

T2 J. ENRIQUEZ

T3

SO	2910.00	312.00	1			321.80		
R	2910.00	312.00	1	.013				
JX	2985.75	312.09	1	2	.013	16.90	312.25	45.00
R	2995.00	312.10	1	.013				1
R	3022.69	312.13	1	.013				64.44
JX	3022.69	312.13	1	2	.013	14.30	312.25	45.00
R	3027.35	312.14	1	.013				1
R	3037.96	312.15	1	.013				
JX	3095.08	312.22	1	2	.013	9.00	314.02	90.00
JX	3257.96	312.42	1	3	.013	10.90	313.00	45.00
R	3267.11	312.44	1	.013				1
R	3595.10	313.41	1	.013				
R	3625.00	313.47	1	.013				38.32
JX	3625.00	313.47	1	4	.013	20.40	314.99	45.00
R	3670.35	313.54	1	.013				57.49
R	3750.00	313.72	1	.013				
R	3769.90	313.76	1	.013				
R	3781.04	313.78	1	.013				1
SH	3781.04	313.78	1	.013				
CD	1	4						5.00
CD	2	4						3.00
CD	3	4						2.75
CD	4	4						2.00
Q		24.800	1.0					

FILE: YORBAEX.WSW

W S P G W - EDIT LISTING - Version 14.10

Date:12-11-2019 Time:12:57:53

WATER SURFACE PROFILE - CHANNEL DEFINITION LISTING

PAGE 1

CARD CODE	SECT NO	CHN TYPE	NO OF PIER/PIP	AVE PIER WIDTH	HEIGHT 1 DIAMETER	BASE WIDTH	ZL	ZR	INV DROP	Y(1)	Y(2)	Y(3)	Y(4)	Y(5)	Y(6)	Y(7)	Y(8)	Y(9)	Y(10)
CD	1	4	0		5.000														
CD	2	4	0		3.000														
CD	3	4	0		2.750														
CD	4	4	0		2.000														

W S P G W

PAGE NO 1

WATER SURFACE PROFILE - TITLE CARD LISTING

HEADING LINE NO 1 IS -

YORBA LINDA PULLMAN ST DRAIN (Q=25YR) - ASBUILT PLANS

HEADING LINE NO 2 IS -

J. ENRIQUEZ

HEADING LINE NO 3 IS -

## WATER SURFACE PROFILE - ELEMENT CARD LISTING

ELEMENT NO	1 IS A SYSTEM OUTLET	U/S DATA	STATION	INVERT	SECT	W S ELEV								
			2910.000	312.000	1	321.800								
ELEMENT NO	2 IS A REACH	U/S DATA	STATION	INVERT	SECT	N	RADIUS	ANGLE	ANG PT	MAN H				
			2910.000	312.000	1	.013	.000	.000	.000	0				
ELEMENT NO	3 IS A JUNCTION	U/S DATA	STATION	INVERT	SECT	LAT-1	LAT-2	N	Q3	Q4	INVERT-3	INVERT-4	PHI 3	PHI 4
			2985.750	312.090	1	2	0	.013	16.900	.000	312.250	.045	.000	.000
											RADIUS	ANGLE		
											.000	.000		
ELEMENT NO	4 IS A REACH	U/S DATA	STATION	INVERT	SECT	N	RADIUS	ANGLE	ANG PT	MAN H				
			2995.000	312.100	1	.013	.000	.000	.000	1				
ELEMENT NO	5 IS A REACH	U/S DATA	STATION	INVERT	SECT	N	RADIUS	ANGLE	ANG PT	MAN H				
			3022.690	312.130	1	.013	24.620	64.440	.000	0				
ELEMENT NO	6 IS A JUNCTION	U/S DATA	STATION	INVERT	SECT	LAT-1	LAT-2	N	Q3	Q4	INVERT-3	INVERT-4	PHI 3	PHI 4
			3022.690	312.130	1	2	0	.013	14.300	.000	312.250	.045	.000	.000
											RADIUS	ANGLE		
											.000	.000		
THE ABOVE ELEMENT CONTAINED AN INVERT ELEV WHICH WAS NOT GREATER THAN THE PREVIOUS INVERT ELEV -WARNING														
THE ABOVE ELEMENT CONTAINED AN INVERT ELEV WHICH WAS NOT GREATER THAN THE PREVIOUS INVERT ELEV -WARNING														
ELEMENT NO	7 IS A REACH	U/S DATA	STATION	INVERT	SECT	N	RADIUS	ANGLE	ANG PT	MAN H				
			3027.350	312.140	1	.013	.000	.000	.000	1				
ELEMENT NO	8 IS A REACH	U/S DATA	STATION	INVERT	SECT	N	RADIUS	ANGLE	ANG PT	MAN H				
			3037.960	312.150	1	.013	.000	.000	.000	0				
ELEMENT NO	9 IS A JUNCTION	U/S DATA	STATION	INVERT	SECT	LAT-1	LAT-2	N	Q3	Q4	INVERT-3	INVERT-4	PHI 3	PHI 4
			3095.080	312.220	1	2	0	.013	9.000	.000	314.020	.090	.000	.000
											RADIUS	ANGLE		
											.000	.000		



## WATER SURFACE PROFILE - ELEMENT CARD LISTING

ELEMENT NO	IS A	JUNCTION	STATION	INVERT	SECT	LAT-1	LAT-2	N	Q3	Q4	INVERT-3	INVERT-4	PHI 3	PHI 4
10	IS A	JUNCTION	3257.960	312.420	1	3	0	.013	10.900	.000	313.000	.045	.000	.000
		U/S DATA									RADIUS	ANGLE		
											.000	.000		
11	IS A	REACH	3267.110	312.440	1			.013			RADIUS	ANGLE	ANG PT	MAN H
		U/S DATA									.000	.000	.000	1
12	IS A	REACH	3595.100	313.410	1			.013			RADIUS	ANGLE	ANG PT	MAN H
		U/S DATA									.000	.000	.000	0
13	IS A	REACH	3625.000	313.470	1			.013			RADIUS	ANGLE	ANG PT	MAN H
		U/S DATA									44.706	38.320	.000	0
14	IS A	JUNCTION	3625.000	313.470	1	4	0	.013	20.400	.000	314.990	.045	.000	.000
		U/S DATA									RADIUS	ANGLE		
											.000	.000		
THE ABOVE ELEMENT CONTAINED AN INVERT ELEV WHICH WAS NOT GREATER THAN THE PREVIOUS INVERT ELEV -WARNING														
THE ABOVE ELEMENT CONTAINED AN INVERT ELEV WHICH WAS NOT GREATER THAN THE PREVIOUS INVERT ELEV -WARNING														
15	IS A	REACH	3670.350	313.540	1			.013			RADIUS	ANGLE	ANG PT	MAN H
		U/S DATA									45.197	57.490	.000	0
16	IS A	REACH	3750.000	313.720	1			.013			RADIUS	ANGLE	ANG PT	MAN H
		U/S DATA									.000	.000	.000	0
17	IS A	REACH	3769.900	313.760	1			.013			RADIUS	ANGLE	ANG PT	MAN H
		U/S DATA									.000	.000	.000	0
18	IS A	REACH	3781.040	313.780	1			.013			RADIUS	ANGLE	ANG PT	MAN H
		U/S DATA									.000	.000	.000	1
19	IS A	SYSTEM HEADWORKS	3781.040	313.780	1						W S ELEV			
		U/S DATA									.000			

Program Package Serial Number: 7244

## WATER SURFACE PROFILE LISTING

Date:12-11-2019 Time:12:58: 8

YORBA LINDA PULLMAN ST DRAIN (Q=25YR) - ASBUILT PLANS

J. ENRIQUEZ

Station	Invert Elev	Depth (FT)	Water Elev	Q (CFS)	Vel (FPS)	Vel Head	Energy Grd.El.	Super Elev	Critical Depth	Flow Top Width	Height/Dia.-FT	Base Wt or I.D.	ZL	No Wth Prs/Pip
L/Elem	Ch Slope					SF Ave	HF	SE Dpth	Froude N	Norm Dp	"N"	X-Fall	ZR	Type Ch
*****	*****	*****	*****	*****	*****	*****	*****	*****	*****	*****	*****	*****	*****	*****
2910.000	312.000	9.800	321.800	96.30	4.90	.37	322.17	.00	2.79	.00	5.000	.000	.00	0 .0
- -	- -	- -	- -	- -	- -	- -	- -	- -	- -	- -	- -	- -	- -	- -
JUNCT STR	.0012					.0011	.09	9.80	.00		.013	.00	.00	PIPE
2985.750	312.090	9.972	322.062	79.40	4.04	.25	322.32	.00	2.52	.00	5.000	.000	.00	0 .0
- -	- -	- -	- -	- -	- -	- -	- -	- -	- -	- -	- -	- -	- -	- -
9.250	.0011					.0009	.01	9.97	.00	3.80	.013	.00	.00	PIPE
2995.000	312.100	9.984	322.084	79.40	4.04	.25	322.34	.00	2.52	.00	5.000	.000	.00	0 .0
- -	- -	- -	- -	- -	- -	- -	- -	- -	- -	- -	- -	- -	- -	- -
27.690	.0011					.0009	.03	.00	.00	3.80	.013	.00	.00	PIPE
3022.690	312.130	10.022	322.152	79.40	4.04	.25	322.41	.00	2.52	.00	5.000	.000	.00	0 .0
- -	- -	- -	- -	- -	- -	- -	- -	- -	- -	- -	- -	- -	- -	- -
JUNCT STR	.0000					.0008	.00	10.02	.00		.013	.00	.00	PIPE
3022.690	312.130	10.143	322.273	65.10	3.32	.17	322.44	.00	2.27	.00	5.000	.000	.00	0 .0
- -	- -	- -	- -	- -	- -	- -	- -	- -	- -	- -	- -	- -	- -	- -
4.660	.0021					.0006	.00	10.14	.00	2.62	.013	.00	.00	PIPE
3027.350	312.140	10.144	322.284	65.10	3.32	.17	322.46	.00	2.27	.00	5.000	.000	.00	0 .0
- -	- -	- -	- -	- -	- -	- -	- -	- -	- -	- -	- -	- -	- -	- -
10.610	.0009					.0006	.01	10.14	.00	3.43	.013	.00	.00	PIPE
3037.960	312.150	10.141	322.291	65.10	3.32	.17	322.46	.00	2.27	.00	5.000	.000	.00	0 .0
- -	- -	- -	- -	- -	- -	- -	- -	- -	- -	- -	- -	- -	- -	- -
JUNCT STR	.0012					.0005	.03	10.14	.00		.013	.00	.00	PIPE
3095.080	312.220	10.172	322.392	56.10	2.86	.13	322.52	.00	2.10	.00	5.000	.000	.00	0 .0
- -	- -	- -	- -	- -	- -	- -	- -	- -	- -	- -	- -	- -	- -	- -
JUNCT STR	.0012					.0004	.06	10.17	.00		.013	.00	.00	PIPE
3257.960	312.420	10.091	322.511	45.20	2.30	.08	322.59	.00	1.88	.00	5.000	.000	.00	0 .0
- -	- -	- -	- -	- -	- -	- -	- -	- -	- -	- -	- -	- -	- -	- -
9.150	.0022					.0003	.00	10.09	.00	2.11	.013	.00	.00	PIPE

Date:12-11-2019 Time:12:58: 8

[illegible]

T1 YORBA LINDA PULLMAN ST DRAIN (Q=25YR) - PROPOSED

T2 J. ENRIQUEZ

T3

SO	2910.00	312.00	1			321.80		
R	2910.00	312.00	1	.013				
JX	2985.75	312.09	1 2	.013	16.90	312.25	45.00	
R	2995.00	312.10	1	.013				1
R	3022.69	312.13	1	.013			64.44	
JX	3022.69	312.13	1 2	.013	14.30	312.25	45.00	
R	3027.35	312.14	1	.013				1
R	3037.96	312.15	1	.013				
JX	3095.08	312.22	1 2	.013	9.00	314.02	90.00	
JX	3257.96	312.42	1 3	.013	14.82	313.00	45.00	
R	3267.11	312.44	1	.013				1
R	3595.10	313.41	1	.013				
R	3625.00	313.47	1	.013			38.32	
JX	3625.00	313.47	1 4	.013	20.40	314.99	45.00	
R	3670.35	313.54	1	.013			57.49	
R	3750.00	313.72	1	.013				
R	3769.90	313.76	1	.013				
R	3781.04	313.78	1	.013				1
SH	3781.04	313.78	1	.013				
CD	1 4						5.00	
CD	2 4						3.00	
CD	3 4						2.75	
CD	4 4						2.00	
Q		24.800	1.0					

FILE: YORBAPR.WSW

W S P G W - EDIT LISTING - Version 14.10

Date:12-11-2019 Time: 1: 5:37

WATER SURFACE PROFILE - CHANNEL DEFINITION LISTING

PAGE 1

CARD CODE	SECT NO	CHN TYPE	NO OF PIER/PIP	AVE PIER WIDTH	HEIGHT 1 DIAMETER	BASE WIDTH	ZL	ZR	INV DROP	Y(1)	Y(2)	Y(3)	Y(4)	Y(5)	Y(6)	Y(7)	Y(8)	Y(9)	Y(10)
CD	1	4	0		5.000														
CD	2	4	0		3.000														
CD	3	4	0		2.750														
CD	4	4	0		2.000														

W S P G W

PAGE NO 1

WATER SURFACE PROFILE - TITLE CARD LISTING

HEADING LINE NO 1 IS -

YORBA LINDA PULLMAN ST DRAIN (Q=25YR) - PROPOSED

HEADING LINE NO 2 IS -

J. ENRIQUEZ

HEADING LINE NO 3 IS -

## WATER SURFACE PROFILE - ELEMENT CARD LISTING

ELEMENT NO	1 IS A SYSTEM OUTLET	U/S DATA	STATION	INVERT	SECT	W S ELEV								
			2910.000	312.000	1	321.800								
ELEMENT NO	2 IS A REACH	U/S DATA	STATION	INVERT	SECT	N	RADIUS	ANGLE	ANG PT	MAN H				
			2910.000	312.000	1	.013	.000	.000	.000	0				
ELEMENT NO	3 IS A JUNCTION	U/S DATA	STATION	INVERT	SECT	LAT-1	LAT-2	N	Q3	Q4	INVERT-3	INVERT-4	PHI 3	PHI 4
			2985.750	312.090	1	2	0	.013	16.900	.000	312.250	.045	.000	.000
											RADIUS	ANGLE		
											.000	.000		
ELEMENT NO	4 IS A REACH	U/S DATA	STATION	INVERT	SECT	N	RADIUS	ANGLE	ANG PT	MAN H				
			2995.000	312.100	1	.013	.000	.000	.000	1				
ELEMENT NO	5 IS A REACH	U/S DATA	STATION	INVERT	SECT	N	RADIUS	ANGLE	ANG PT	MAN H				
			3022.690	312.130	1	.013	24.620	64.440	.000	0				
ELEMENT NO	6 IS A JUNCTION	U/S DATA	STATION	INVERT	SECT	LAT-1	LAT-2	N	Q3	Q4	INVERT-3	INVERT-4	PHI 3	PHI 4
			3022.690	312.130	1	2	0	.013	14.300	.000	312.250	.045	.000	.000
											RADIUS	ANGLE		
											.000	.000		
THE ABOVE ELEMENT CONTAINED AN INVERT ELEV WHICH WAS NOT GREATER THAN THE PREVIOUS INVERT ELEV -WARNING														
THE ABOVE ELEMENT CONTAINED AN INVERT ELEV WHICH WAS NOT GREATER THAN THE PREVIOUS INVERT ELEV -WARNING														
ELEMENT NO	7 IS A REACH	U/S DATA	STATION	INVERT	SECT	N	RADIUS	ANGLE	ANG PT	MAN H				
			3027.350	312.140	1	.013	.000	.000	.000	1				
ELEMENT NO	8 IS A REACH	U/S DATA	STATION	INVERT	SECT	N	RADIUS	ANGLE	ANG PT	MAN H				
			3037.960	312.150	1	.013	.000	.000	.000	0				
ELEMENT NO	9 IS A JUNCTION	U/S DATA	STATION	INVERT	SECT	LAT-1	LAT-2	N	Q3	Q4	INVERT-3	INVERT-4	PHI 3	PHI 4
			3095.080	312.220	1	2	0	.013	9.000	.000	314.020	.090	.000	.000
											RADIUS	ANGLE		
											.000	.000		

## W S P G W

PAGE NO 3

## WATER SURFACE PROFILE - ELEMENT CARD LISTING

ELEMENT NO	IS A	JUNCTION	STATION	INVERT	SECT	LAT-1	LAT-2	N	Q3	Q4	INVERT-3	INVERT-4	PHI 3	PHI 4
10	IS A	JUNCTION	3257.960	312.420	1	3	0	.013	14.820	.000	313.000	.045	.000	.000
		U/S DATA									RADIUS	ANGLE		
											.000	.000		
11	IS A	REACH	3267.110	312.440	1			.013			RADIUS	ANGLE	ANG PT	MAN H
		U/S DATA									.000	.000	.000	1
12	IS A	REACH	3595.100	313.410	1			.013			RADIUS	ANGLE	ANG PT	MAN H
		U/S DATA									.000	.000	.000	0
13	IS A	REACH	3625.000	313.470	1			.013			RADIUS	ANGLE	ANG PT	MAN H
		U/S DATA									44.706	38.320	.000	0
14	IS A	JUNCTION	3625.000	313.470	1	4	0	.013	20.400	.000	314.990	.045	.000	.000
		U/S DATA									RADIUS	ANGLE		
											.000	.000		
THE ABOVE ELEMENT CONTAINED AN INVERT ELEV WHICH WAS NOT GREATER THAN THE PREVIOUS INVERT ELEV -WARNING														
THE ABOVE ELEMENT CONTAINED AN INVERT ELEV WHICH WAS NOT GREATER THAN THE PREVIOUS INVERT ELEV -WARNING														
15	IS A	REACH	3670.350	313.540	1			.013			RADIUS	ANGLE	ANG PT	MAN H
		U/S DATA									45.197	57.490	.000	0
16	IS A	REACH	3750.000	313.720	1			.013			RADIUS	ANGLE	ANG PT	MAN H
		U/S DATA									.000	.000	.000	0
17	IS A	REACH	3769.900	313.760	1			.013			RADIUS	ANGLE	ANG PT	MAN H
		U/S DATA									.000	.000	.000	0
18	IS A	REACH	3781.040	313.780	1			.013			RADIUS	ANGLE	ANG PT	MAN H
		U/S DATA									.000	.000	.000	1
19	IS A	SYSTEM HEADWORKS	3781.040	313.780	1						W S ELEV			
		U/S DATA									.000			

Program Package Serial Number: 7244

## WATER SURFACE PROFILE LISTING

Date:12-11-2019 Time: 1: 5:46

YORBA LINDA PULLMAN ST DRAIN (Q=25YR) - PROPOSED

J. ENRIQUEZ

Station	Invert Elev	Depth (FT)	Water Elev	Q (CFS)	Vel (FPS)	Vel Head	Energy Grd.El.	Super Elev	Critical Depth	Flow Top Width	Height/Dia.-FT	Base Wt or I.D.	ZL	No Wth Prs/Pip
L/Elem	Ch Slope					SF Ave	HF	SE Dpth	Froude N	Norm Dp	"N"	X-Fall	ZR	Type Ch
*****	*****	*****	*****	*****	*****	*****	*****	*****	*****	*****	*****	*****	*****	*****
2910.000	312.000	9.800	321.800	100.22	5.10	.40	322.20	.00	2.85	.00	5.000	.000	.00	0 .0
JUNCT STR	.0012					.0013	.09	9.80	.00		.013	.00	.00	PIPE
2985.750	312.090	9.991	322.081	83.32	4.24	.28	322.36	.00	2.59	.00	5.000	.000	.00	0 .0
9.250	.0011					.0010	.01	9.99	.00	3.98	.013	.00	.00	PIPE
2995.000	312.100	10.004	322.104	83.32	4.24	.28	322.38	.00	2.59	.00	5.000	.000	.00	0 .0
27.690	.0011					.0010	.03	.00	.00	3.98	.013	.00	.00	PIPE
3022.690	312.130	10.050	322.180	83.32	4.24	.28	322.46	.00	2.59	.00	5.000	.000	.00	0 .0
JUNCT STR	.0000					.0009	.00	10.05	.00		.013	.00	.00	PIPE
3022.690	312.130	10.180	322.310	69.02	3.52	.19	322.50	.00	2.34	.00	5.000	.000	.00	0 .0
4.660	.0021					.0007	.00	10.18	.00	2.71	.013	.00	.00	PIPE
3027.350	312.140	10.182	322.322	69.02	3.52	.19	322.51	.00	2.34	.00	5.000	.000	.00	0 .0
10.610	.0009					.0007	.01	10.18	.00	3.59	.013	.00	.00	PIPE
3037.960	312.150	10.180	322.330	69.02	3.52	.19	322.52	.00	2.34	.00	5.000	.000	.00	0 .0
JUNCT STR	.0012					.0006	.04	10.18	.00		.013	.00	.00	PIPE
3095.080	312.220	10.221	322.441	60.02	3.06	.15	322.59	.00	2.18	.00	5.000	.000	.00	0 .0
JUNCT STR	.0012					.0004	.07	10.22	.00		.013	.00	.00	PIPE
3257.960	312.420	10.155	322.576	45.20	2.30	.08	322.66	.00	1.88	.00	5.000	.000	.00	0 .0
9.150	.0022					.0003	.00	10.16	.00	2.11	.013	.00	.00	PIPE



Program Package Serial Number: 7244

## WATER SURFACE PROFILE LISTING

Date:12-11-2019 Time: 1: 5:46

YORBA LINDA PULLMAN ST DRAIN (Q=25YR) - PROPOSED

J. ENRIQUEZ

*****															*****	
Station	Invert Elev	Depth (FT)	Water Elev	Q (CFS)	Vel (FPS)	Vel Head	Energy Grd.El.	Super Elev	Critical Depth	Flow Top Width	Height/Dia.-FT	Base Wt or I.D.	ZL	No Wth Prs/Pip		
L/Elem	Ch Slope					SF Ave	HF	SE Dpth	Froude N	Norm Dp	"N"	X-Fall	ZR	Type Ch		
*****	*****	*****	*****	*****	*****	*****	*****	*****	*****	*****	*****	*****	*****	*****		
3267.110	312.440	10.142	322.582	45.20	2.30	.08	322.66	.00	1.88	.00	5.000	.000	.00	0 .0		
- -	- -	- -	- -	- -	- -	- -	- -	- -	- -	- -	- -	- -	- -	- -		
327.990	.0030					.0003	.10	10.14	.00	1.94	.013	.00	.00	PIPE		
3595.100	313.410	9.271	322.681	45.20	2.30	.08	322.76	.00	1.88	.00	5.000	.000	.00	0 .0		
- -	- -	- -	- -	- -	- -	- -	- -	- -	- -	- -	- -	- -	- -	- -		
29.900	.0020					.0003	.01	.00	.00	2.16	.013	.00	.00	PIPE		
3625.000	313.470	9.231	322.701	45.20	2.30	.08	322.78	.00	1.88	.00	5.000	.000	.00	0 .0		
- -	- -	- -	- -	- -	- -	- -	- -	- -	- -	- -	- -	- -	- -	- -		
JUNCT STR	.0000					.0002	.00	.00	.00		.013	.00	.00	PIPE		
3625.000	313.470	9.288	322.758	24.80	1.26	.02	322.78	.00	1.38	.00	5.000	.000	.00	0 .0		
- -	- -	- -	- -	- -	- -	- -	- -	- -	- -	- -	- -	- -	- -	- -		
45.350	.0015					.0001	.00	.00	.00	1.68	.013	.00	.00	PIPE		
3670.350	313.540	9.226	322.766	24.80	1.26	.02	322.79	.00	1.38	.00	5.000	.000	.00	0 .0		
- -	- -	- -	- -	- -	- -	- -	- -	- -	- -	- -	- -	- -	- -	- -		
79.650	.0023					.0001	.01	9.23	.00	1.52	.013	.00	.00	PIPE		
3750.000	313.720	9.054	322.774	24.80	1.26	.02	322.80	.00	1.38	.00	5.000	.000	.00	0 .0		
- -	- -	- -	- -	- -	- -	- -	- -	- -	- -	- -	- -	- -	- -	- -		
19.900	.0020					.0001	.00	9.05	.00	1.56	.013	.00	.00	PIPE		
3769.900	313.760	9.016	322.776	24.80	1.26	.02	322.80	.00	1.38	.00	5.000	.000	.00	0 .0		
- -	- -	- -	- -	- -	- -	- -	- -	- -	- -	- -	- -	- -	- -	- -		
11.140	.0018					.0001	.00	9.02	.00	1.61	.013	.00	.00	PIPE		
3781.040	313.780	8.998	322.778	24.80	1.26	.02	322.80	.00	1.38	.00	5.000	.000	.00	0 .0		
- -	- -	- -	- -	- -	- -	- -	- -	- -	- -	- -	- -	- -	- -	- -		

LOS ANGELES COUNTY DEPARTMENT OF PUBLIC WORKS							
(For use on Los Angeles County Department of Public Works projects only)							
CATCH BASIN "V" DEPTH CALCS. IN SERIES							
<b>PROJECT: Yorba Linda Blvd Widening</b>						SH.	OF
JOB NO.						BY:	J. Enriquez
COMMENTS: Existing Condition							
INPUT				OUTPUT			
<b>C.B. at Sta. 11+24.04 Savi Ranch Parkway</b>							
HGL elev. =	322.51	ft.		Pipe Area 1 =	5.94	sq.ft.	
Curb face =	8.00	in.		K1 =	529		
Freeboard =	6.00	in.		V1 =	3.22	ft/sec	
L.D. drop =	2.00	in.		Hv1 =	0.16	ft.	
				1.2 x Hv1 =	0.19	ft.	
<b>U/S C.B. DATA</b>				Sf x L1 =	0.19	ft.	
T.C elev. =	327.45	ft.					
Connector pipe L1 =	144.82	ft.		Pipe Area 2 =	4.91	sq.ft.	
Connector pipe D1 =	33.00	in.		K2 =	410		
C.B. design Q1 =	19.10	cfs		V2 =	6.48	ft/sec	
				Hv2 =	0.65	ft.	
				1.2 x Hv2 =	0.78	ft.	
<b>D/S C.B. DATA</b>				Sf x L2 =	0.39	ft.	
T.C elev. =	327.32	ft.					
Connector pipe L2 =	64.63	ft.		Available H2 =	3.48	ft.	
Connector pipe D2 =	30.00	in.		Req'd H2 =	1.17	ft.	
C.B. design Q2 =	12.70	cfs		Avail H2 >= Req'd H2 ?	<b>OK</b>		
				Available H =	3.61	ft.	
				Req'd H =	1.55	ft.	
				Avail H >= Req'd H ?	<b>OK</b>		
				<b>Min. V1 =</b>	4.28	ft.	
				Use V1 =	7.00	ft.	
				V2in > V1 - G + (L1*0.01) =	8.32	ft.	
				Use V2in =	8.32	ft.	
				<b>Min. V2out =</b>	4.87	ft.	
				Use V2out =	13.36	ft.	

LOS ANGELES COUNTY DEPARTMENT OF PUBLIC WORKS					
(For use on Los Angeles County Department of Public Works projects only)					
CATCH BASIN "V" DEPTH CALCS. IN SERIES					
<b>PROJECT: Yorba Linda Blvd Widening</b>				SH.	OF
JOB NO.				BY:	J. Enriquez
COMMENTS: Proposed Condition					
INPUT			OUTPUT		
<b>C.B. at Sta. 11+24.04 Savi Ranch Parkway</b>					
HGL elev. =	322.58	ft.	Pipe Area 1 =	5.94	sq.ft.
Curb face =	8.00	in.	K1 =	529	
Freeboard =	6.00	in.	V1 =	4.38	ft/sec
L.D. drop =	2.00	in.	Hv1 =	0.30	ft.
			1.2 x Hv1 =	0.36	ft.
<b>U/S C.B. DATA</b>			Sf x L1 =	0.35	ft.
T.C elev. =	327.45	ft.			
Connector pipe L1 =	144.82	ft.	Pipe Area 2 =	4.91	sq.ft.
Connector pipe D1 =	33.00	in.	K2 =	410	
C.B. design Q1 =	26.00	cfs	V2 =	7.87	ft/sec
			Hv2 =	0.96	ft.
			1.2 x Hv2 =	1.15	ft.
<b>D/S C.B. DATA</b>			Sf x L2 =	0.57	ft.
T.C elev. =	327.32	ft.			
Connector pipe L2 =	64.63	ft.	Available H2 =	3.41	ft.
Connector pipe D2 =	30.00	in.	Req'd H2 =	1.73	ft.
C.B. design Q2 =	12.64	cfs	Avail H2 >= Req'd H2 ?	<b>OK</b>	
			Available H =	3.54	ft.
			Req'd H =	2.44	ft.
			Avail H >= Req'd H ?	<b>OK</b>	
			<b>Min. V1 =</b>	4.44	ft.
			Use V1 =	7.00	ft.
			V2in > V1 - G + (L1*0.01) =	8.32	ft.
			Use V2in =	8.32	ft.
			<b>Min. V2out =</b>	5.57	ft.
			Use V2out =	13.36	ft.

---

## Drainage Area A (EXISTING)

---

### Project Description

Solve For                      Spread

### Input Data

Discharge		6.40	ft <sup>3</sup> /s
Gutter Width		2.00	ft
Gutter Cross Slope		0.08	ft/ft
Road Cross Slope		0.02	ft/ft
Curb Opening Length		6.00	ft
Opening Height		0.67	ft
Curb Throat Type	Inclined		
Local Depression		2.00	in
Local Depression Width		2.00	ft
Throat Incline Angle		90.00	degrees

### Results

Spread	21.90	ft
Depth	0.56	ft
Gutter Depression	0.13	ft
Total Depression	0.29	ft

---

## Drainage Area A (PROPOSED)

---

### Project Description

Solve For                      Spread

### Input Data

Discharge		13.36	ft <sup>3</sup> /s
Gutter Width		2.00	ft
Gutter Cross Slope		0.08	ft/ft
Road Cross Slope		0.02	ft/ft
Curb Opening Length		17.00	ft
Opening Height		0.67	ft
Curb Throat Type	Inclined		
Local Depression		2.00	in
Local Depression Width		2.00	ft
Throat Incline Angle		90.00	degrees

### Results

Spread	21.50	ft
Depth	0.56	ft
Gutter Depression	0.13	ft
Total Depression	0.29	ft

---

## Drainage Area B (EXISTING)

---

### Project Description

Solve For Spread

### Input Data

Discharge		12.70	ft <sup>3</sup> /s
Gutter Width		2.00	ft
Gutter Cross Slope		0.08	ft/ft
Road Cross Slope		0.02	ft/ft
Curb Opening Length		6.00	ft
Opening Height		0.67	ft
Curb Throat Type	Inclined		
Local Depression		2.00	in
Local Depression Width		2.00	ft
Throat Incline Angle		90.00	degrees

### Results

Spread	34.58	ft
Depth	0.82	ft
Gutter Depression	0.13	ft
Total Depression	0.29	ft

---

## Drainage Area B (PROPOSED)

---

### Project Description

Solve For                      Spread

### Input Data

Discharge		12.64	ft <sup>3</sup> /s
Gutter Width		2.00	ft
Gutter Cross Slope		0.08	ft/ft
Road Cross Slope		0.02	ft/ft
Curb Opening Length		7.00	ft
Opening Height		0.67	ft
Curb Throat Type	Inclined		
Local Depression		2.00	in
Local Depression Width		2.00	ft
Throat Incline Angle		90.00	degrees

### Results

Spread	32.27	ft
Depth	0.77	ft
Gutter Depression	0.13	ft
Total Depression	0.29	ft

# ATTACHMENT 4

---

AS-BUILT PLANS

---



# GENERAL NOTES

- All necessary utility construction within the street right of way shall be completed prior to paving per this plan.
- All work, as shown on this plan, shall be in accordance with the applicable sections of standard specifications, for public works construction, City of Anaheim standard plans, contract documents and standard specification supplement and the latest revisions thereof.
- All paving removal shall be sawcut at the City Engineer's direction. Minimum depth of cut: 1 1/2".
- "No expansive soil exists or will be imported for use within the public right of way."
- Methods of handling irrigation lines within limits of improvements:
  - Abandoned lines - Remove & plug to construction limits
  - Lines in service - Relocate out of the street right of way
- 4" Thick sand blanket under all sidewalks and 4" thick aggregate base section under all curb and gutter is required unless a report from a registered soils engineer is submitted and approved stating that the soil is non-expansive and that the sand blanket and/or aggregate base is not required.
- Reports of compaction within the traveled way of all streets shall be submitted to and accepted by the City Engineer prior to placing any street paving.
- Prior to approval of improvements by the Engineering Division and acceptance by the City, centerline monuments shall be set at all points of intersecting streets, beginning of curves, points of reverse curve, end of curves, center of cul-de-sacs and any other points so designated by the Field Engineer. Ties to monuments shall be set and a copy of said ties shall be furnished to the Field Engineer office.
- Adjust all storm drain and sewer manholes, and water valves, to grade.
- All regulatory signs shall be placed within 24 hours after curb returns have been constructed in locations as shown on these plans.
- It shall be the contractors responsibility to protect all traffic signs where applicable.
- "Following completion of construction, the survey markers which have been disturbed by the construction activities shall be reset in their original location and the ties submitted to the Survey Division for approval."
- Before the forms have been set and 24 hours prior to the placement of any concrete for sidewalk or drive approach construction the contractor shall adjust all necessary utilities within the parkway to grade and obtain approval from the Field Eng. - 999-5126.
- Notify Underground Service Alert on 1-800-422-4133 a minimum of 48 hrs. prior to start of construction within the Public Right-of-way.
- "Soil cement trench backfill shall be required to within 1' of the finished grade where sewer or storm drain is to be constructed outside of the public right of way at a slope of 5:1 or more, unless waived by the Field Engineer."

## PRIVATE ENGINEER'S NOTICE TO CONTRACTOR

THE EXISTENCE AND LOCATION OF ANY UNDERGROUND UTILITIES OR STRUCTURES SHOWN ON THESE PLANS ARE OBTAINED BY A SEARCH OF AVAILABLE RECORDS. TO THE BEST OF OUR KNOWLEDGE THERE ARE NO EXISTING UTILITIES EXCEPT THOSE SHOWN ON THIS PLAN. THE CONTRACTOR IS REQUIRED TO TAKE ALL PRECAUTIONARY MEASURES TO PROTECT THE UTILITIES SHOWN, AND ANY OTHER LINES OR STRUCTURES NOT SHOWN ON THESE PLANS, AND IS RESPONSIBLE FOR THE PROTECTION OF, AND ANY DAMAGE TO THESE LINES OR STRUCTURES.

## CONSTRUCTION NOTES

- \*CONST. "AC OVER" "AB"
- CONST. TYPE "A" CURB & GUTTER, 8" C.F., PER CITY STD. DETAIL NO. 104-F
- CONST. TYPE "B" CURB & GUTTER, 6" C.F. PER CITY STD. DETAIL NO. 104-F
- CONST. MEDIAN CURB & GUTTER PER DETAIL ON PLAN NO. 14762
- CONST. ISLAND CURB & GUTTER PER DETAIL ON PLAN NO. 14762
- CONST. 4" THICK PCC SIDEWALK PER CITY STD. DETAIL NO. 110-C
- CONST. STD. METAL BEAM GUARD RAILING PER CITY STD. DETAIL NO. 120
- CONST. CURB DEPRESSION FOR SIDEWALK ACCESS RAMPS PER CITY STD. DETAIL NO. 124-C
- CONST. CURB DEPRESSION FOR ISLAND ACCESS RAMPS
- CONST. REINFORCED CONCRETE PROTECTION PER DETAIL ON PLAN NO. 14763
- CONST. PATTERN STAMPED CONCRETE (BOMANITE) HACIENDA BROWN BASKET WEAVE
- INSTALL STREET NAME SIGNS PER CITY STD. DETAIL NO. 127
- CONST. PCC INTERCEPTOR DRAIN PER DETAIL ON PLAN NO. 14766
- CONST. PCC DOWN DRAIN PER DETAIL ON PLAN NO. 14765
- CONST. CONC. BLOCK SPLASH WALL PER DETAIL IN ADDENDUM NO. 1, EXHIBIT 2
- OVEREXCAVATE TO 2' BELOW EXISTING GROUND OR SUBGRADE (WHICHEVER IS LOWER). BACKFILL WITH UNCLASSIFIED FILL TO 90% RELATIVE COMPACTION.
- CONST. DBL 36" BRICK & MORTAR BULKHEAD

\*STRUCTURAL SECTION TO BE DETERMINED AND APPROVED PRIOR TO PLACING PAVEMENT.

THIS PLAN HAS BEEN EXAMINED AND IS APPROVED ONLY AS TO COMPATIBILITY WITH EXISTING OR FUTURE IMPROVEMENTS AND CONFORMANCE WITH CITY OF ANAHEIM STANDARD DETAILS AND THE REQUIREMENTS FOR THE FOLLOWING APPLICABLE FACTORS: RIGHT OF WAY, ROADWAY MATERIALS, ALIGNMENTS AND GRADES, HYDROLOGY AND HYDRAULICS DESIGN OF STORM DRAIN OR SANITARY SEWER SYSTEMS AND UNDERGROUND CONDUIT OR OPEN-CHANNEL ALIGNMENTS, GRADES, SIZES AND MATERIALS.

## REVISIONS

NO.	DATE	INITIAL	DESCRIPTION	DATE	APPR.
1	5-19-83	MH	REVISED TRAFFIC SIGNS & PAVEMENT LEGENDS	7-5-83	
2	6-27-83	MSM	CHANGE PER CITY OF ANAHEIM		
3	5-20-83	MSM	ADDED TELEPHONE CONSTRUCTION DATA ON WEIR CANYON ROAD		
4	7-5-83	AUF	ADDED FIRE HYDRANTS, CHANGED RAIL LOCATION YORBA LINDA SIDE ONLY		
5	7-5-83	AUF	SEWER LATERAL RELOCATION YORBA LINDA SIDE ONLY	7/14/83	
6	7-20-83	AUF	WATER LINE AND INTERTIE RELOCATION AND REVISION	7/20/83	

# CITY OF ANAHEIM PLANS FOR THE CONSTRUCTION OF

SAVI RANCH PARKWAY  
FROM 490'± NE'LY OF TO PULLMAN ST.



OLD CANAL ROAD  
FROM 695'± NE'LY OF TO PULLMAN ST.

PULLMAN STREET  
FROM CRYSTAL DR. TO OLD CANAL ROAD

CRYSTAL DRIVE  
FROM 215'± NE'LY OF TO PULLMAN ST.

WEIR CANYON ROAD  
FROM WEIR CYN. RD. BRIDGE TO 479'± SE'LY

NOTE: FOR U.S. ELECTRICAL FACILITIES  
SEE CITY OF ANAHEIM ELECTRICAL  
UTILITIES DNG. ESM. 052088.

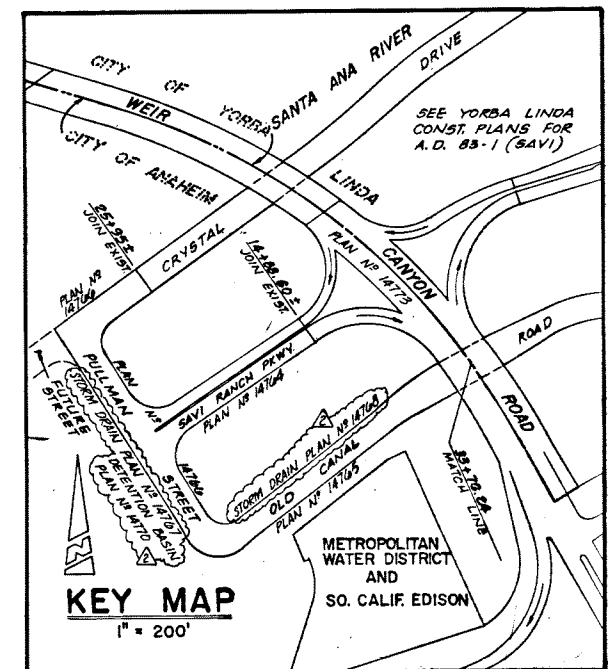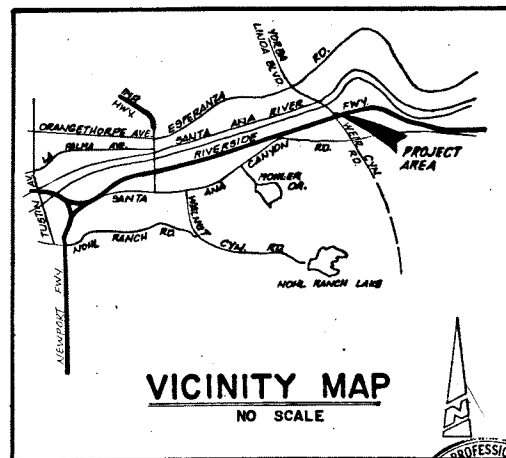

NO.	DATE	INITIAL	DESCRIPTION OF REVISION	DATE	APPR.
1	1-19-81	H.C.C.	PER CITY OF ANAHEIM PLAN CHECK	3/11/81	
2	8-24-81	V.C.M.	REV. "A" CURB	10/28/81	
3	5-16-84	L.A.S.	ADDED "B" V.C.F. SEWER LINE		
4	5-8-84	L.O.E.	REVISED MEDIAN		
5	5-24-84	L.A.S.	REVISED LOCATION OF WATER LINE		
6	12-29-84	L.O.E.	MISC. REVISIONS TO STREET, TO STORM DRAIN, SEWER & WATER		
7	11-21-84	MSM	DELETED FIRE HYDRANTS AT STA'S 19+30 & 40+87, ADDED GATE VALVE @ STA 19+30		
8	10-20-84	MSM	REVISED PER Y.L.C.M.A.		
9	10-1-84	MSM	ADDED STEEL		
10	9-29-84	MH	CHANGE PER CITY OF ANAHEIM		
11	8-29-84	L.O.E.	DELETED E.P. ADDED 6" W. CURB & GUTTER @ SAVI RANCH PKWY		
12	7-8-84	MSM	REVISED M.W.D. INLET AT OLD CANAL RD. STA. 27+70		
13	6-25-84	MSM	ADDED SEWER AT OLD CANAL (MIRAGE)		
14	6-18-84	L.O.E.	REVISED SLOPE & S.D. INLETS @ OLD CANAL RD. STA 28+87 TO 38+50		
15	6-5-84	MSM	WATER LINE AND INTERTIE RELOCATION AND REVISION		

## REFERENCES

NO.	DATE	INITIAL	DESCRIPTION	DATE	APPR.
1	5-19-83	MH	REVISED TRAFFIC SIGNS & PAVEMENT LEGENDS	7-5-83	
2	6-27-83	MSM	CHANGE PER CITY OF ANAHEIM		
3	5-20-83	MSM	ADDED TELEPHONE CONSTRUCTION DATA ON WEIR CANYON ROAD		
4	7-5-83	AUF	ADDED FIRE HYDRANTS, CHANGED RAIL LOCATION YORBA LINDA SIDE ONLY		
5	7-5-83	AUF	SEWER LATERAL RELOCATION YORBA LINDA SIDE ONLY	7/14/83	
6	7-20-83	AUF	WATER LINE AND INTERTIE RELOCATION AND REVISION	7/20/83	

CITY OF YORBA LINDA A.D. 88-01  
APPROVED  
CITY ENGINEER  
10/15/84  
DATE

SCALE: AS SHOWN  
PREPARED UNDER THE SUPERVISION OF  
R.C.E. NO. 30706  
RECOMMEND APPROVAL  
DEPUTY CITY ENGINEER  
APPROVED  
CITY ENGINEER  
3-22-88



PLANS PREPARED FOR  
CITY OF YORBA LINDA  
4845 MAIN STREET  
P.O. BOX 487 - PH (714) 777-5000  
YORBA LINDA, CA. 92686  
ASSESSMENT DISTRICT 83-1

PLANS PREPARED BY  
BERRYMAN & STEPHENSON INC.  
1415 EAST REVEREND STREET  
SANTA ANA, CALIFORNIA 92701  
(714) 966-1088

STREET & STORM DRAIN IMPROVEMENT PLANS FOR  
SAVI RANCH PARKWAY, OLD CANAL ROAD, PULLMAN  
STREET, CRYSTAL DRIVE & WEIR CANYON ROAD  
TITLE SHEET

CITY OF ANAHEIM


SP 1556

SHEET 1 OF 14


14761

PLAN NUMBER


NO.	ITEM	QUANTITY
1.	CLEARING & GRUBBING	15
2.	UNCLASSIFIED EXCAVATION	90,000 CY
3.	UNCLASSIFIED FILL	100 CY
4.	ASPHALT CONCRETE PAVEMENT	2,750 TN
5.	AGGREGATE BASE	7,410 TN
6.	TYPE "A" CURB & GUTTER (8")	3,400 LF
7.	TYPE "B" CURB & GUTTER (6")	180 LF
8.	ISLAND CURB (6")	370 LF
9.	MEDIAN CURB (8")	1,230 LF
10.	4" PCC SIDEWALK	960 SF
11.	PATTERN STAMPED PCC (BOMANITE)	4,720 SF
12.	METAL BEAM GUARD RAIL	100 LF
13.	MWO PROTECTION	DELETED
14.	60" RCP 1350D	796 LF
15.	42" RCP 1350D THICKWALLED	102 LF
16.	36" RCP 1350D	140 LF
17.	33" RCP 1350D	432 LF
18.	30" RCP 1500D	64 LF
19.	27" RCP 1350D	95 LF
20.	24" RCP 2400D	16 LF
21.	24" RCP 1500D	54 LF
22.	24" RCP 1350D	12 LF
23.	18" RCP 1500D	125 LF
24.	60" CSP 12 GA.	111 LF
25.	60" CSP TEE 12 GA.	1 EA
26.	60" CONCRETE COLLAR	3 EA
27.	42" CONCRETE COLLAR	1 EA
28.	24" CONCRETE COLLAR	1 EA
29.	MANHOLE NO. 4	2 EA
30.	MANHOLE NO. 2	2 EA
31.	MANHOLE NO. 1	1 EA
32.	JUNCTION STRUCTURE NO. 4	1 EA
33.	JUNCTION STRUCTURE NO. 2	1 EA
34.	CATCH BASIN NO. 1 W=10' W/LD	1 EA
35.	CATCH BASIN NO. 1 W=6' W/LD	6 EA
36.	24" CSP INLET PER DETAIL	5 EA
37.	MWD INLET	DELETED
38.	24" CSP PERFORATED RISER INLET	DELETED
39.	96" CSP OUTLET	DELETED
40.	RIP RAP	DELETED
41.	OBL. BRICK & MORTAR BULKHEAD (36")	DELETED
42.	72" I.D. R.C. M.H., PUMP. STA.	DELETED
43.	DETENTION BASIN PUMPS AND CONTROLS	DELETED
44.	8" PVC SCH. 40 DISCHARGE LINE	DELETED
45.	CONCRETE SLOPE ANCHORS	DELETED
46.	60" CSP ANTI-SEEP RING	3 EA
47.	GROUTED RIPRAP	13 CY
48.	R.C. VEE DITCH	1,455 LF
49.	NON-REINFORCED CONCRETE DITCH	700 LF
50.	6" HIGH C.L. FENCE W/GATE	DELETED

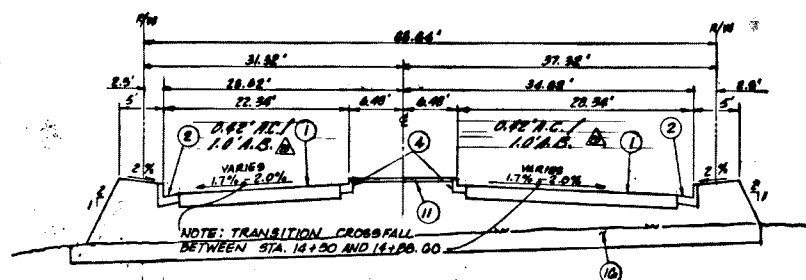


SAVI RANCH PARKWAY  
STA. 14+00 TO 14+80.02

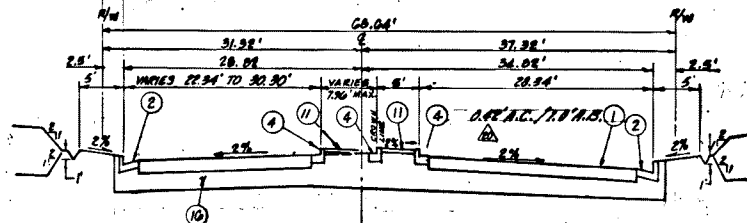

SAVI RANCH PARKWAY  
STA. 11+15 TO 14+00

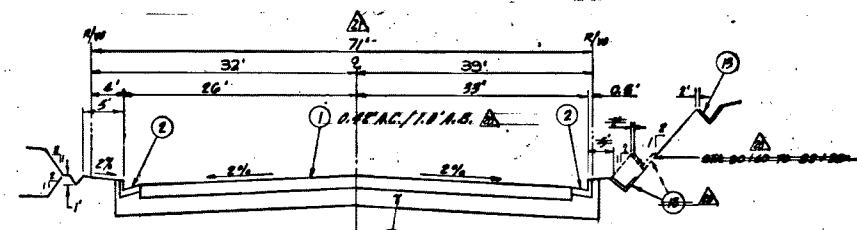


OLD CANAL ROAD

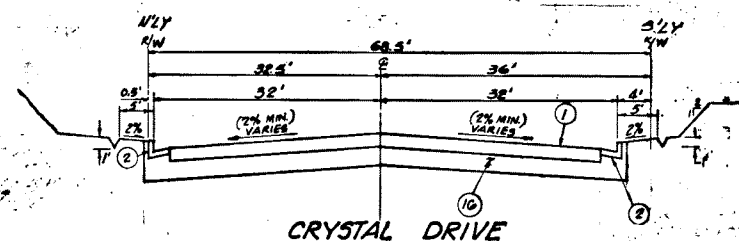


CRYSTAL DRIVE




PULLMAN STREET

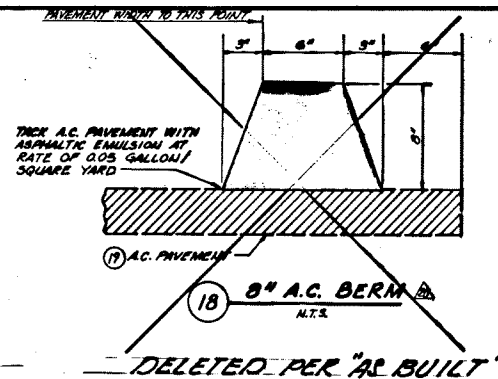


DELETED PER "AS BUILT"

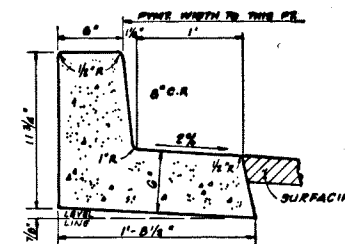

4 MEDIAN CURB DETAIL  
N.T.S.

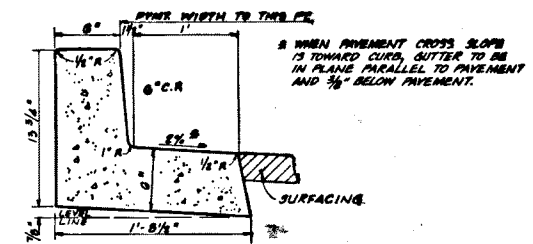

5 ISLAND CURB DETAIL  
N.T.S.

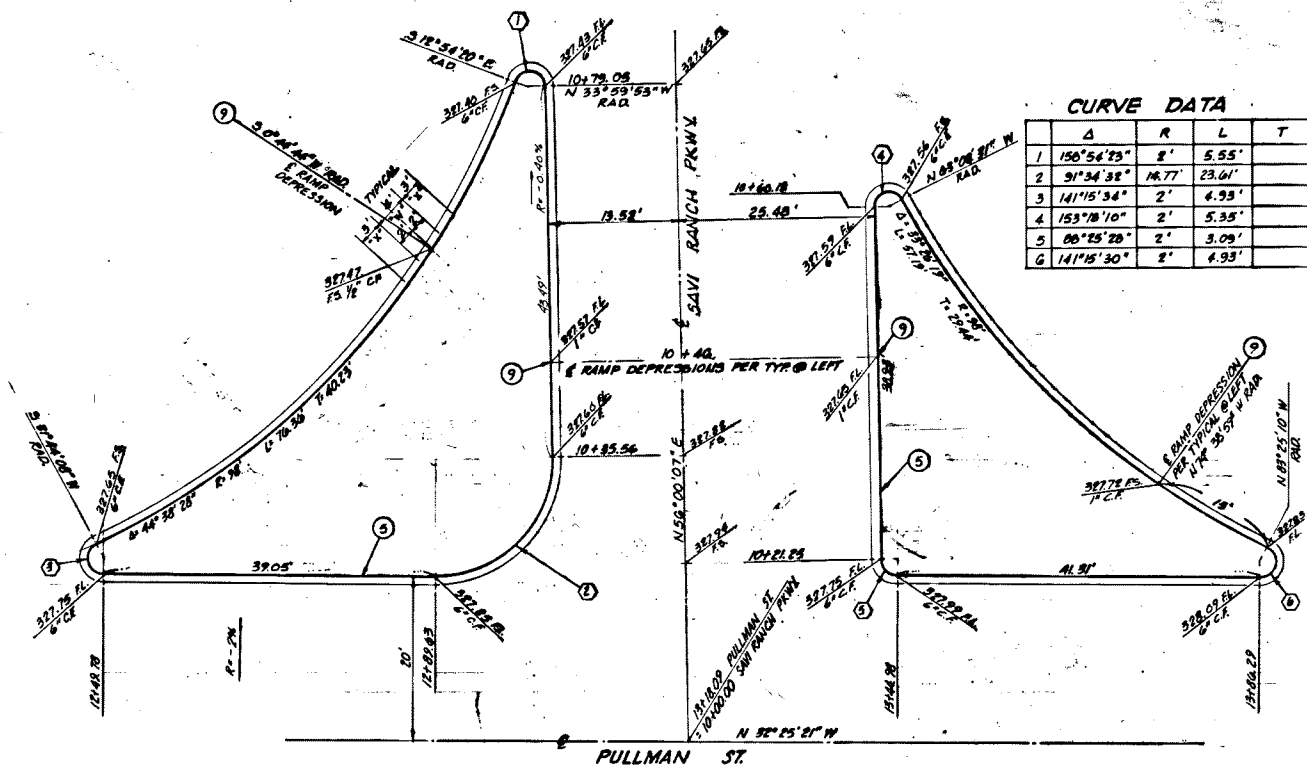

	Δ	R	L	T
1	150°54'23"	8'	5.55'	
2	91°34'38"	16.77'	23.61'	
3	141°15'34"	2'	4.95'	
4	153°18'10"	2'	5.35'	
5	86°25'28"	2'	3.09'	
6	141°15'30"	2'	4.93'	

ISLAND DETAIL  
N.T.S.

#### CONSTRUCTION NOTES



1. CONSTRUCT A.C. OVER A.B.
2. CONSTRUCT TYPE "A" CURB & GUTTER, 6" C.R. PER CITY STD. DETAIL NO. 104-P.
3. CONSTRUCT MEDIAN CURB & GUTTER PER DETAIL HEREON.
4. CONSTRUCT ISLAND CURB & GUTTER PER DETAIL HEREON.
5. CONSTRUCT CURB DEPRESSION FOR ISLAND ACCESS RAMPS.
6. CONSTRUCT PATTERNS STAMPED CONCRETE (ROMAITE) HAGLEUDA BROWN BASKET MEANS.
7. CONSTRUCT R.C.C. INTERCEPTOR DRAIN PER DETAIL ON PLAN 14766.
8. OVEREXCAVATE TO 2' BELOW EXISTING GROUND OR SUBGRADE (WHICHEVER IS LOWER).
9. BACKFILL WITH UNCLASSIFIED FILL TO 90% RELATIVE COMPACTION.
10. CONSTRUCT 8" A.C. BERM PER DETAIL HEREON.
11. CONSTRUCT 3" TEMPORARY A.C. PAVT. ON NATIVE SOIL.
12. STRUCTURAL SECTION TO BE DETERMINED AND APPROVED PRIOR TO PLACING PAVEMENT.



THIS PLAN HAS BEEN EXAMINED AND IS APPROVED ONLY AS TO COMPATIBILITY WITH ADJOINING EXISTING OR FUTURE IMPROVEMENTS AND CONFORMANCE WITH CITY OF ANAHEIM STANDARD DETAILS AND THE REQUIREMENTS FOR THE FOLLOWING APPLICABLE FACTORS: RIGHT OF WAY, ROADWAY MATERIALS, ALIGNMENTS AND GRADES, HYDROLOGY AND HYDRAULICS DESIGN OF STORM DRAIN OR SANITARY SEWER SYSTEMS AND UNDERGROUND CONDUIT OR OPEN-CHANNEL ALIGNMENTS, GRADES, SIZES AND MATERIALS.

FOR GENERAL NOTES, QUANTITY ESTIMATE & KEY MAP SEE PLAN 14754.

REVISIONS					REFERENCES					SCALE:		DATE		STREET IMPROVEMENTS		SHEET 2 OF 4	
NO.	DATE	INITIAL	DESCRIPTION	DATE	APPR.	BENCH MARK: EL. = 348.697	PLANS FOR THESE IMPROVEMENTS CITY OF ANAHEIM STD. DTL'S.	PREPARED UNDER THE SUPERVISION OF	R.C.E. NO.	RECOMMEND APPROVAL	DEPUTY CITY ENGINEER	APPROVED	CITY ENGINEER	SAVI RANCH PARKWAY, OLD CANAL ROAD PULLMAN STREET, CRYSTAL DRIVE		TYPICAL ROADWAY SECTIONS, CURB & ISLAND DETAILS	
1	11-21-88	WFS	PER CITY OF ANAHEIM PLAN CHECK			0.15 MI. N.W. ON WEIR CYN. RD., FROM THE RIVERSIDE HWY. TO A CONC. HDWL. ON THE WEST SIDE, 35' W. OF THE CENTERLINE OF WEIR CYN. RD., 114' S. OF THE S.A.V.I. CANAL, SET IN THE TOP OF THE CONC. HDWL. C.C.S. 1976 ADA 311 20-71	STREET 14766, 14772, 14773 SEWER 14774 - 14777 STORM DRAIN 14768, 14769, 14771	<i>James L. Sullivan</i>	24704	<i>James L. Sullivan</i>	1-28-88	<i>James L. Sullivan</i>	3-22-88	CITY OF ANAHEIM		14762 PLAN NUMBER	

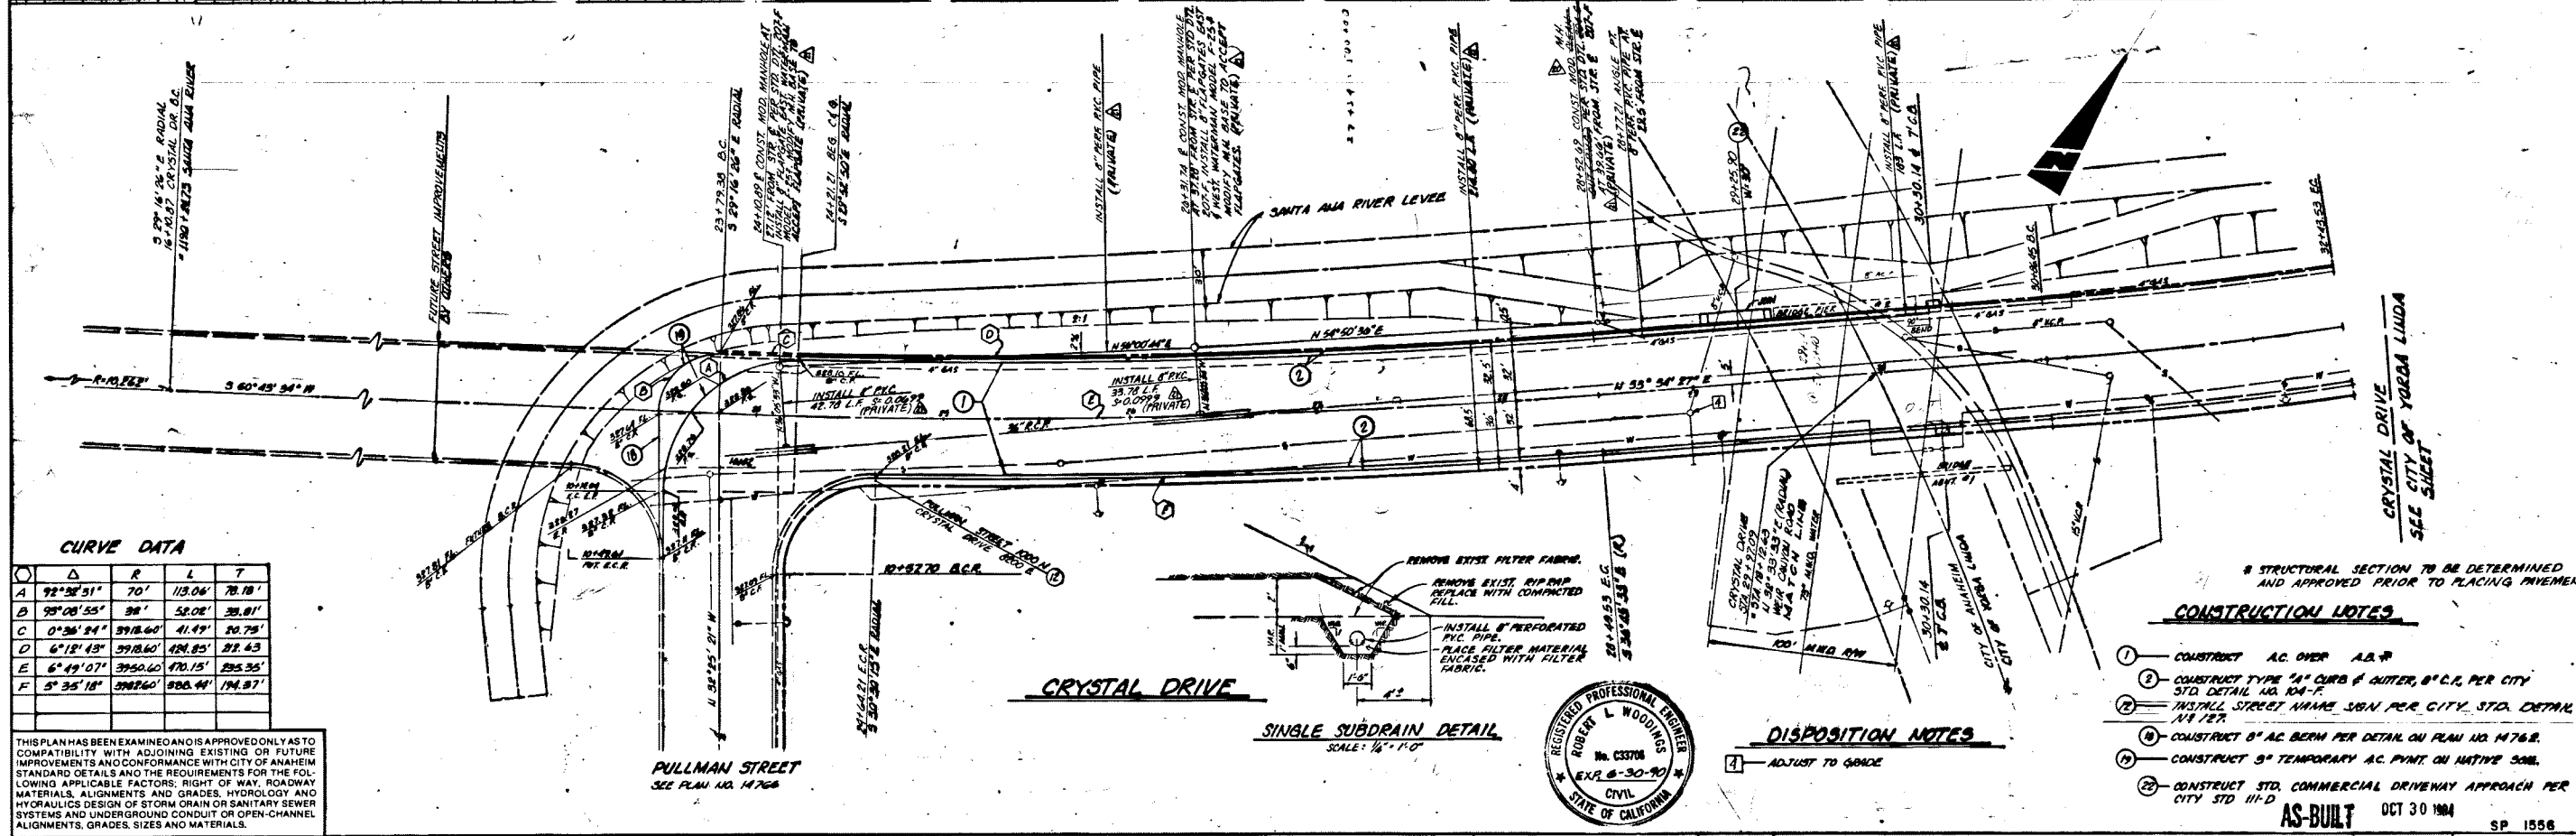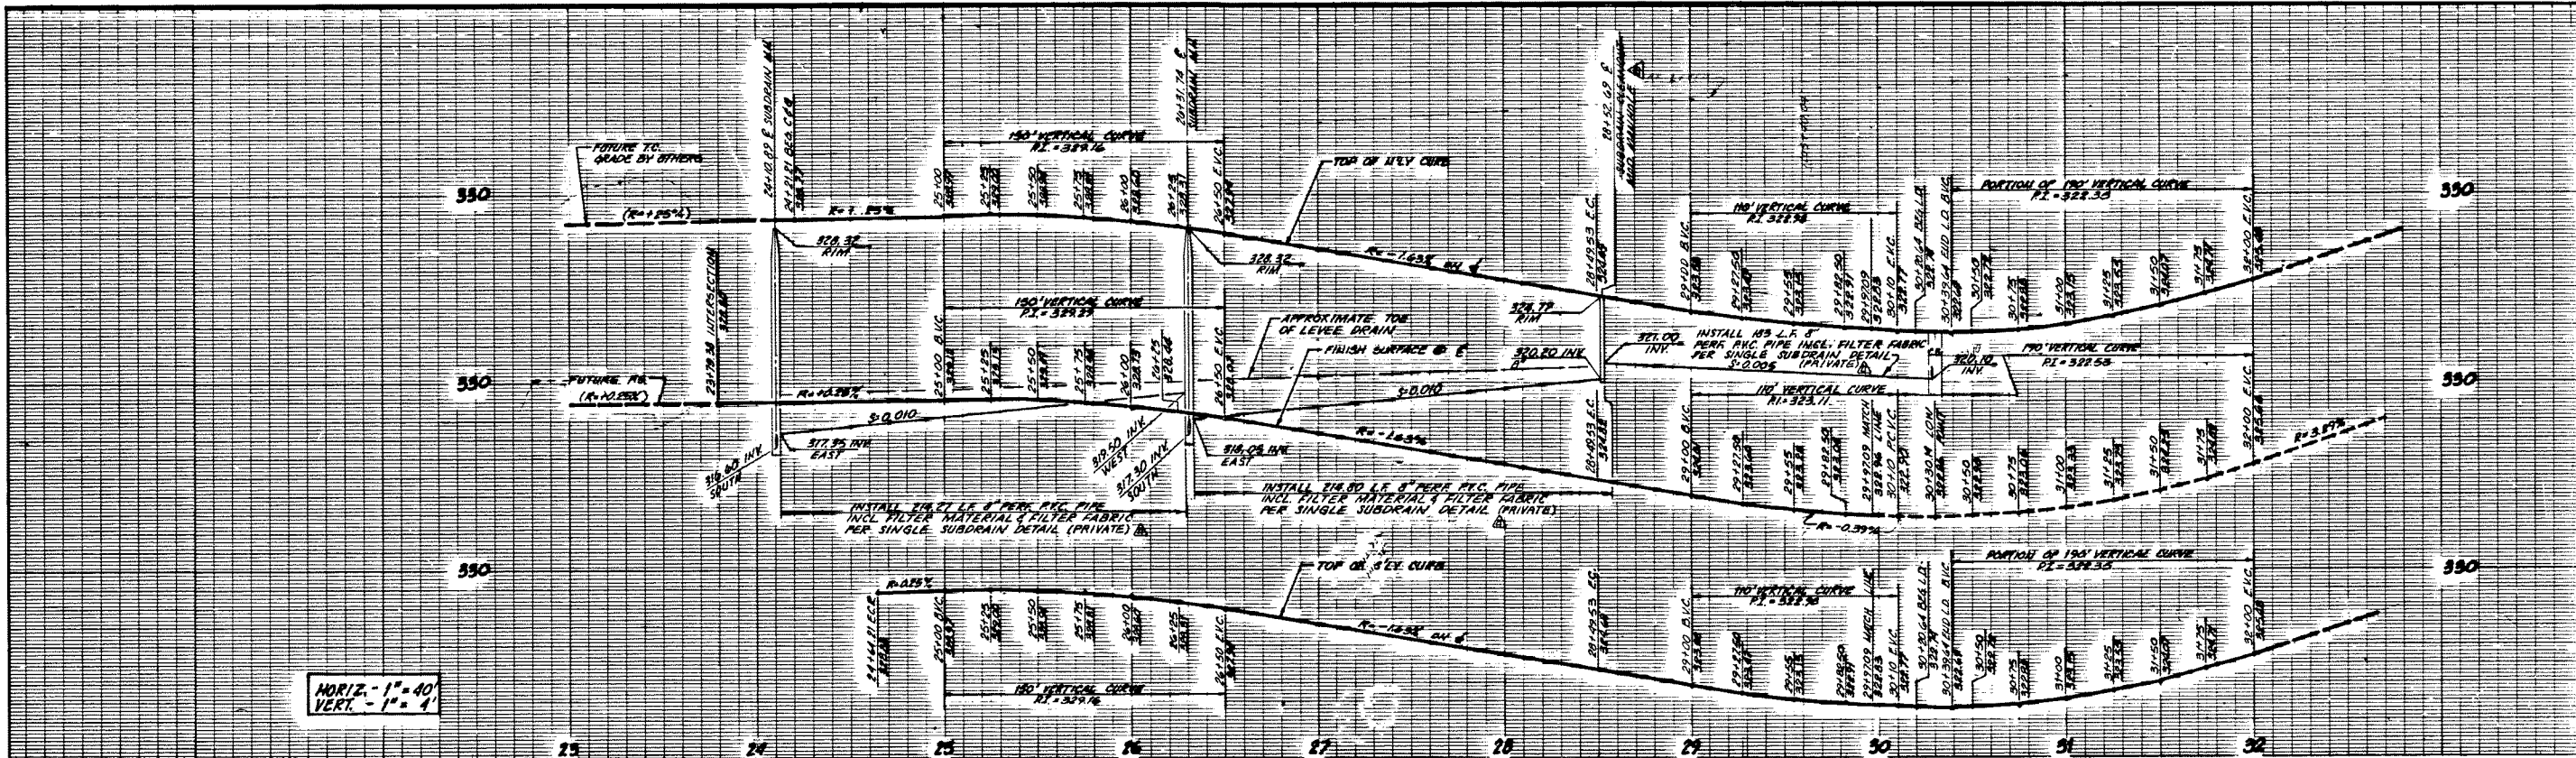

**CURVE DATA**


Δ	R	L	T
92° 58' 51"	70'	113.06'	78.18'
98° 08' 55"	38'	52.02'	39.81'
0° 36' 24"	5918.60'	41.49'	20.79'
6° 12' 43"	5918.60'	424.85'	32.43'
6° 49' 07"	3950.40'	470.15'	235.35'
5° 35' 18"	5922.60'	828.44'	194.87'

THIS PLAN HAS BEEN EXAMINED AND IS APPROVED ONLY AS TO COMPATIBILITY WITH ADJOINING EXISTING OR FUTURE IMPROVEMENTS AND CONFORMANCE WITH CITY OF ANAHEIM STANDARD DETAILS AND THE REQUIREMENTS FOR THE FOLLOWING APPLICABLE FACTORS: RIGHT OF WAY, ROADWAY MATERIALS, ALIGNMENTS AND GRADES, HYDROLOGY AND HYDRAULICS DESIGN OF STORM DRAIN OR SANITARY SEWER SYSTEMS AND UNDERGROUND CONDUIT OR OPEN-CHANNEL ALIGNMENTS, GRADES, SIZES AND MATERIALS.

- CONSTRUCTION NOTES**
- CONSTRUCT AC OVER A.B.
  - CONSTRUCT TYPE "A" CURB & GUTTER, 8" C.P. PER CITY STD. DETAIL NO. 104-F
  - INSTALL STREET NAME SIGN PER CITY STD. DETAIL 111-12
  - CONSTRUCT 8" AC BERM PER DETAIL ON PLAN NO. 14762
  - CONSTRUCT 3" TEMPORARY AC PAVT ON EXISTING SUB.
  - CONSTRUCT STD. COMMERCIAL DRIVEWAY APPROACH PER CITY STD. 111-D
- DISPOSITION NOTES**
- ADJUST TO GRADE
- AS-BUILT** OCT 30 1984

REVISIONS				REFERENCES				SCALE		DATE		STREET IMPROVEMENTS		SHEET 3 OF 14	
NO.	DATE	INITIAL	DESCRIPTION	DATE	APPR.	BENCH MARK	PLANS FOR THESE IMPROVEMENTS CITY OF ANAHEIM STD. DTLS.	PREPARED UNDER THE SUPERVISION OF	R.C.E. NO.	RECOMMEND APPROVAL	CITY ENGINEER	CITY OF ANAHEIM	14763	PLAN NUMBER	
1	11-14-81	H.C.	PER "AS BUILT"				STREET					CRYSTAL DRIVE			
2	11-14-81	H.C.	PER CITY OF ANAHEIM PLAN CHECK				SEWER					FROM WEIR CANYON ROAD TO PULLMAN STREET			
							STORM DRAIN					CITY OF ANAHEIM			
							APPR. ELECTRICAL ENGINEERING MANAGER								
							APPR. WATER ENGINEERING MANAGER								



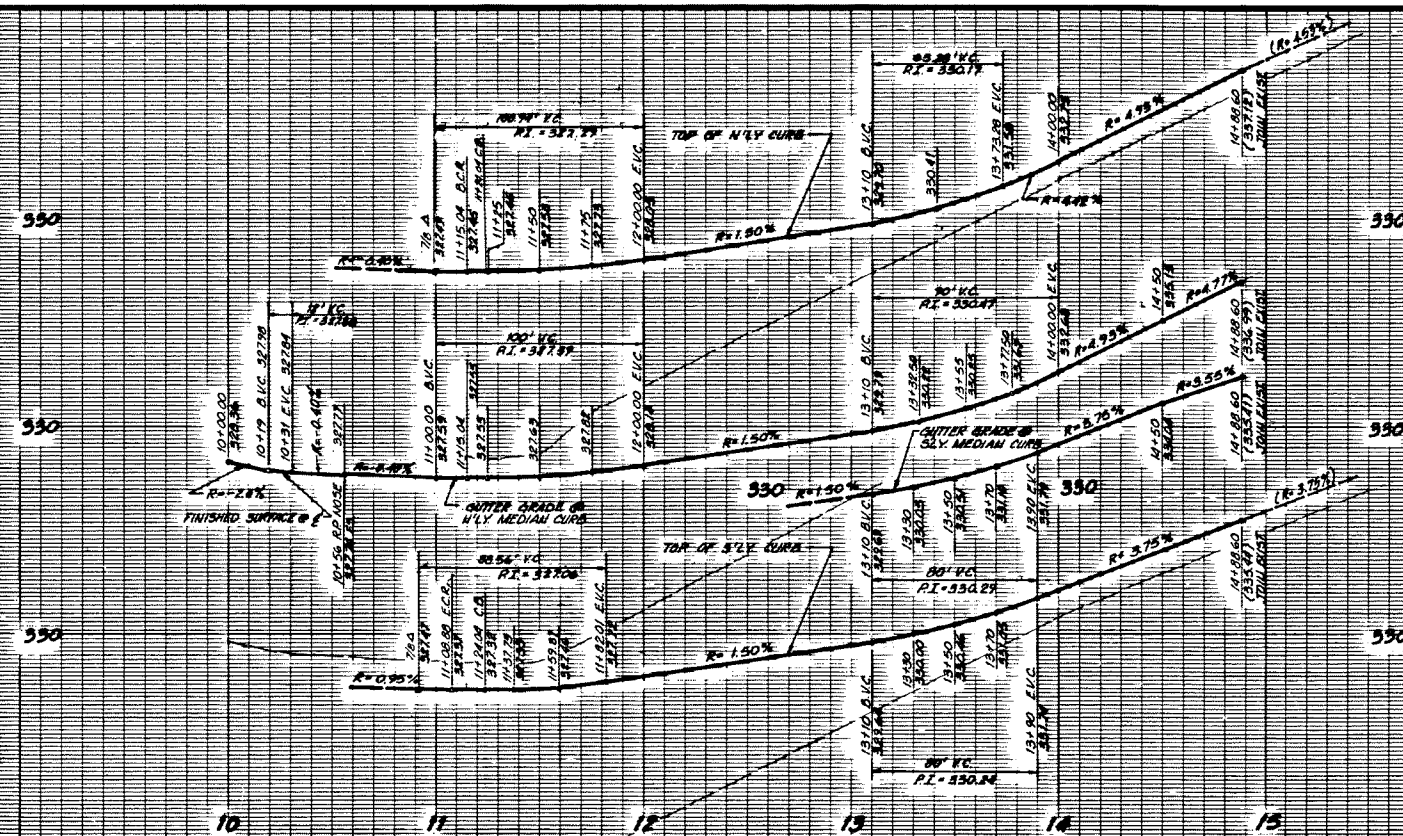

SCALE  
HORIZ. 1" = 40'  
VERT. 1" = 4'



CURVE DATA

	Δ	R	L	T
A	10°01'58"	254.37'	44.88'	22.50'
B	45°41'24"	1.29'	3.00'	-

CONSTRUCTION NOTES

1. CONSTRUCT 24" AC OVER 10" AD. 3"
2. CONSTRUCT TYPE "A" CURB & GUTTER 8" C.F. PER CITY STD. DETAIL NO. 104-P.
3. CONSTRUCT MEDIAN CURB & GUTTER PER DETAIL ON PLAN NO. 14762.
4. CONSTRUCT 12" CONC. MEDIAN CURB & GUTTER PER DETAIL ON PLAN NO. 14762.

\* STRUCTURAL SECTION TO BE DETERMINED AND APPROVED PRIOR TO PLACING PAVEMENT.

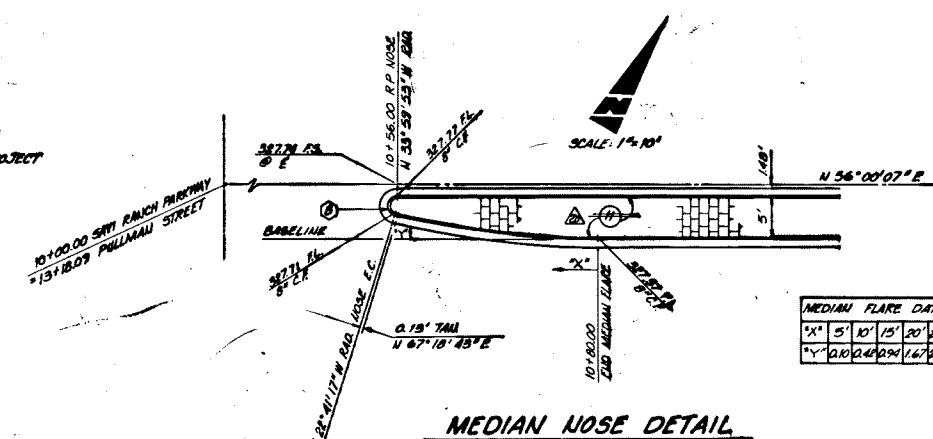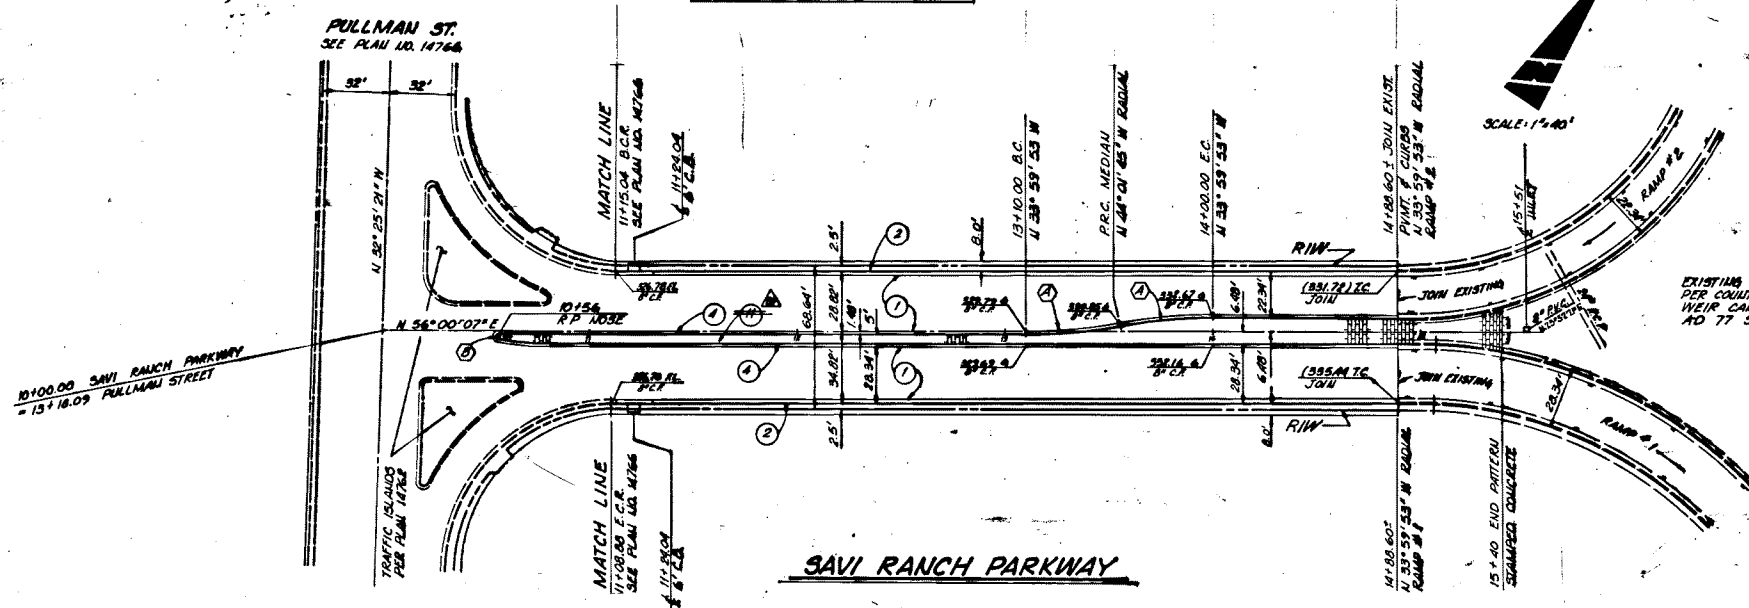

MEDIAN FLARE DATA	
X	5' 10' 15' 20' 25'
Y	0' 0' 0' 0' 0' 0' 0' 0' 0' 0'

MEDIAN NOSE DETAIL

THIS PLAN HAS BEEN EXAMINED AND IS APPROVED ONLY AS TO COMPATIBILITY WITH ADJOINING EXISTING OR FUTURE IMPROVEMENTS AND CONFORMANCE WITH CITY OF ANAHEIM STANDARD DETAILS AND THE REQUIREMENTS FOR THE FOLLOWING APPLICABLE FACTORS: RIGHT OF WAY, ROADWAY MATERIALS, ALIGNMENTS AND GRADES, HYDROLOGY AND HYDRAULICS DESIGN OF STORM DRAIN OR SANITARY SEWER SYSTEMS AND UNDERGROUND CONDUIT OR OPEN-CHANNEL ALIGNMENTS, GRADES, SIZES AND MATERIALS.

FOR GENERAL NOTES, QUANTITY ESTIMATE & KEY MAP SEE PLAN 14761

REVISIONS

NO.	DATE	INITIAL	DESCRIPTION	DATE	APPR.
1	10-15-88	R.C.H.	PER "AS BUILT"		



REFERENCES

BENCH MARK: ELEVATION 345.637 0.15 MI. W. ON WEIR CANYON RD. FROM THE RIVERSIDE HWY. TO A CONC. HDWL. ON THE WEST SIDE, 95' W. OF THE CENTERLINE OF WEIR CANYON RD. 114' S. OF THE S.A.V.I. CANYON SET IN THE TOP OF THE CONC. HDWL. - D.C.B. 1976 ADJ. 3-KK-80-71.	PLANS FOR THESE IMPROVEMENTS CITY OF ANAHEIM STD. DTLs. STREET 14761-14766, 14772, 14773 SEWER 14774-14777 STORM DRAIN 14761, 14767-14771
APPR. ELECTRICAL ENGINEERING MANAGER DATE	APPR. WATER ENGINEERING MANAGER DATE

SCALE: PREPARED UNDER THE SUPERVISION OF R.C.H. NO. 14762 RECOMMEND APPROVAL DEPUTY CITY ENGINEER APPROVED CITY ENGINEER	DATE 10-15-88 8-25-88 3-25-88
--	--


STREET IMPROVEMENTS  
**SAVI RANCH PARKWAY**  
FROM 490'± NE'LY OF TO PULLMAN STREET  
**CITY OF ANAHEIM**

AS-BUILT:  
OCT 30 1984  
SP 1556  
SHEET 4 OF 14  
14764  
PLAN NUMBER

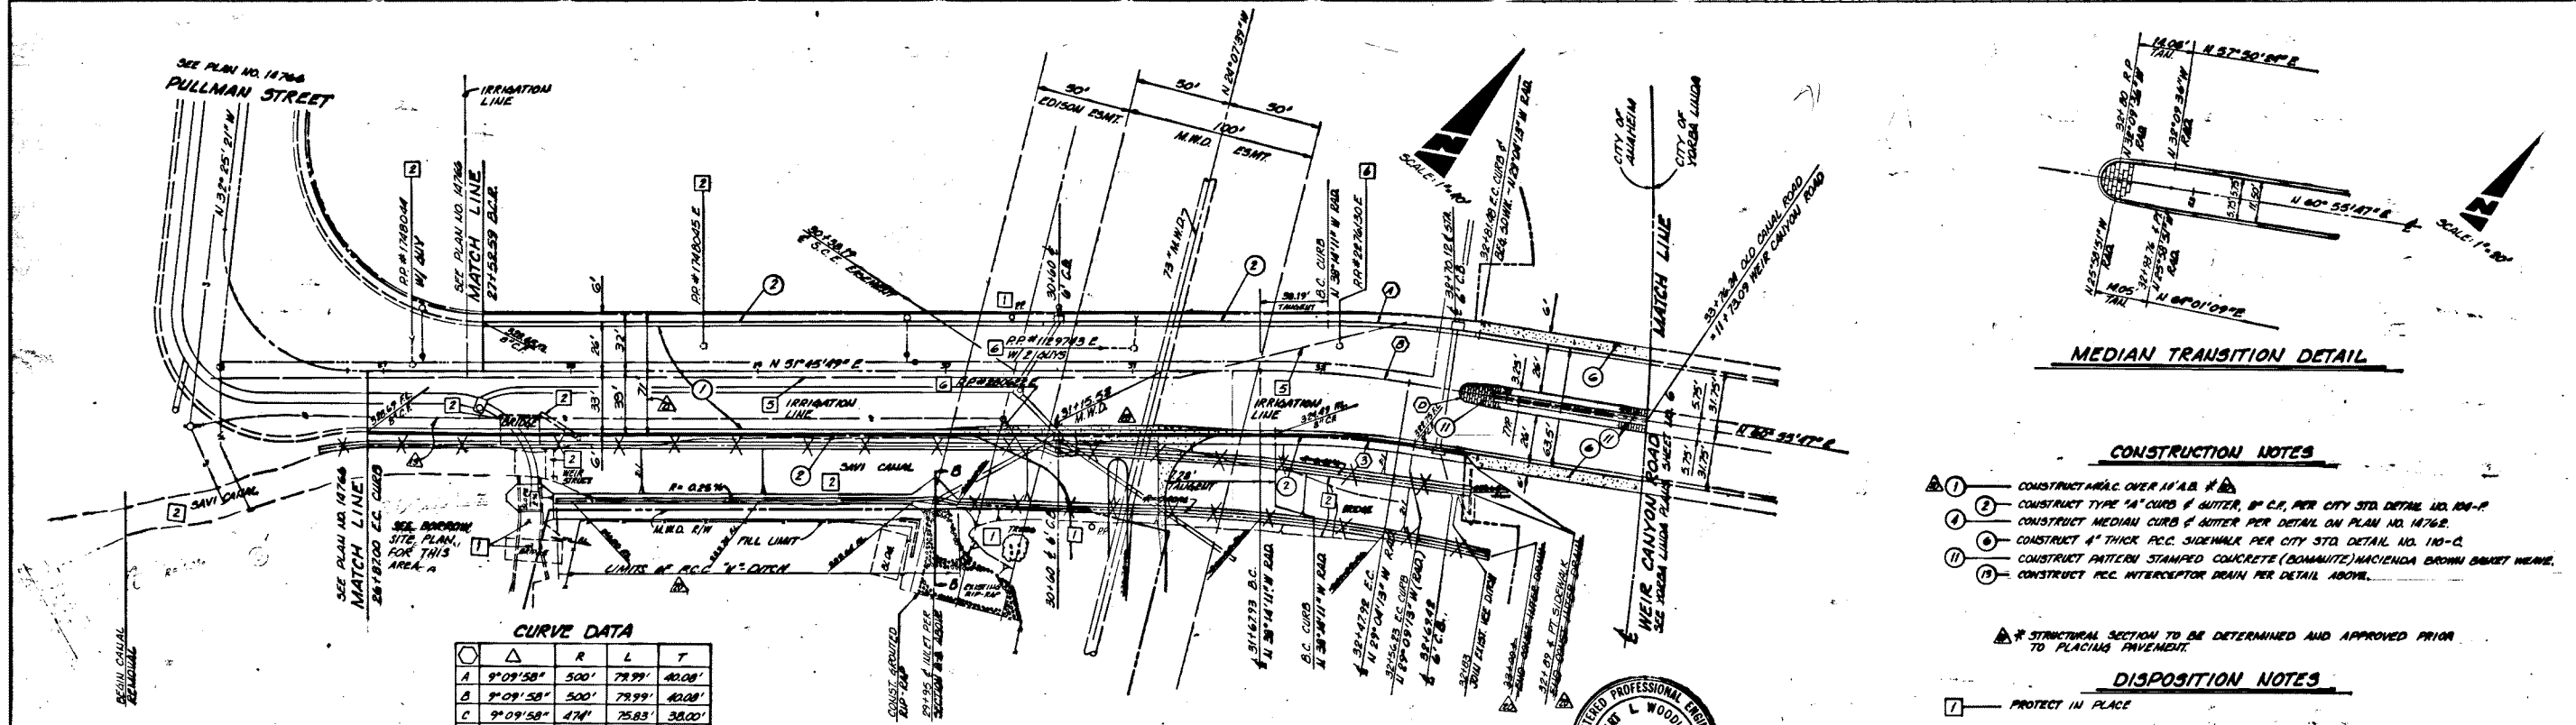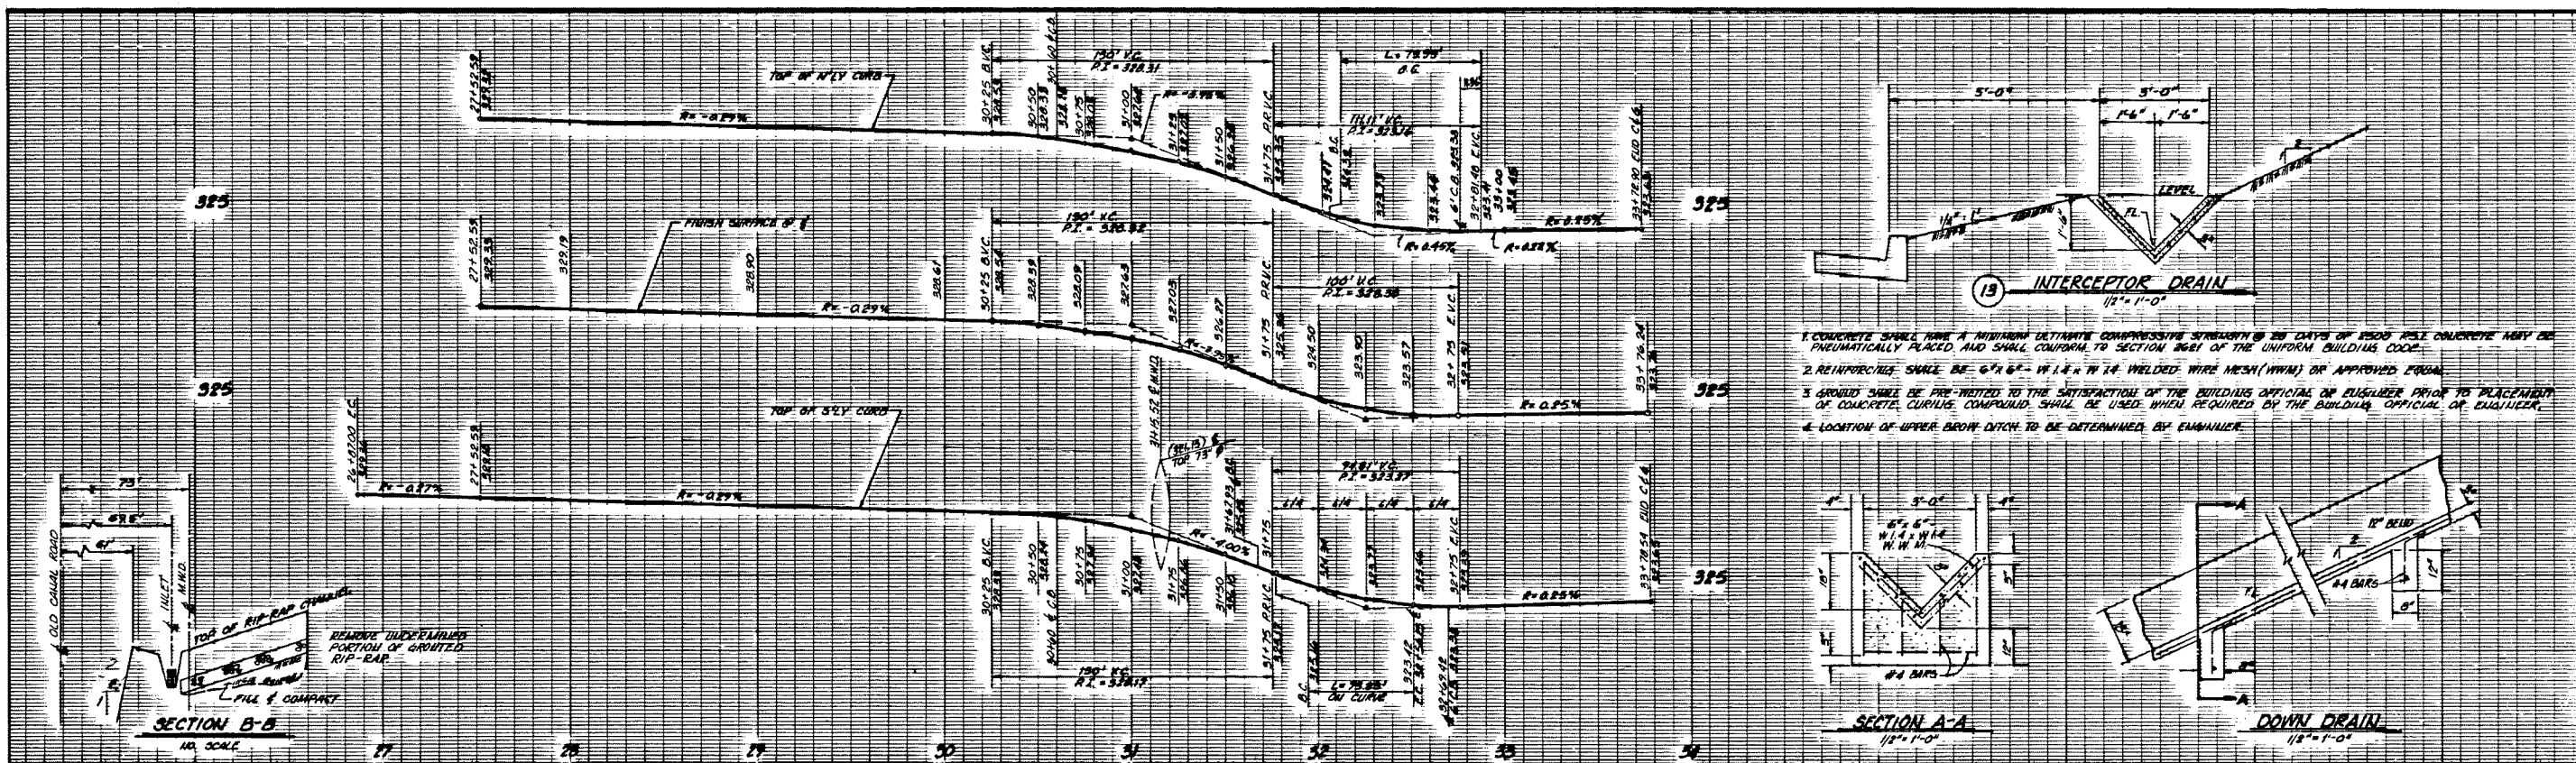

THIS PLAN HAS BEEN EXAMINED AND IS APPROVED ONLY AS TO COMPATIBILITY WITH ADJOINING EXISTING OR FUTURE IMPROVEMENTS AND CONFORMANCE WITH CITY OF ANAHEIM STANDARD DETAILS AND THE REQUIREMENTS FOR THE FOLLOWING APPLICABLE FACTORS: RIGHT OF WAY, ROADWAY MATERIALS, ALIGNMENTS AND GRADES, HYDROLOGY AND HYDRAULICS DESIGN OF STORM DRAIN OR SANITARY SEWER SYSTEMS AND UNDERGROUND CONDUIT OR OPEN-CHANNEL ALIGNMENTS, GRADES, SIZES AND MATERIALS.		D 175° 49' 15" S 5' 15.17' E —		OLD CANAL ROAD		REGISTERED PROFESSIONAL ENGINEER No. C33708 EXP. 6-30-90 CIVIL STATE OF CALIFORNIA		2 — REMOVE 3 — EXCAVATE AND CRUSH IN PLACE EXISTING IRRIGATION SYSTEM 6 — TO BE RELOCATED BY OTHERS		AS-BUILT OCT 30 1984									
FOR GENERAL NOTES, QUANTITY ESTIMATE & KEY MAP SEE PLAN 14761																			
REVISIONS				REFERENCES								SCALE: PREPARED UNDER THE SUPERVISION OF R.C.E. NO. 37-100 RECOMMEND APPROVAL CITY ENGINEER 5-22-88 APPROVED CITY ENGINEER 3-26-88		DATE 10-15-84		STREET IMPROVEMENTS OLD CANAL ROAD FROM WEIR CANYON ROAD TO PULLMAN STREET		SP 1556 SHEET 5 OF 14	
NO.	DATE	INITIAL	DESCRIPTION	DATE	APPR.	BENCH MARK: ELEVATION 345.697 0.15 MI. N.W. ON WEIR CANYON RD. FROM THE RIVERSIDE HWY TO A CONC. HDWL. ON THE WESTSIDE, 95' W. OF THE CENTERLINE OF WEIR CANYON RD. 14" S. OF THE S.A.V.I. CANAL, SET IN THE TOP OF THE CONC. HDWL. C.C.S. 17% ADJ. 345.697	PLANS FOR THESE IMPROVEMENTS CITY OF ANAHEIM STD. DTLs. STREET 14761-14766, 14772, 14773 SEWER 14774-14777 STORM DRAIN 14761, 14767-14771		APPR. ELECTRICAL ENGINEERING MANAGER DATE		APPR. WATER ENGINEERING MANAGER DATE		CITY OF ANAHEIM		14765 PLAN NUMBER				
1	5-16-84	L.S.	ADDED 8" R.C.P. SEWER LINE PER 70' ADJ.																
2	8-31-84	M.C.W.	PER CITY OF ANAHEIM PLAN CHECK																
3	8-10-87	M.F.S.																	




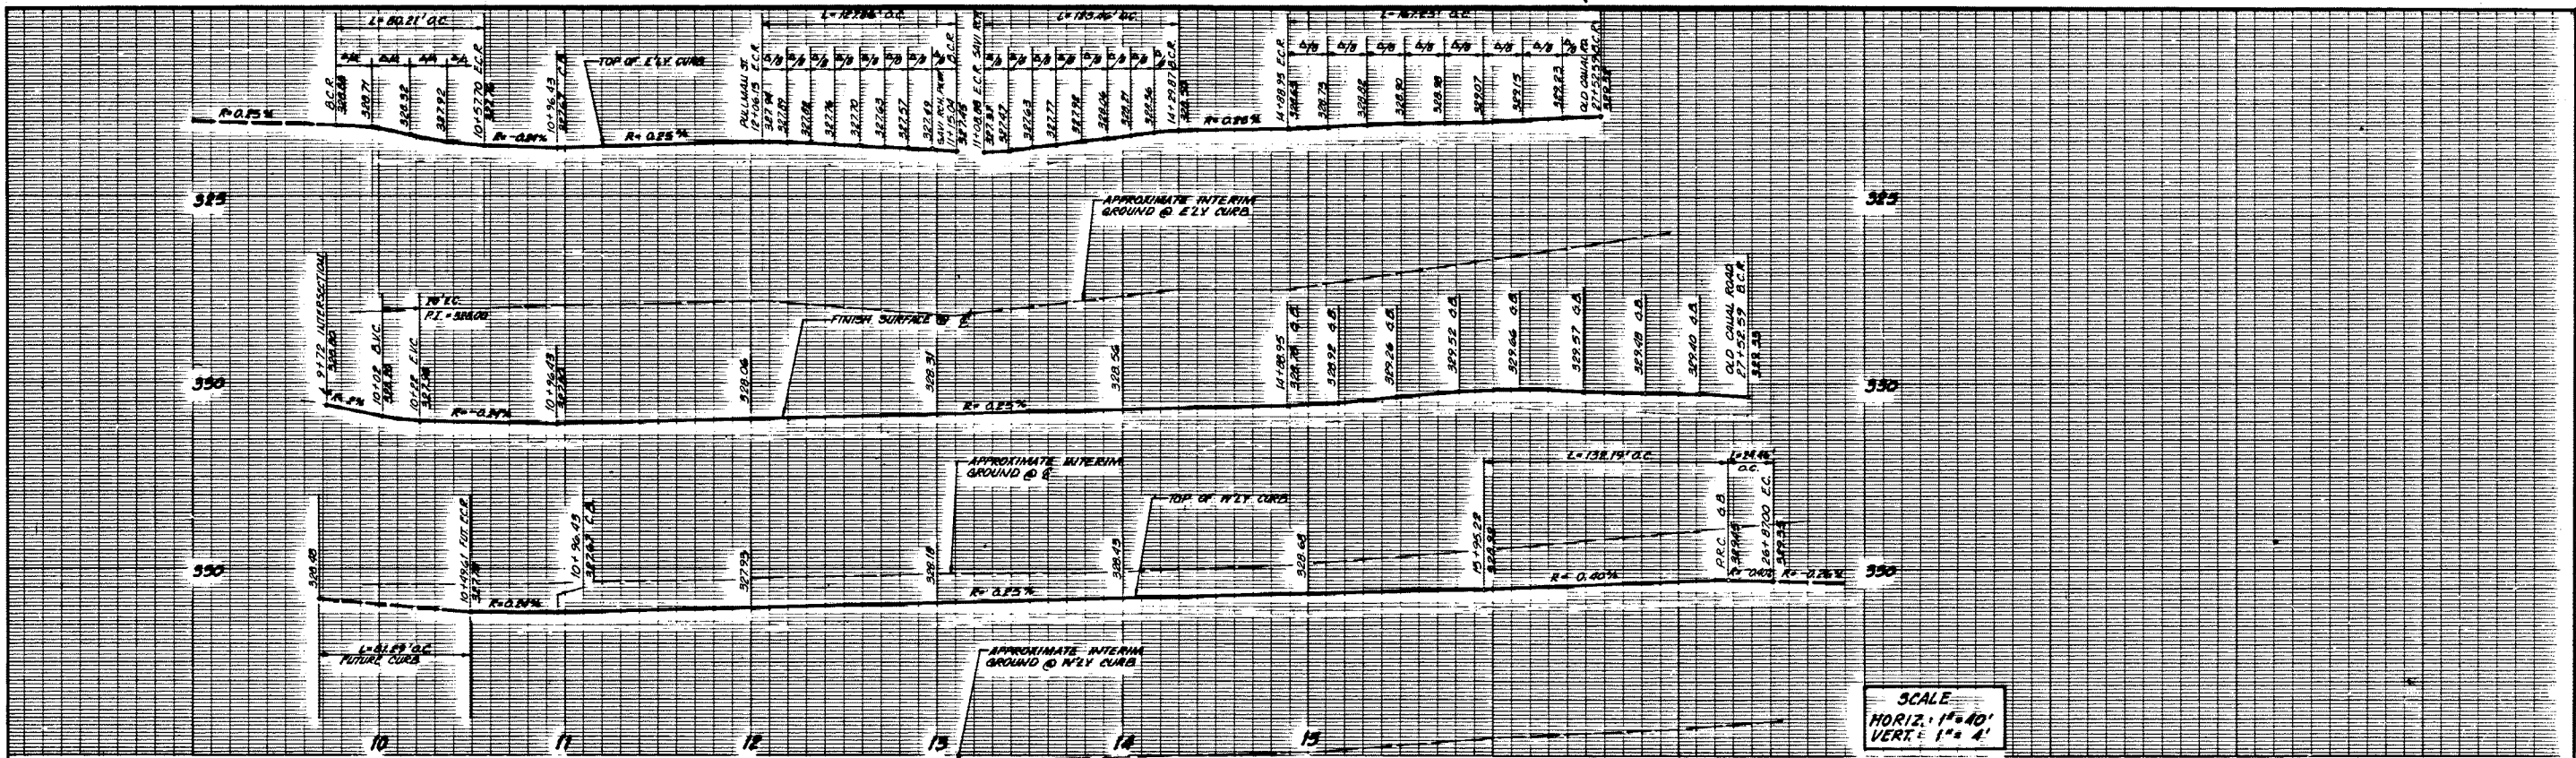

SCALE  
HORIZ. 1"=40'  
VERT. 1"=4'

#### CONSTRUCTION NOTES

1. CONSTRUCT A.R.C. OVER 10' A.B. # 10
  2. CONSTRUCT TYPE "A" CURB & GUTTER, 8" C.P., PER CITY STD. DETAIL NO. 104-P
  3. CONSTRUCT STD. METAL DRAIN GUARD-RAILING-PER-CITY-STD-DETAIL-NO-100
  4. CONSTRUCT CURB DEPRESSION FOR SIDEWALK ACCESS RAMPS PER CITY STD. DETAIL NO. 104-G
  5. INSTALL STREET NAME SIGNS PER CITY STD. DETAIL NO. 107
  6. CONSTRUCT TYPE "B" CURB, VARY "C.S." TO "S", PER CITY STD. DET. NO. 104-101
  7. CONSTRUCT, 6" THICK R.C.C.
- \* STRUCTURAL SECTION TO BE DETERMINED AND APPROVED PRIOR TO PLACING PAVEMENT.

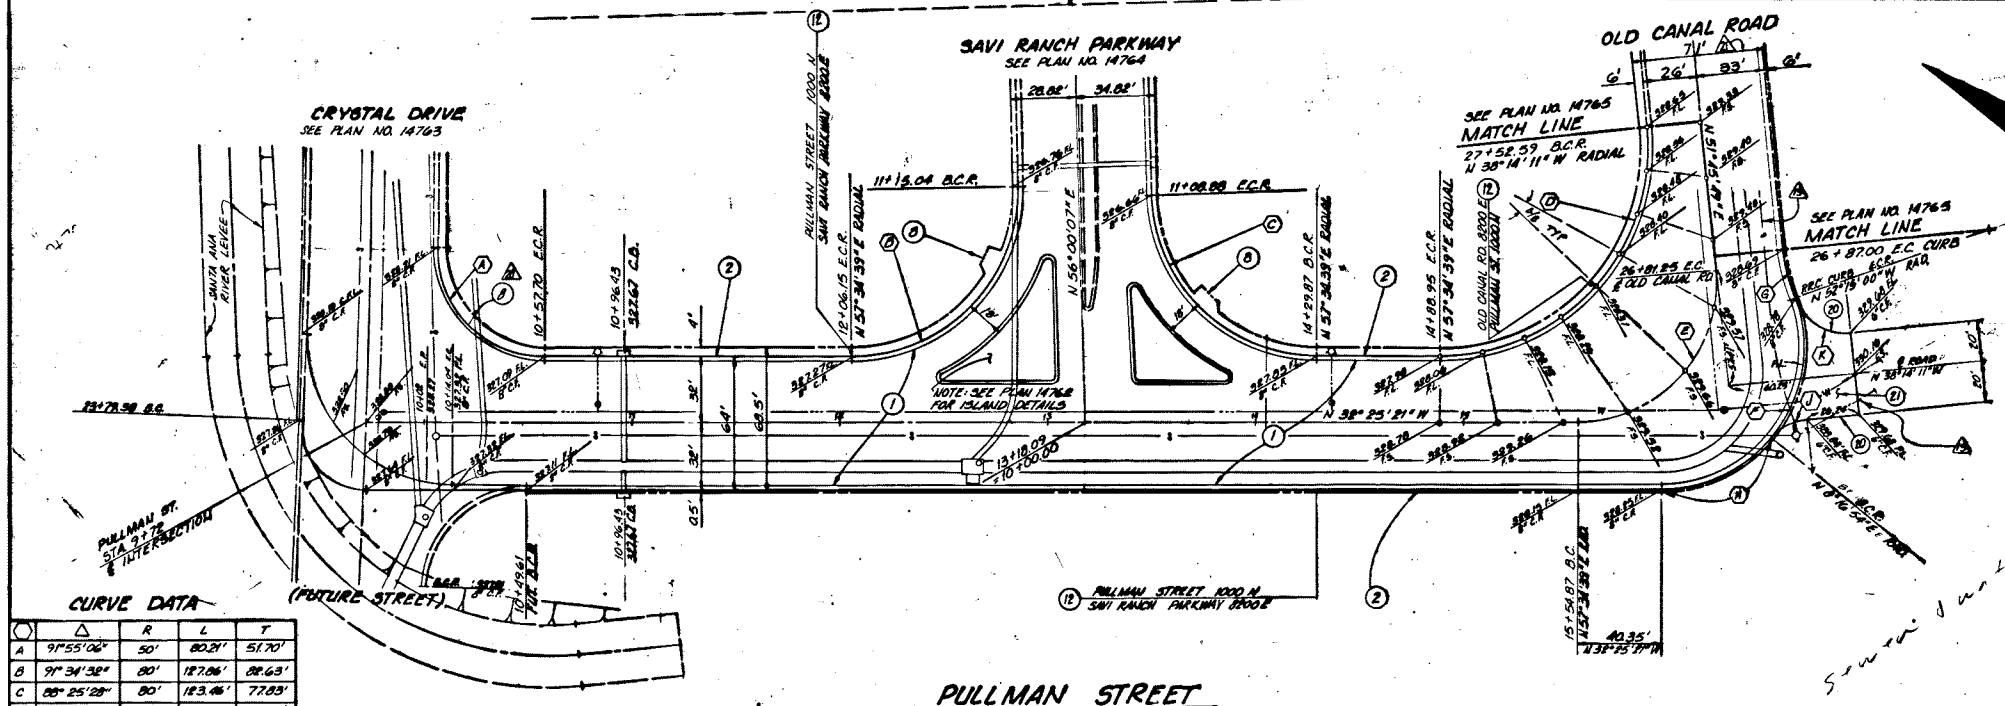

NO.	DATE	INITIAL	DESCRIPTION	DATE	APPR.
1	5-15-84	L.A.S.	ADDED 8" R.C.P. SEWER LINE		
2	8-30-84	K.C.N.	PER 75' BUILT		
3	8-10-87	MPS	PER CITY OF ANAHEIM PLAN CHECK		

NO.	DATE	INITIAL	DESCRIPTION	DATE	APPR.
1	5-15-84	L.A.S.	ADDED 8" R.C.P. SEWER LINE		
2	8-30-84	K.C.N.	PER 75' BUILT		

#### REFERENCES

FOR GENERAL NOTES, QUANTITY ESTIMATE & KEY MAP SEE PLAN M764

BENCH MARK: ELEVATION 345.897  
0.15 MI. NW ON WEIR CANYON RD. FROM THE RIVERSIDE HWY TO A CONC. HDWL. ON THE WEST SIDE, 95' W. OF THE CENTERLINE OF WEIR CANYON RD., 1/4" S. OF THE S.A.V.I. CANAL, SET IN THE TOP OF THE CONC. HDWL. - O.C.B. 1976 ADJ. SKR-20-71

PLANS FOR THESE IMPROVEMENTS CITY OF ANAHEIM STD. DTLS.  
STREET 14761-14766, 14772, 14773  
SEWER 14774-14777  
STORM DRAIN 14761, 14767-14771

APPR. ELECTRICAL ENGINEERING MANAGER  
DATE 8-22-88


APPR. WATER ENGINEERING MANAGER  
DATE 8-22-88

SCALE: PREPARED UNDER THE SUPERVISION OF  
R.C.E. NO. 33706  
RECOMMEND APPROVAL  
DEPUTY CITY ENGINEER  
APPROVED: 8-22-88  
CITY ENGINEER

STREET IMPROVEMENTS  
**PULLMAN STREET**  
FROM CRYSTAL DRIVE TO OLD CANAL ROAD  
**CITY OF ANAHEIM**

AS-BUILT  
OCT 30 1984  
SP 1556  
SHEET 6 OF 14  
14766  
PLAN NUMBER



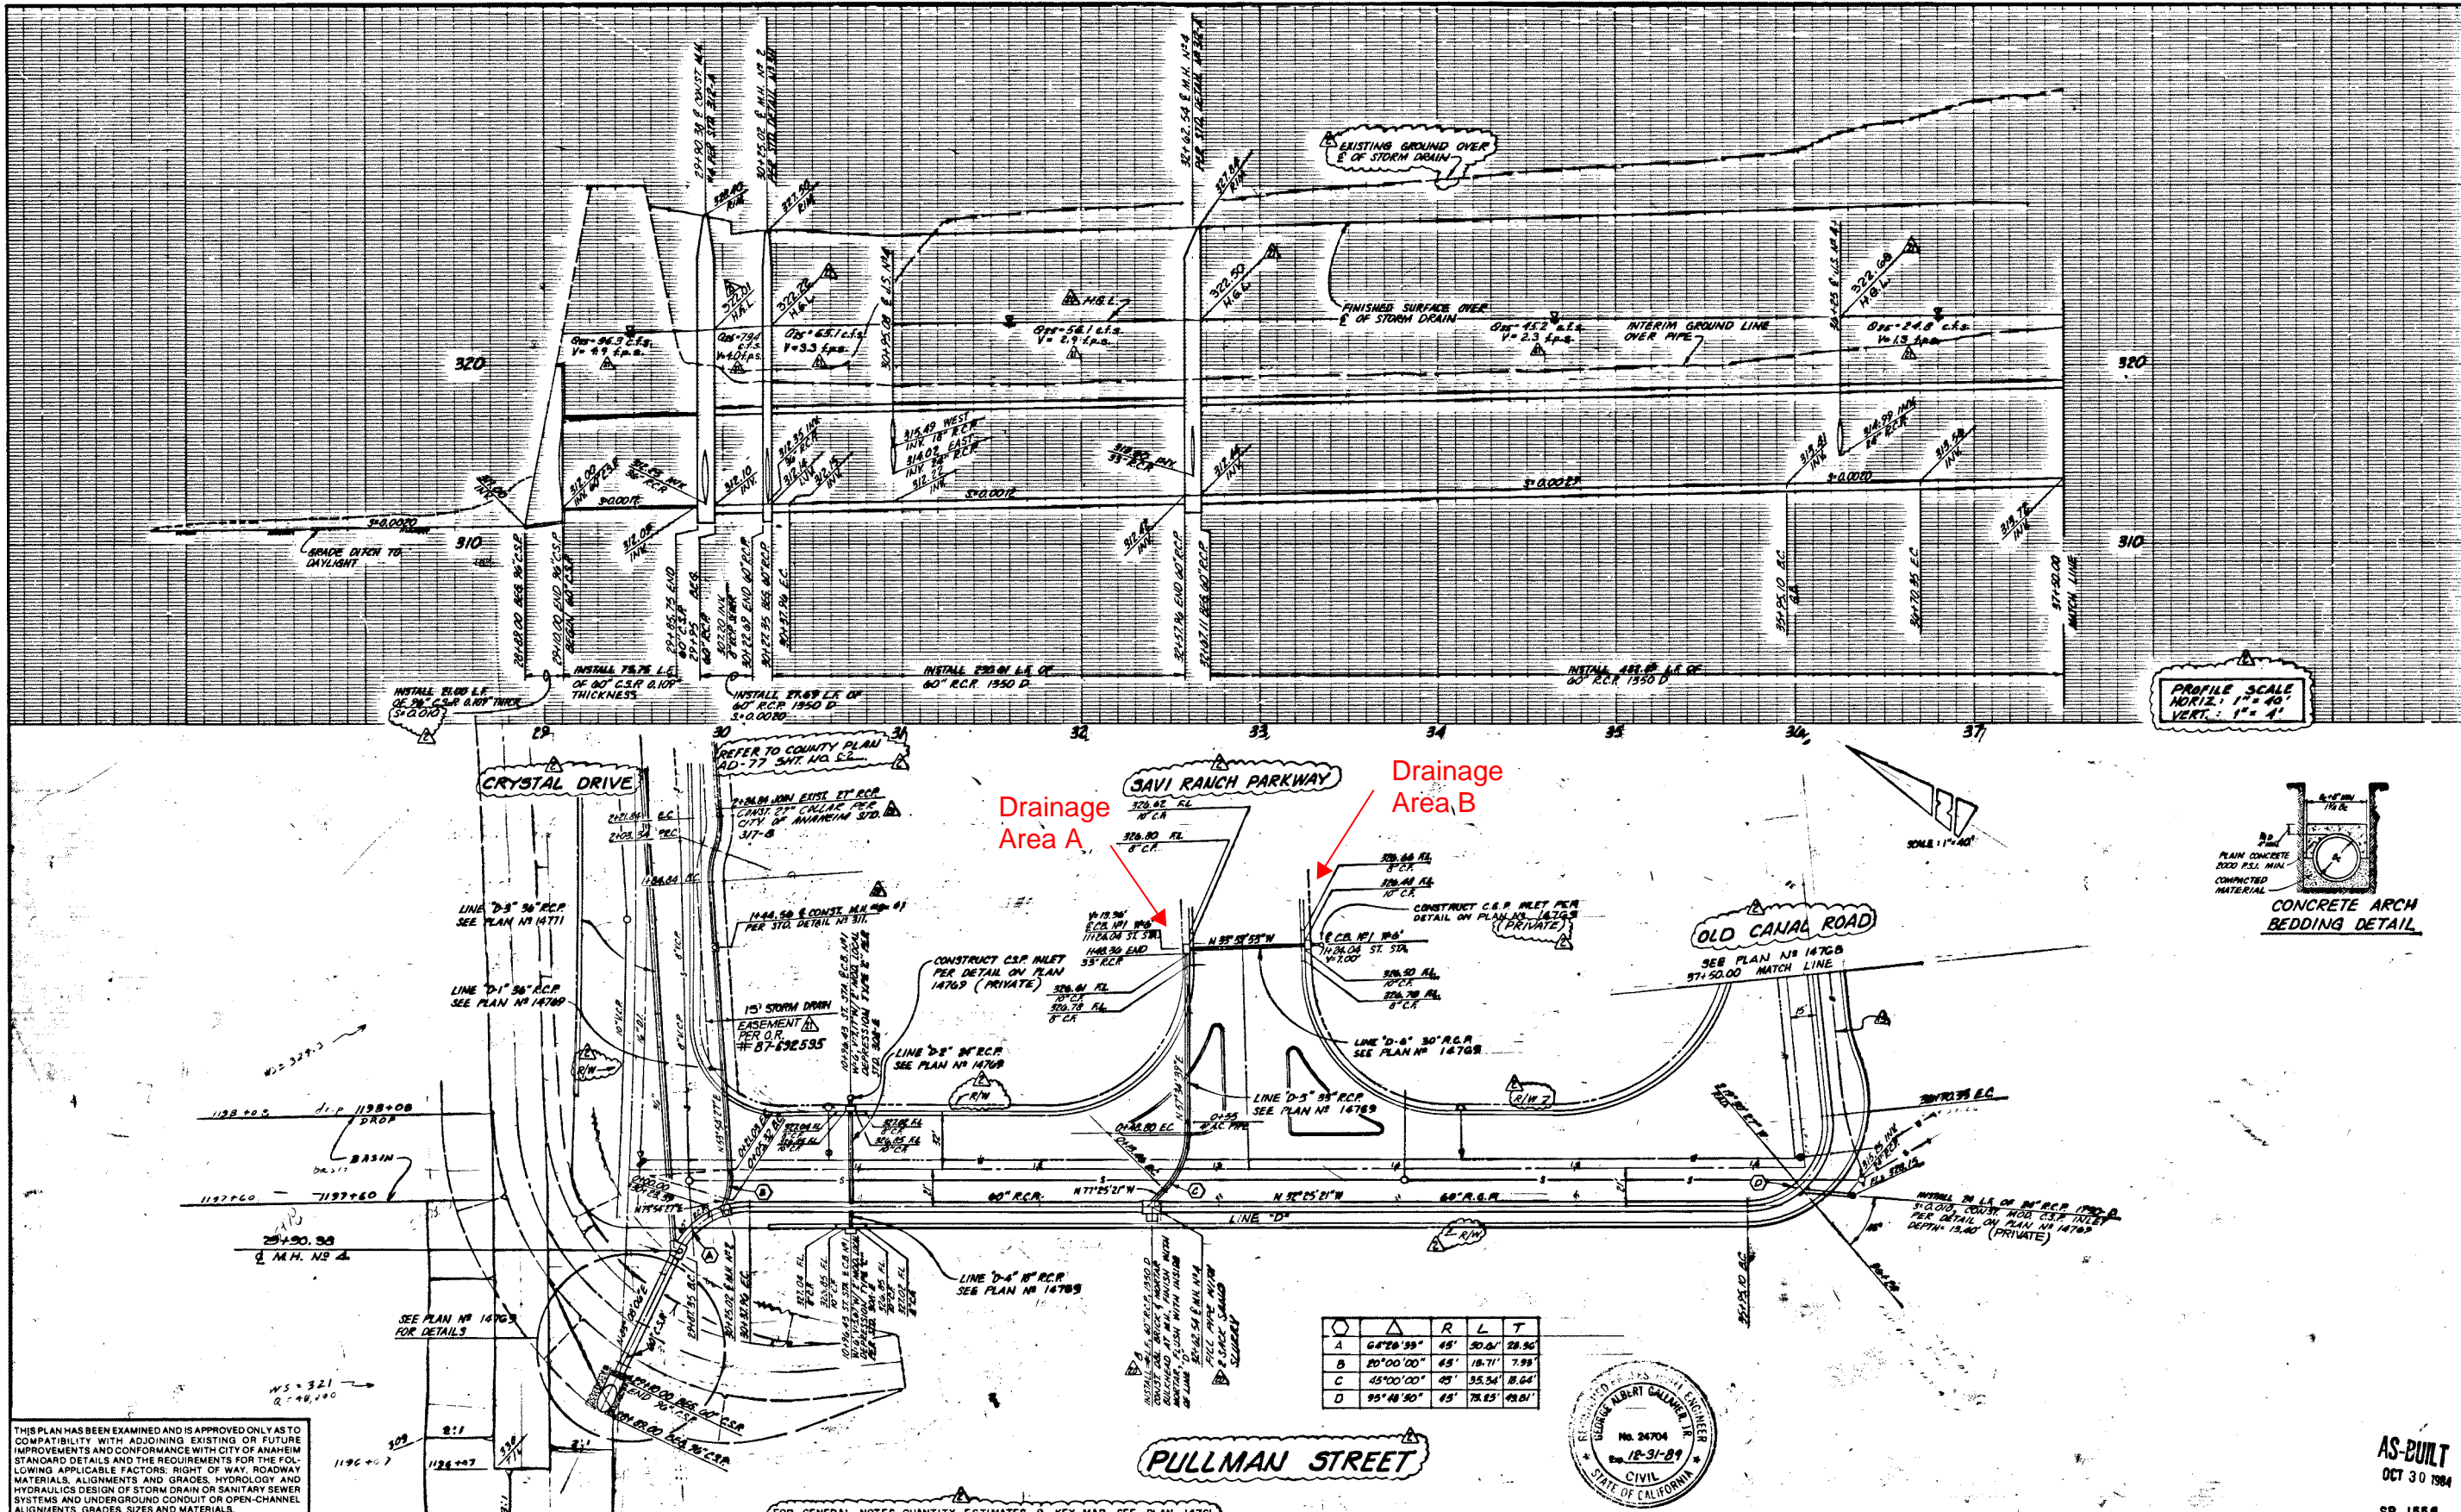

THIS PLAN HAS BEEN EXAMINED AND IS APPROVED ONLY AS TO COMPATIBILITY WITH ADJOINING EXISTING OR FUTURE IMPROVEMENTS AND CONFORMANCE WITH CITY OF ANAHEIM STANDARD DETAILS AND THE REQUIREMENTS FOR THE FOLLOWING APPLICABLE FACTORS: RIGHT OF WAY, ROADWAY MATERIALS, ALIGNMENTS AND GRADES, HYDROLOGY AND HYDRAULICS DESIGN OF STORM DRAIN OR SANITARY SEWER SYSTEMS AND UNDERGROUND CONDUIT OR OPEN-CHANNEL ALIGNMENTS, GRADES, SIZES AND MATERIALS.

REVISIONS

NO.	DATE	INITIAL	DESCRIPTION
1	6-27-85	NSH	CHANGE PER CITY OF ANAHEIM
2	6-16-84	L.A.S.	ADDED 8" V.C.P. SEWER LINE
3	8-30-84	N.C.M.	PER "AS BUILT"
4	1-19-87	H.C.C.	PER CITY OF ANAHEIM PLAN CHECK

REFERENCES

BENCH MARK: EL. 345.697 0.15 MI. N.W. ON WHITE CANYON RD., FROM THE RIVERSIDE HWY TO A CONC. HORN. ON THE WEST SIDE, 95' N. OF THE CENTERLINE OF WHITE CANYON RD., 14.1' S. OF THE SAKI CANAL, SET IN THE TOP OF THE CONC. HORN.	PLANS FOR THESE IMPROVEMENTS CITY OF ANAHEIM STD. DTLS. STREET 14701-14706, 14772, 14773 SEWER 14774-14777 STORM DRAIN 14701, 14707-14771 HORN - D.C.S. 0776 ADJ. 30-71	APPR. ELECTRICAL ENGINEERING MANAGER DATE	APPR. WATER ENGINEERING MANAGER DATE
---	---	--	---



	R	L	T
A	64°29'55"	45'	30.6'
B	20°00'00"	45'	15.71'
C	45°00'00"	45'	35.34'
D	95°48'50"	45'	78.45'



STORM DRAIN IMPROVEMENTS  
**PULLMAN STREET**  
FROM SANTA ANA RIVER TO OLD CANAL RD.  
**CITY OF ANAHEIM**



AS-BUILT  
OCT 30 1984  
SP 1556  
SHEET 7 OF 14  
14787  
PLAN NUMBER



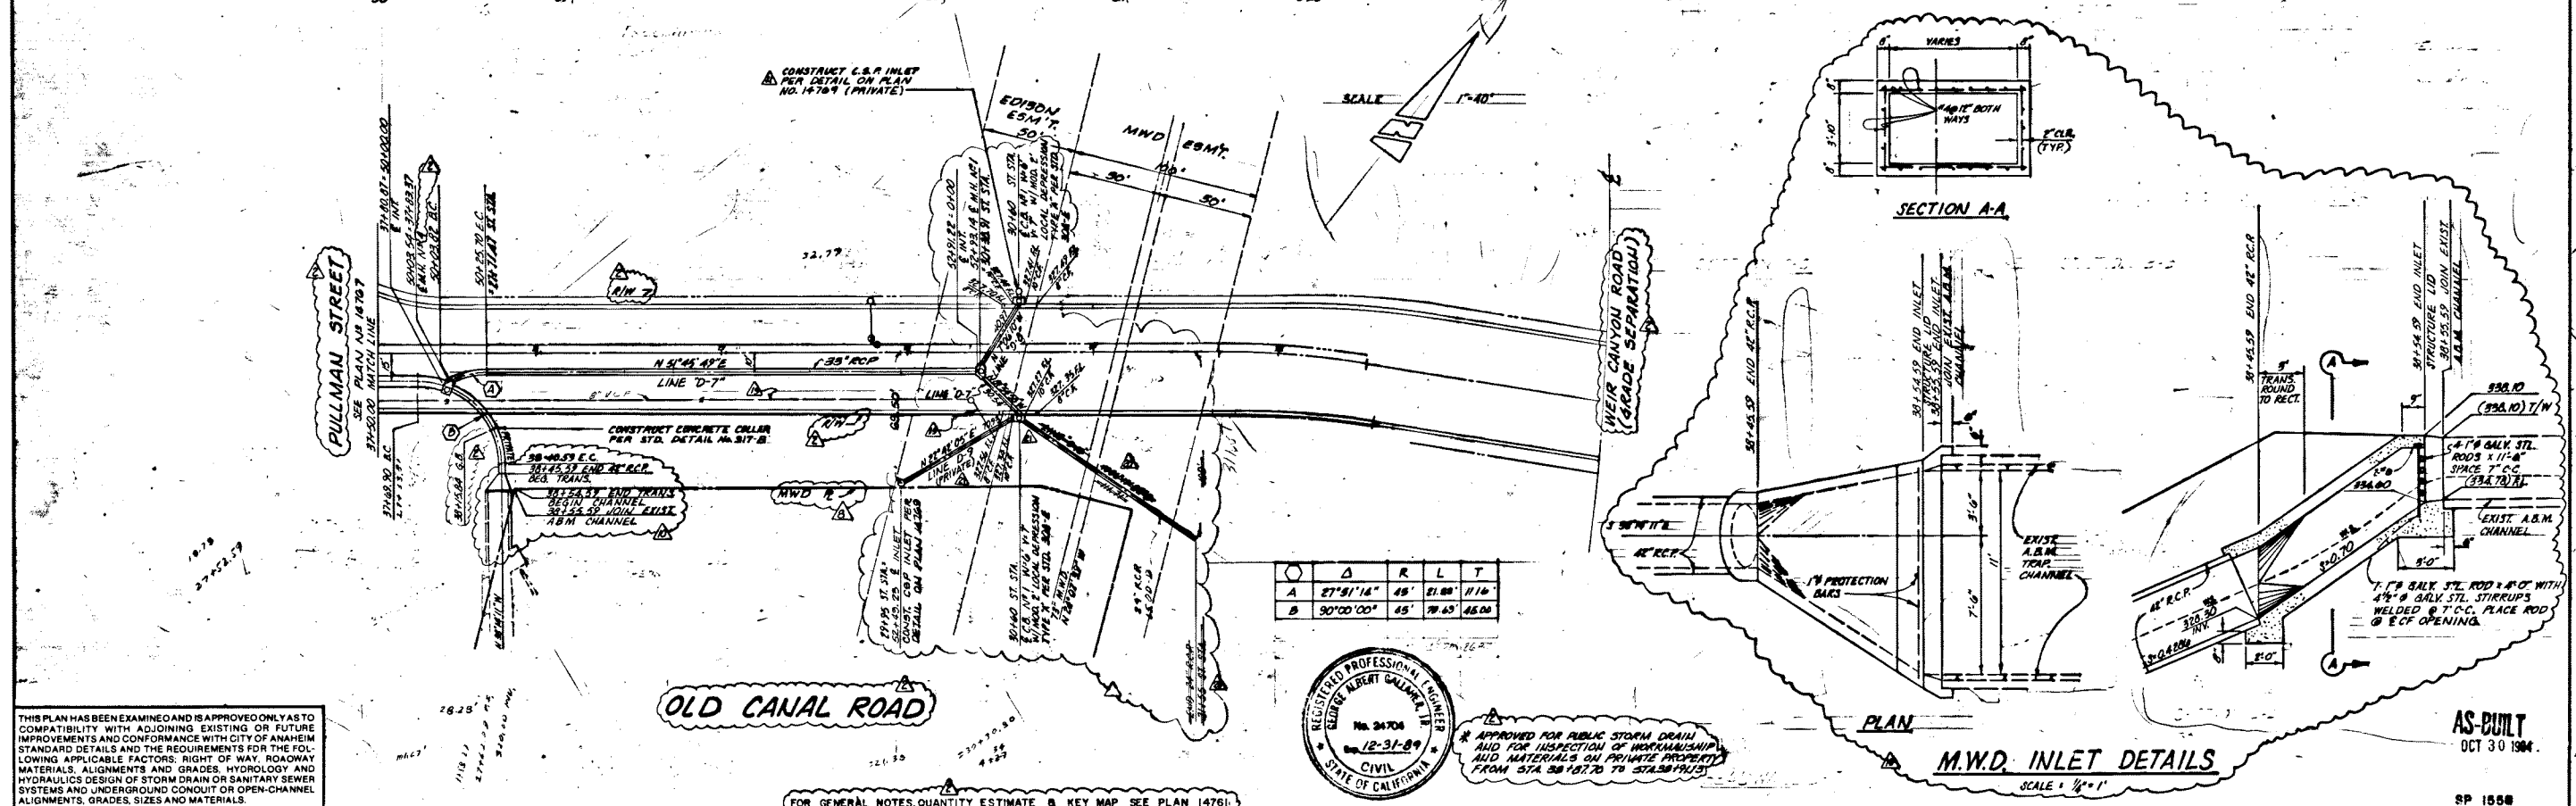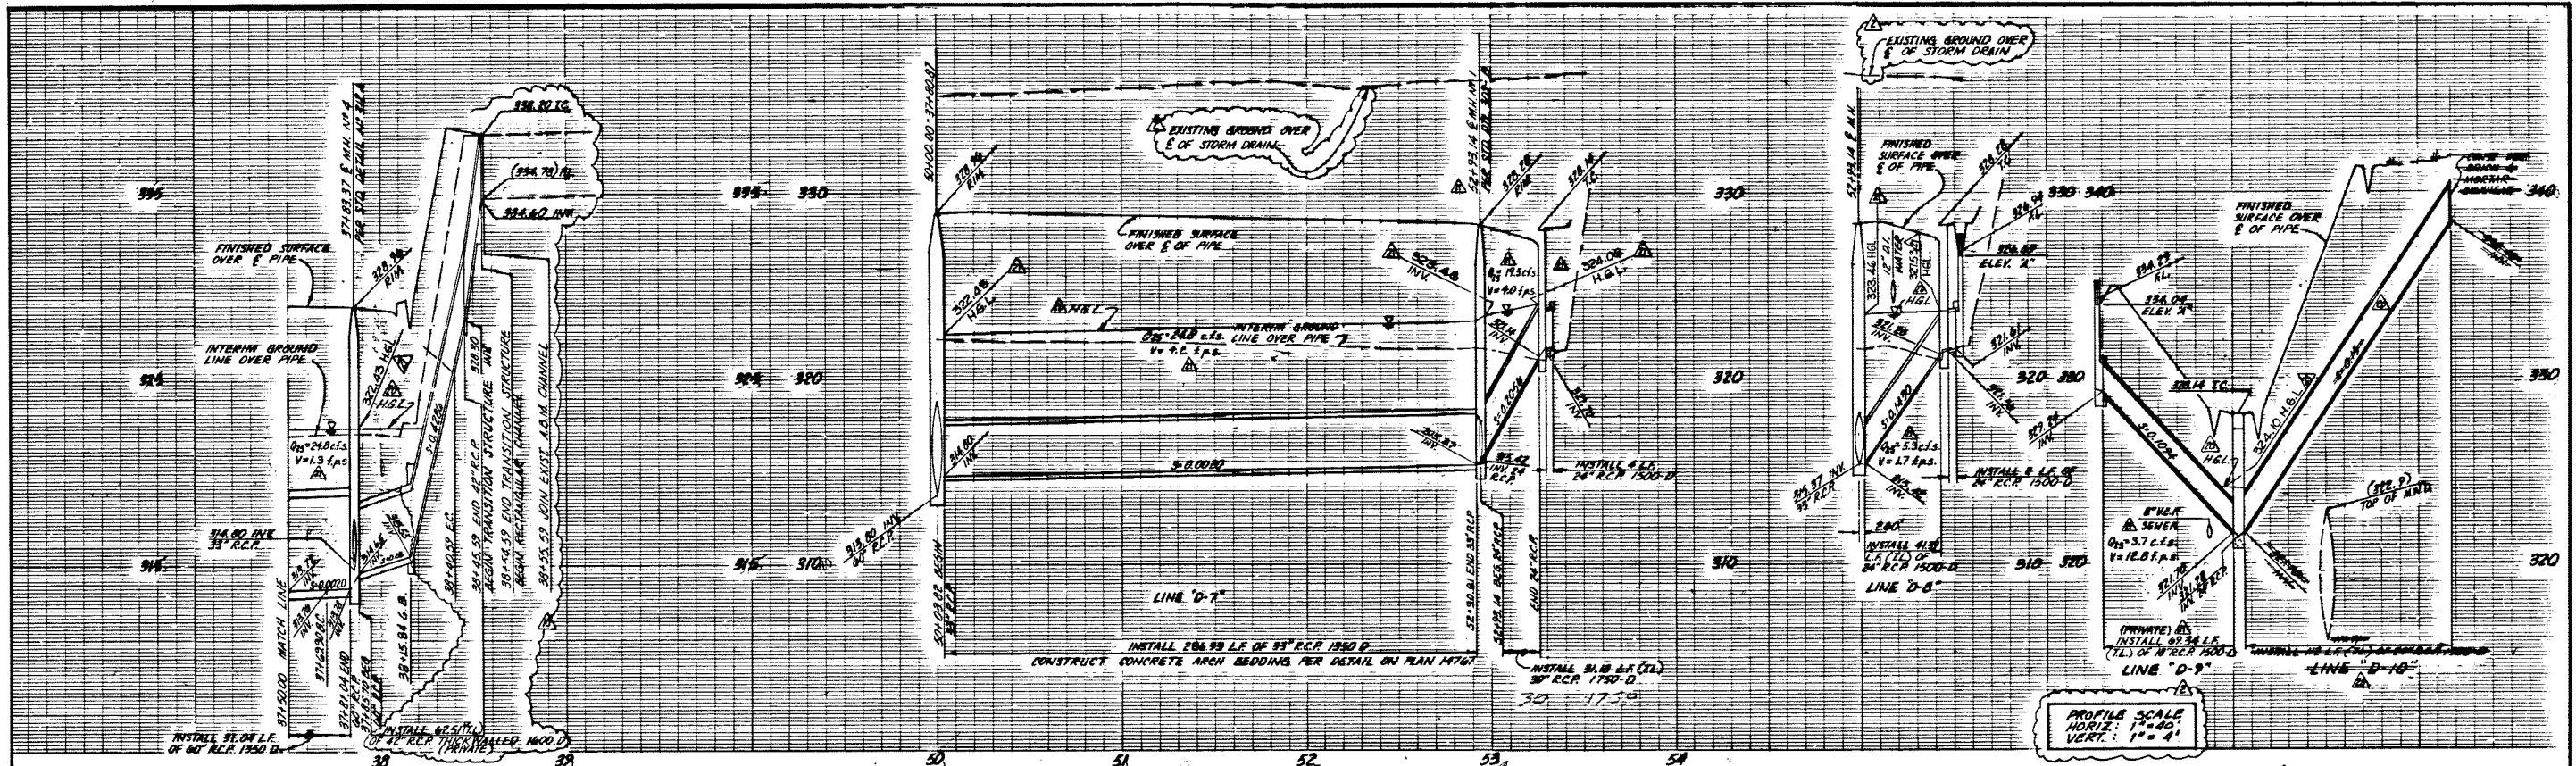

<b>REVISIONS</b> NO. DATE INITIAL DESCRIPTION 1-27-83 M.S.M. CHANGE PER CITY OF ANAHEIM 2-12-83 L.O.E. REVISED SLOPE & G.D. INLETS 3/4" OLD CANAL RD. STA 26+87 TO 32+30 3-6-83 M.S.M. REVISED M.W.D. INLET AT OLD CANAL RD. STA. 27+70 5-16-84 L.A.S. ADDED 8" V.C.P. SEWER LINE 7-2-84 H.C.M. PER "AS BUILT" 11-27-87 H.C.C. PER CITY OF ANAHEIM PLAN CHGCH		<b>REFERENCES</b> BENCH MARK: EL. 345.697 0.15 MI. W. ON WEIR CANYON RD. FROM THE RIVERSIDE Fwy TO A CONC. MON. ON THE WEST SIDE, 25' N. OF THE CENTERLINE OF WEIR CANYON RD. 14' S. OF THE 3.4% CANAL, SET IN THE TOP OF THE CONC. HPDL. G.C. 1976 ADJ. 344-20-71		PLANS FOR THESE IMPROVEMENTS CITY OF ANAHEIM STD. DTL. STREET (14761 - 14766, 14772, 14773) SEWER (14774 - 14777) STORM DRAIN (14704, 14767-14771) APPR. ELECTRICAL ENGINEERING MANAGER DATE APPR. WATER ENGINEERING MANAGER DATE		SCALE: PREPARED UNDER THE SUPERVISION OF <i>James A. Bullard</i> 5/2/79 R.C.E. NO. 24704 RECOMMEND APPROVAL <i>Arthur J. Davis</i> 3-22-88 DEPUTY CITY ENGINEER APPROVED <i>[Signature]</i> 5-22-88 CITY ENGINEER		STORM DRAIN IMPROVEMENTS <b>OLD CANAL ROAD</b> FROM 450'± NE'LY OF TO PULLMAN ST. CITY OF ANAHEIM SP 1556 SHEET 8 OF 14 14768 PLAN NUMBER	
--	--	--	--	--	--	--	--	--	--



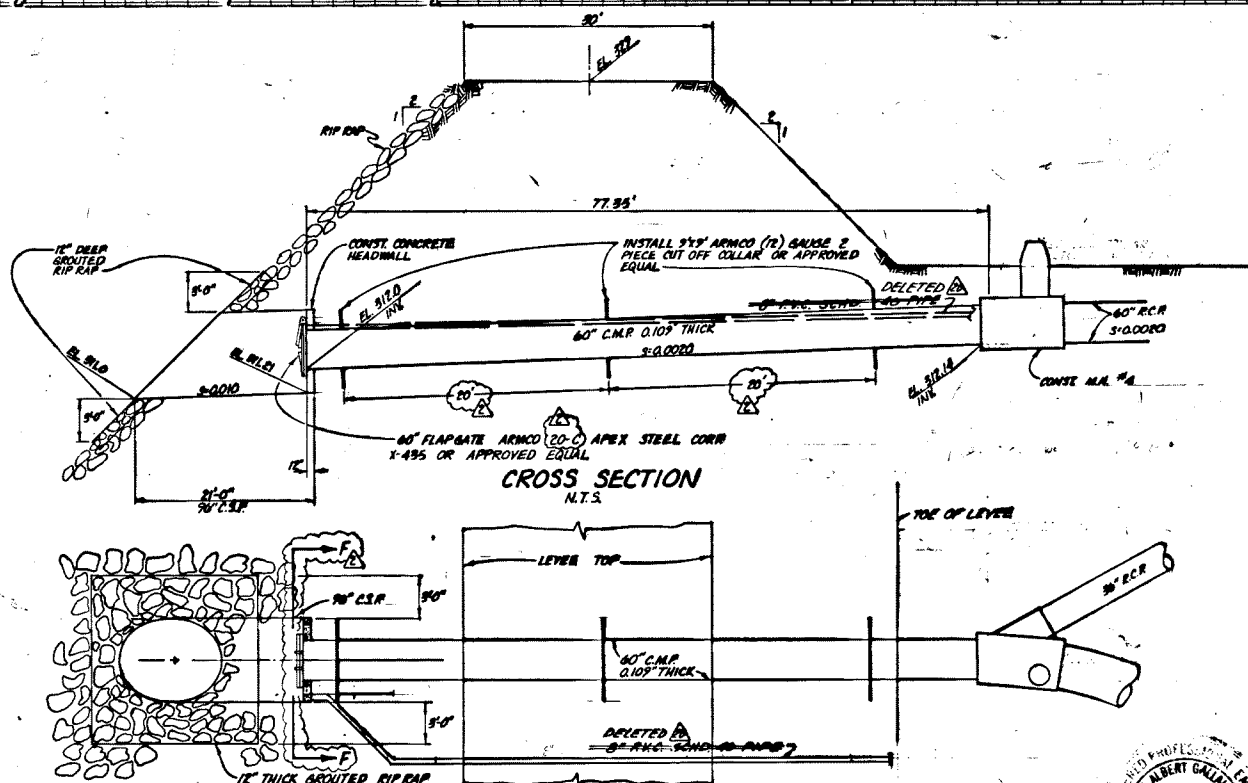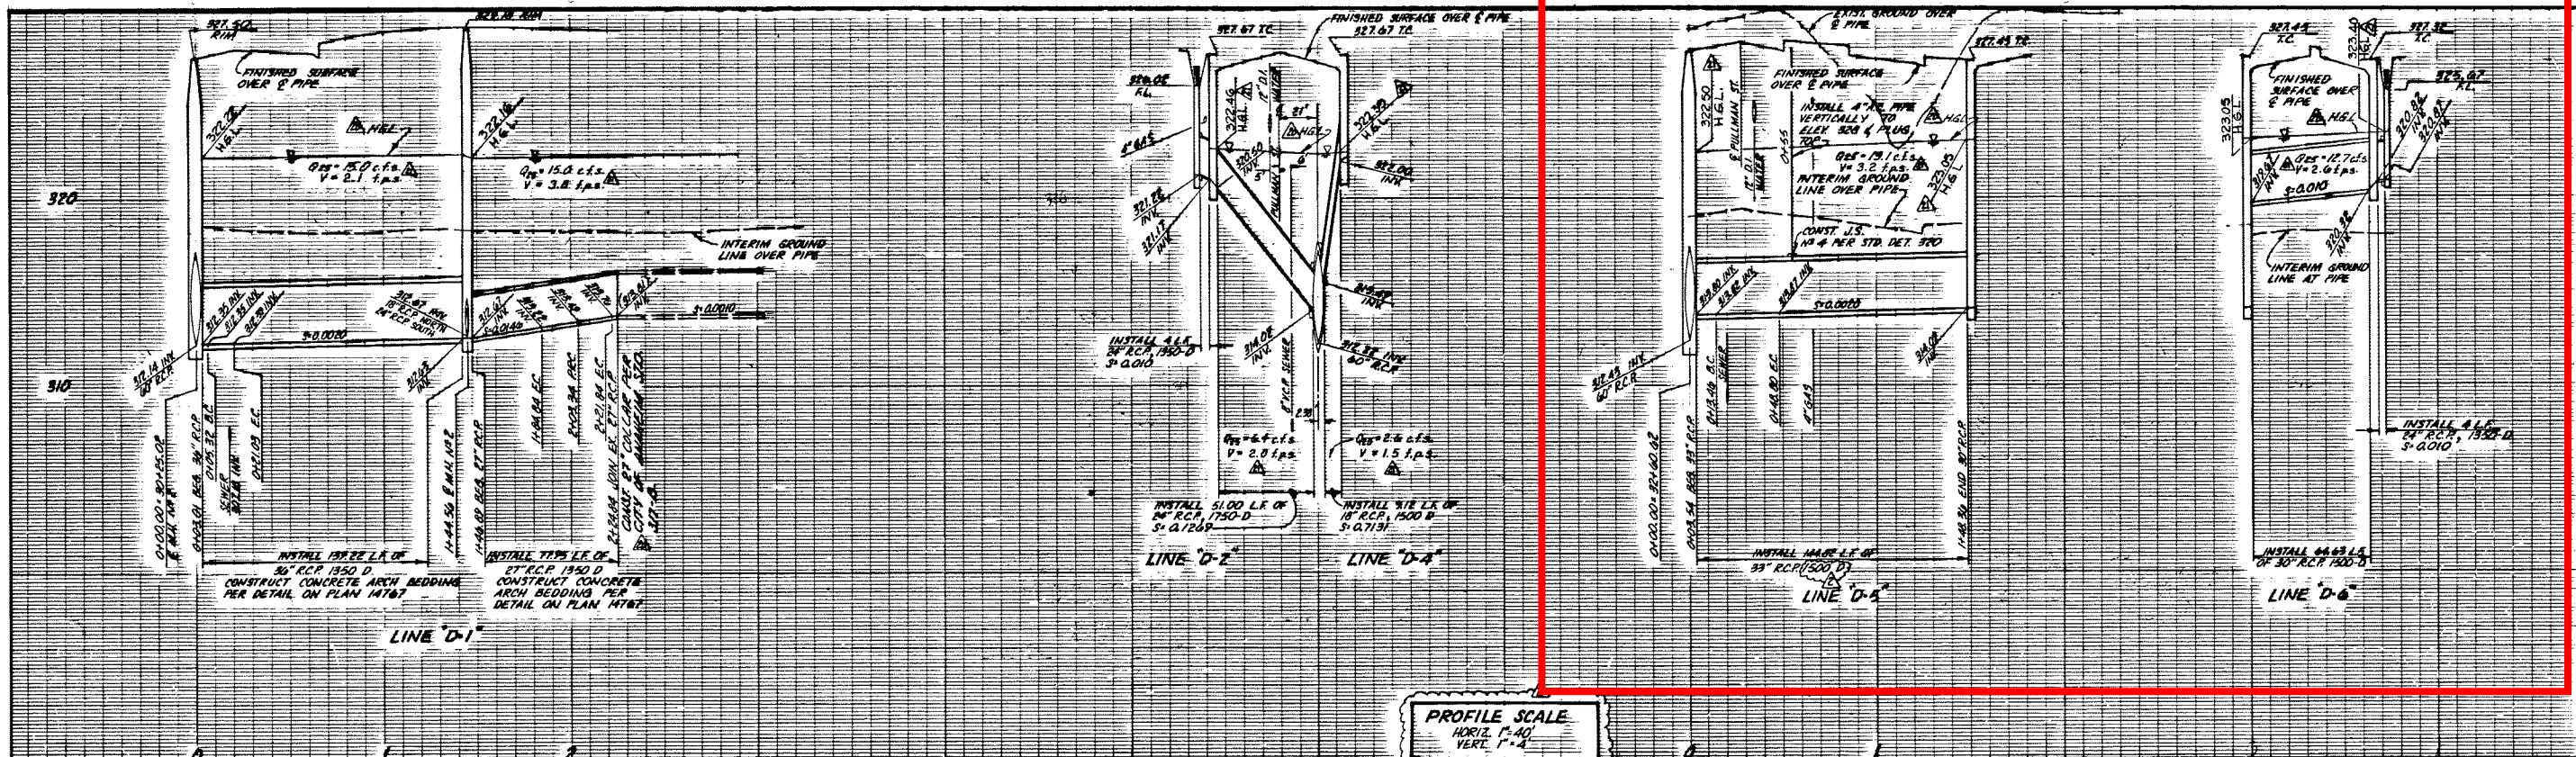

**60" C.S.P. CULVERT DETAIL**  
N.T.S.


THIS PLAN HAS BEEN EXAMINED AND IS APPROVED ONLY AS TO COMPATIBILITY WITH ADJOINING EXISTING OR FUTURE IMPROVEMENTS AND CONFORMANCE WITH CITY OF ANAHEIM STANDARD DETAILS AND THE REQUIREMENTS FOR THE FOLLOWING APPLICABLE FACTORS: RIGHT OF WAY, ROADWAY MATERIALS, ALIGNMENTS AND GRADES, HYDROLOGY AND HYDRAULICS DESIGN OF STORM DRAIN OR SANITARY SEWER SYSTEMS AND UNDERGROUND CONDUIT OR OPEN CHANNEL ALIGNMENTS, GRADES, SIZES AND MATERIALS.

REVISIONS			DESCRIPTION
NO.	DATE	INITIAL	
1	6-21-89	N.S.H.	CHANGE PER CITY OF ANAHEIM
2	10-15-89	N.S.H.	ADDED STEEL
3	10-30-89	N.C.H.	PER "AS BUILT"
4	1-19-91	N.C.C.	PER CITY OF ANAHEIM PLAN CHECK


FOR GENERAL NOTES, QUANTITY ESTIMATE & KEY MAP SEE PLAN 14767

**REFERENCES**

PLANS FOR THESE IMPROVEMENTS CITY OF ANAHEIM STD. DTL.  
STREET 14764, 14765, 14772, 14773  
SEWER 14774, 14777  
STORM DRAIN 14764, 14767, 14771  
APPR. ELECTRICAL ENGINEERING MANAGER  
DATE WATER ENGINEERING MANAGER

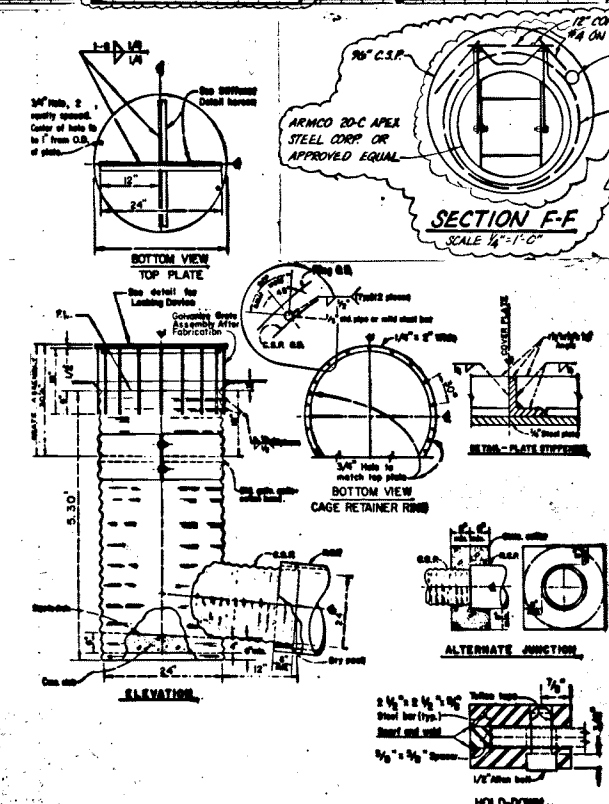

**24" CSP INLET DETAIL**  
N.T.S.

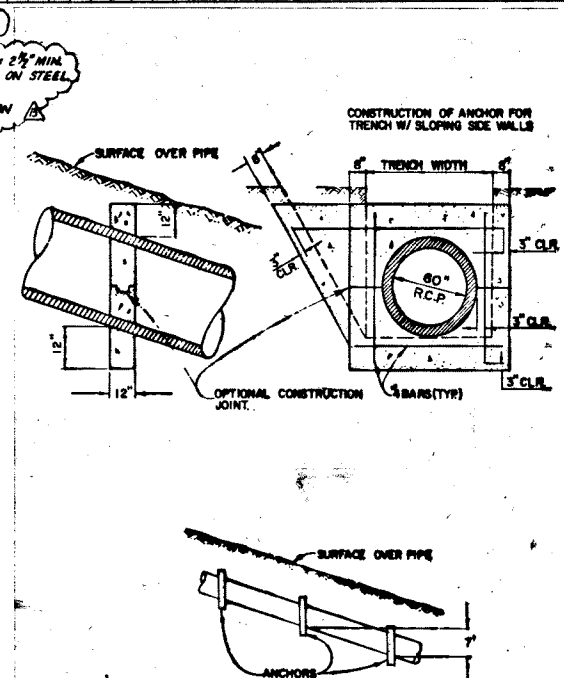

**CONCRETE PIPE SLOPE ANCHOR**  
N.T.S.

SCALE: PREPARED UNDER THE SUPERVISION OF  
R.C.E. NO. 24704  
RECOMMEND APPROVAL  
DATE 3-75-88  
CITY ENGINEER

**STORM DRAIN IMPROVEMENTS  
PROFILES AND DETAILS**

**CITY OF ANAHEIM**

AS-BUILT  
OCT 30 1994


SP 1556

SHEET 9 OF 14

14769  
PLAN NUMBER





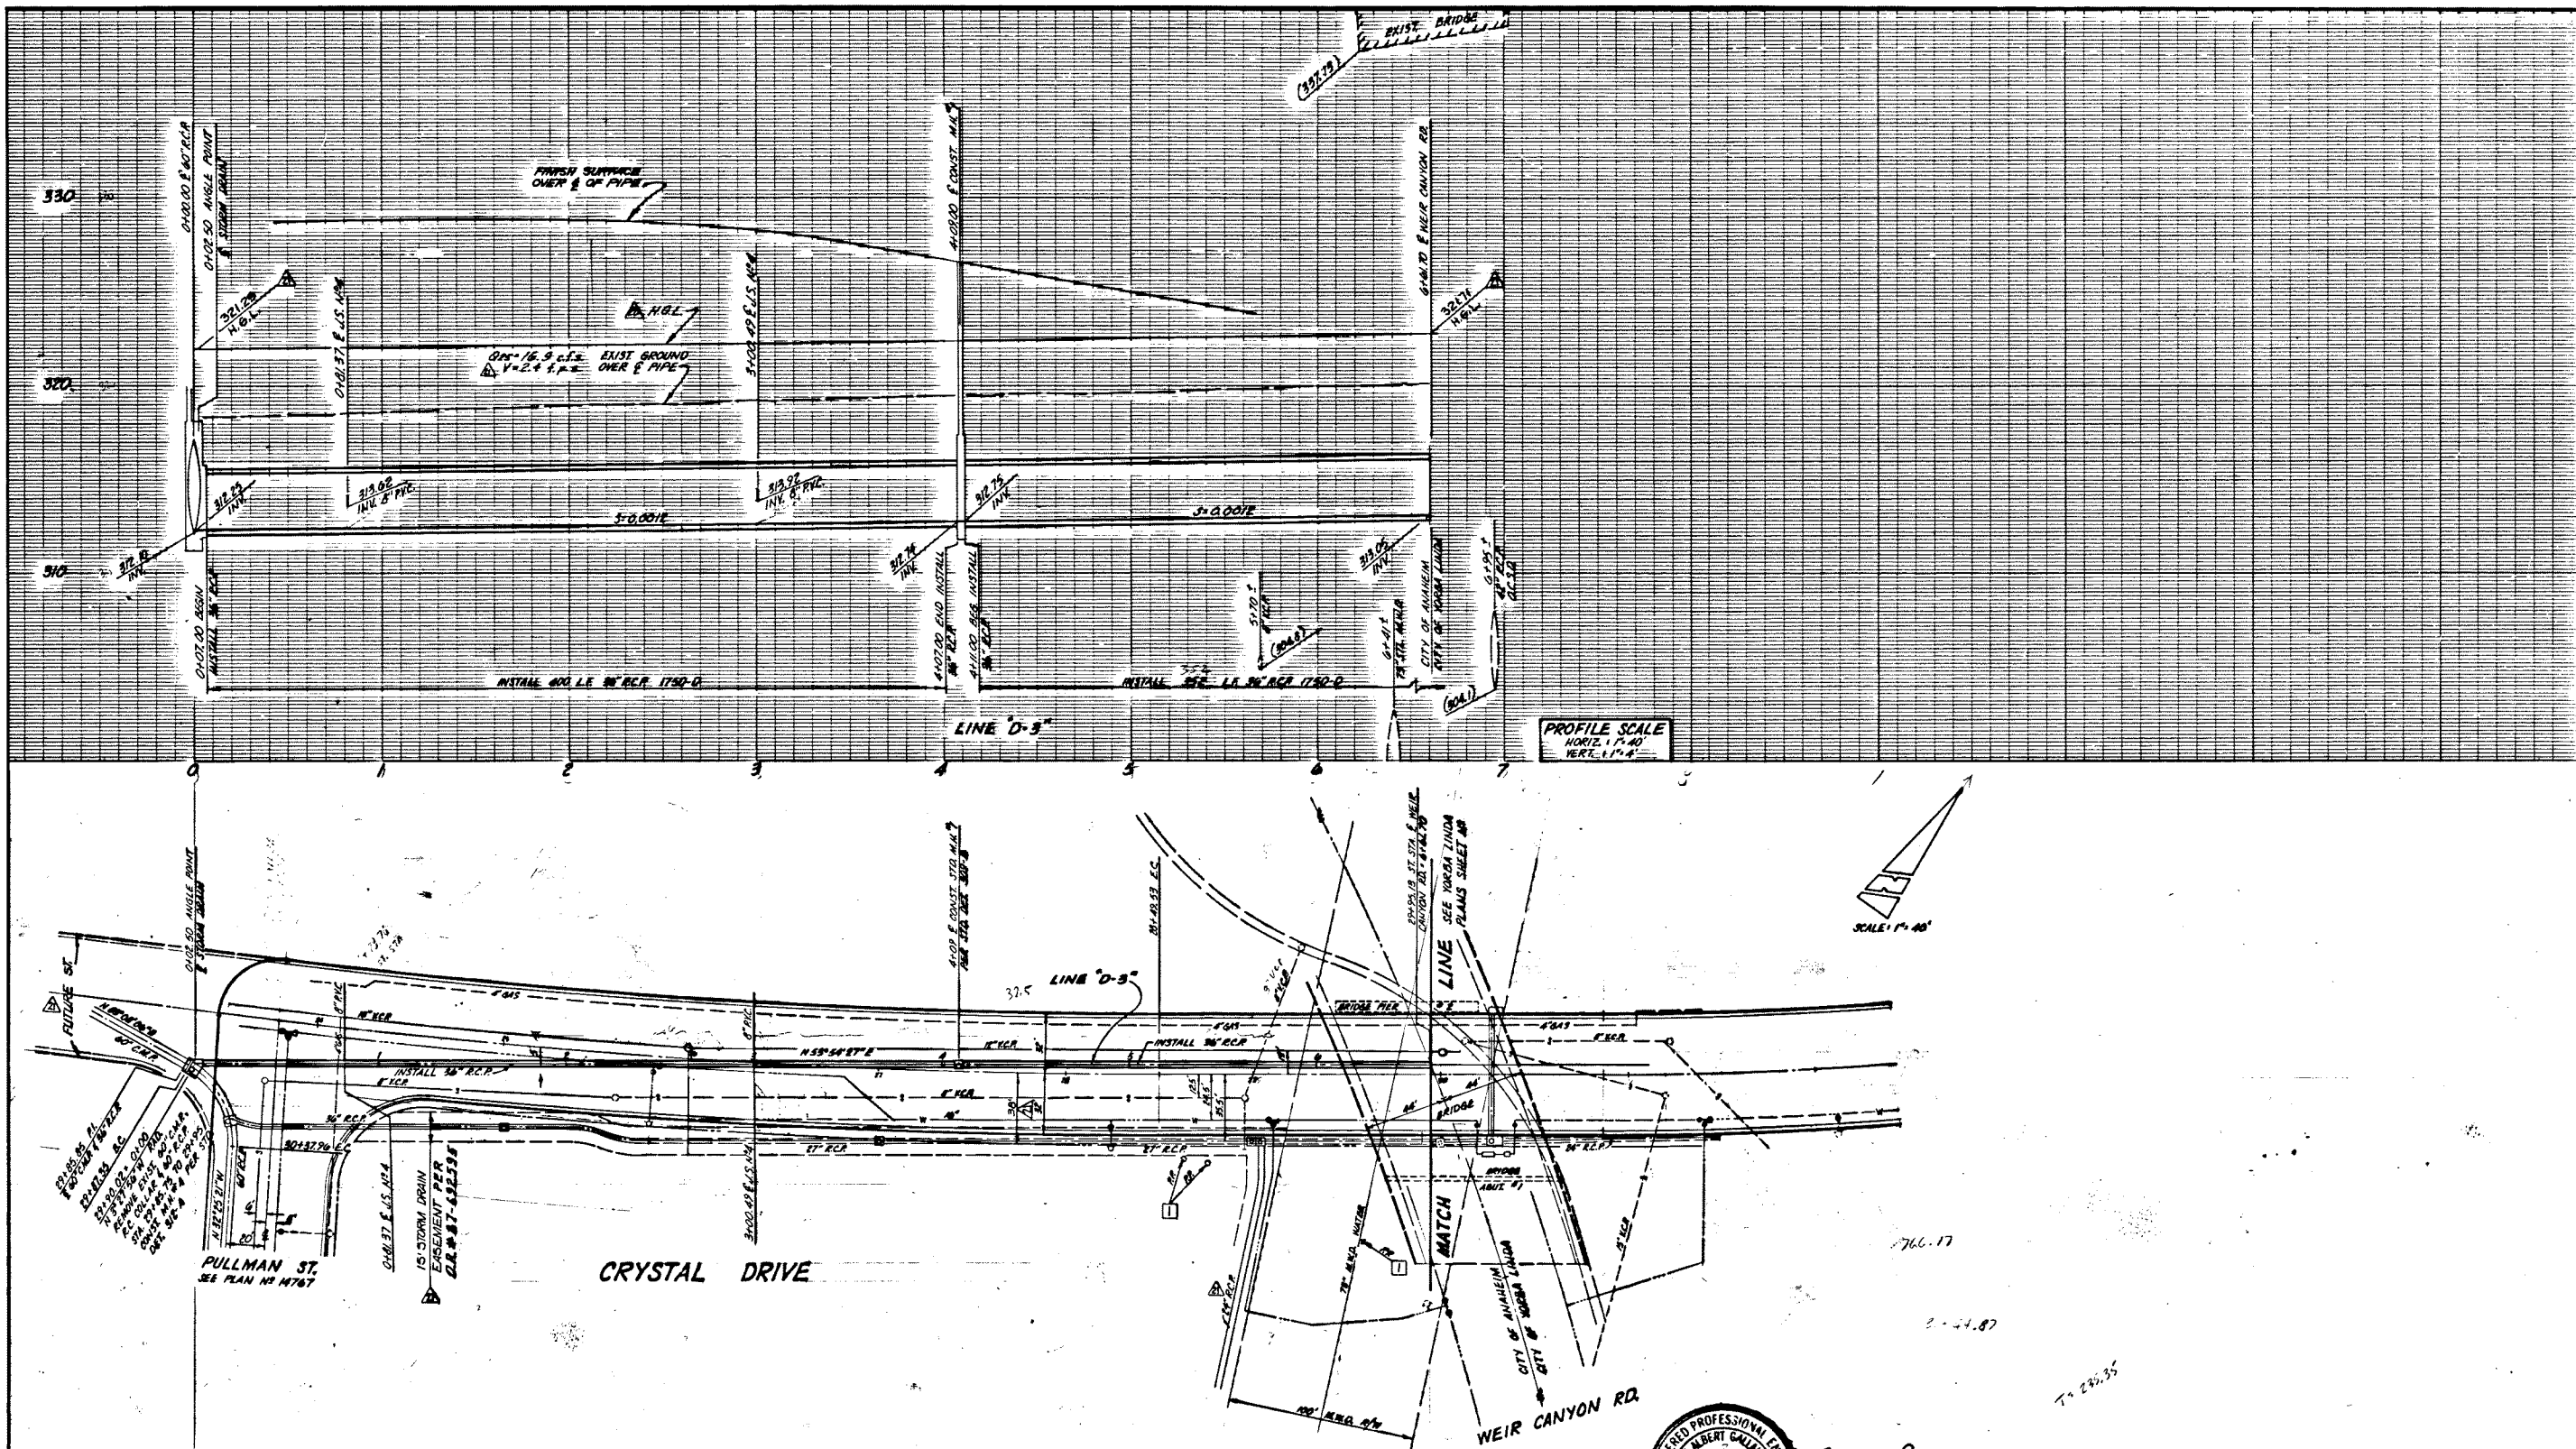

THIS PLAN HAS BEEN EXAMINED AND IS APPROVED ONLY AS TO COMPATIBILITY WITH ADJOINING EXISTING OR FUTURE IMPROVEMENTS AND CONFORMANCE WITH CITY OF ANAHEIM STANDARD DETAILS AND THE REQUIREMENTS FOR THE FOLLOWING APPLICABLE FACTORS: RIGHT OF WAY, ROADWAY MATERIALS, ALIGNMENTS AND GRADES, HYDROLOGY AND HYDRAULICS DESIGN OF STORM DRAIN OR SANITARY SEWER SYSTEMS AND UNDERGROUND CONDUIT OR OPEN-CHANNEL ALIGNMENTS, GRADES, SIZES AND MATERIALS.

### REVISIONS

NO.	DATE	INITIAL	DESCRIPTION
1	1-17-81	H.C.C.	PER CITY OF ANAHEIM PLAN CHECK

FOR GENERAL NOTES, QUANTITY ESTIMATE & KEY MAP SEE PLAN 14774

### REFERENCES

BENCH MARK: EL. 345.697 0.15 MI. N.W. ON WEIR CANYON RD. FROM THE RIVERSIDE FWY TO A CONC. HOWL ON THE WEST SIDE, 95' N. OF THE CENTERLINE OF WEIR CANYON RD., 118' S. OF THE SAKI CANAL, SET IN THE TOP OF THE CONC. HOWL - D.C.S. 1976 ADJ. 388-20-71	PLANS FOR THESE IMPROVEMENTS CITY OF ANAHEIM STD. OTLS. STREET 14761-14764, 14774, 14775 SEWER 14774-14777 STORM DRAIN 14764, 14767-14771	APPR. ELECTRICAL ENGINEERING MANAGER DATE	APPR. WATER ENGINEERING MANAGER DATE
--	---	--	---

SCALE: PREPARED UNDER THE SUPERVISION OF Michael Wilkerson C.E. NO. 23946	DATE: 1-8-84
RECOMMEND APPROVAL CITY ENGINEER	5-22-84
APPROVED CITY ENGINEER	3-22-85



PROJECT ENGINEER

STORM DRAIN IMPROVEMENTS  
**CRYSTAL DRIVE**  
FROM WEIR CANYON RD. TO PULLMAN ST.

CITY OF ANAHEIM

AS-BUILT  
OCT 30 1984

SP 1456  
SHEET 11 OF 14  
14771  
PLAN NUMBER

SCALE: 1" = 40'

# SIGNING NOTES


1. INSTALL R20-4.5 W/RT & LT ARROW "NO STOPPING ANY TIME" SIGN AND POST.
2. INSTALL W3 STANDARD "TURN" SIGN AND W6 STANDARD (20 MPH) "ADVISORY SPEED" SIGN AND POST.
3. INSTALL W11 STANDARD "LANE DROP" SIGN AND POST.
4. INSTALL R18-2.1 "RIGHT LANE MUST TURN RIGHT" SIGN AND POST.
5. INSTALL W8-1 WARNING ARROW SIGN & POST.
6. INSTALL TYPE 11 WARNING SIGN & POST.
7. INSTALL W4-4.1 ARROW WITH "15" SIGN & POST.
8. INSTALL R20-7 "YIELD" SIGN & POST.
9. INSTALL R21 "STOP" SIGN (36" x 36") SIGN & POST.
10. INSTALL R2 "KEEP RIGHT (SYMBOL)" SIGN & POST.
11. INSTALL W8-1 WARNING ARROW SIGN & POST.

# STRIPING NOTES

1. PAINT DOUBLE YELLOW LINE AND INSTALL PAVEMENT MARKERS PER FIGURE 6-1, DETAIL 32.
2. PAINT TWO-WAY LEFT TURN LANE AND INSTALL PAVEMENT MARKERS PER FIGURE 6-2, DETAIL 32.
3. PAINT CHANNELIZATION LINE AND INSTALL PAVEMENT MARKERS PER FIGURE 6-3, DETAIL 32.
4. PAINT SKIP LINE AND INSTALL PAVEMENT MARKERS PER FIGURE 6-2, DETAIL 32.
5. PAINT 12" WHITE LIMIT OR CROSSWALK LINE.
6. PAINT INDICATED PAVEMENT MARKING.
7. PAINT 4" WHITE EDGELINE STRIPE.

# GENERAL NOTES

1. Traffic signs, stripes, legends and pavement markers per Caltrans Traffic Sign Specifications, Traffic Manual, Maintenance Manual, and Standard Specifications. Conform pavement legends to existing city pavement markings. Reflectorize all signs, stripes, and legends. New sign posts shall be per Caltrans Specifications.
2. Painting procedures for striping per Standard Specifications for Public Works Construction (APWA/AGC).

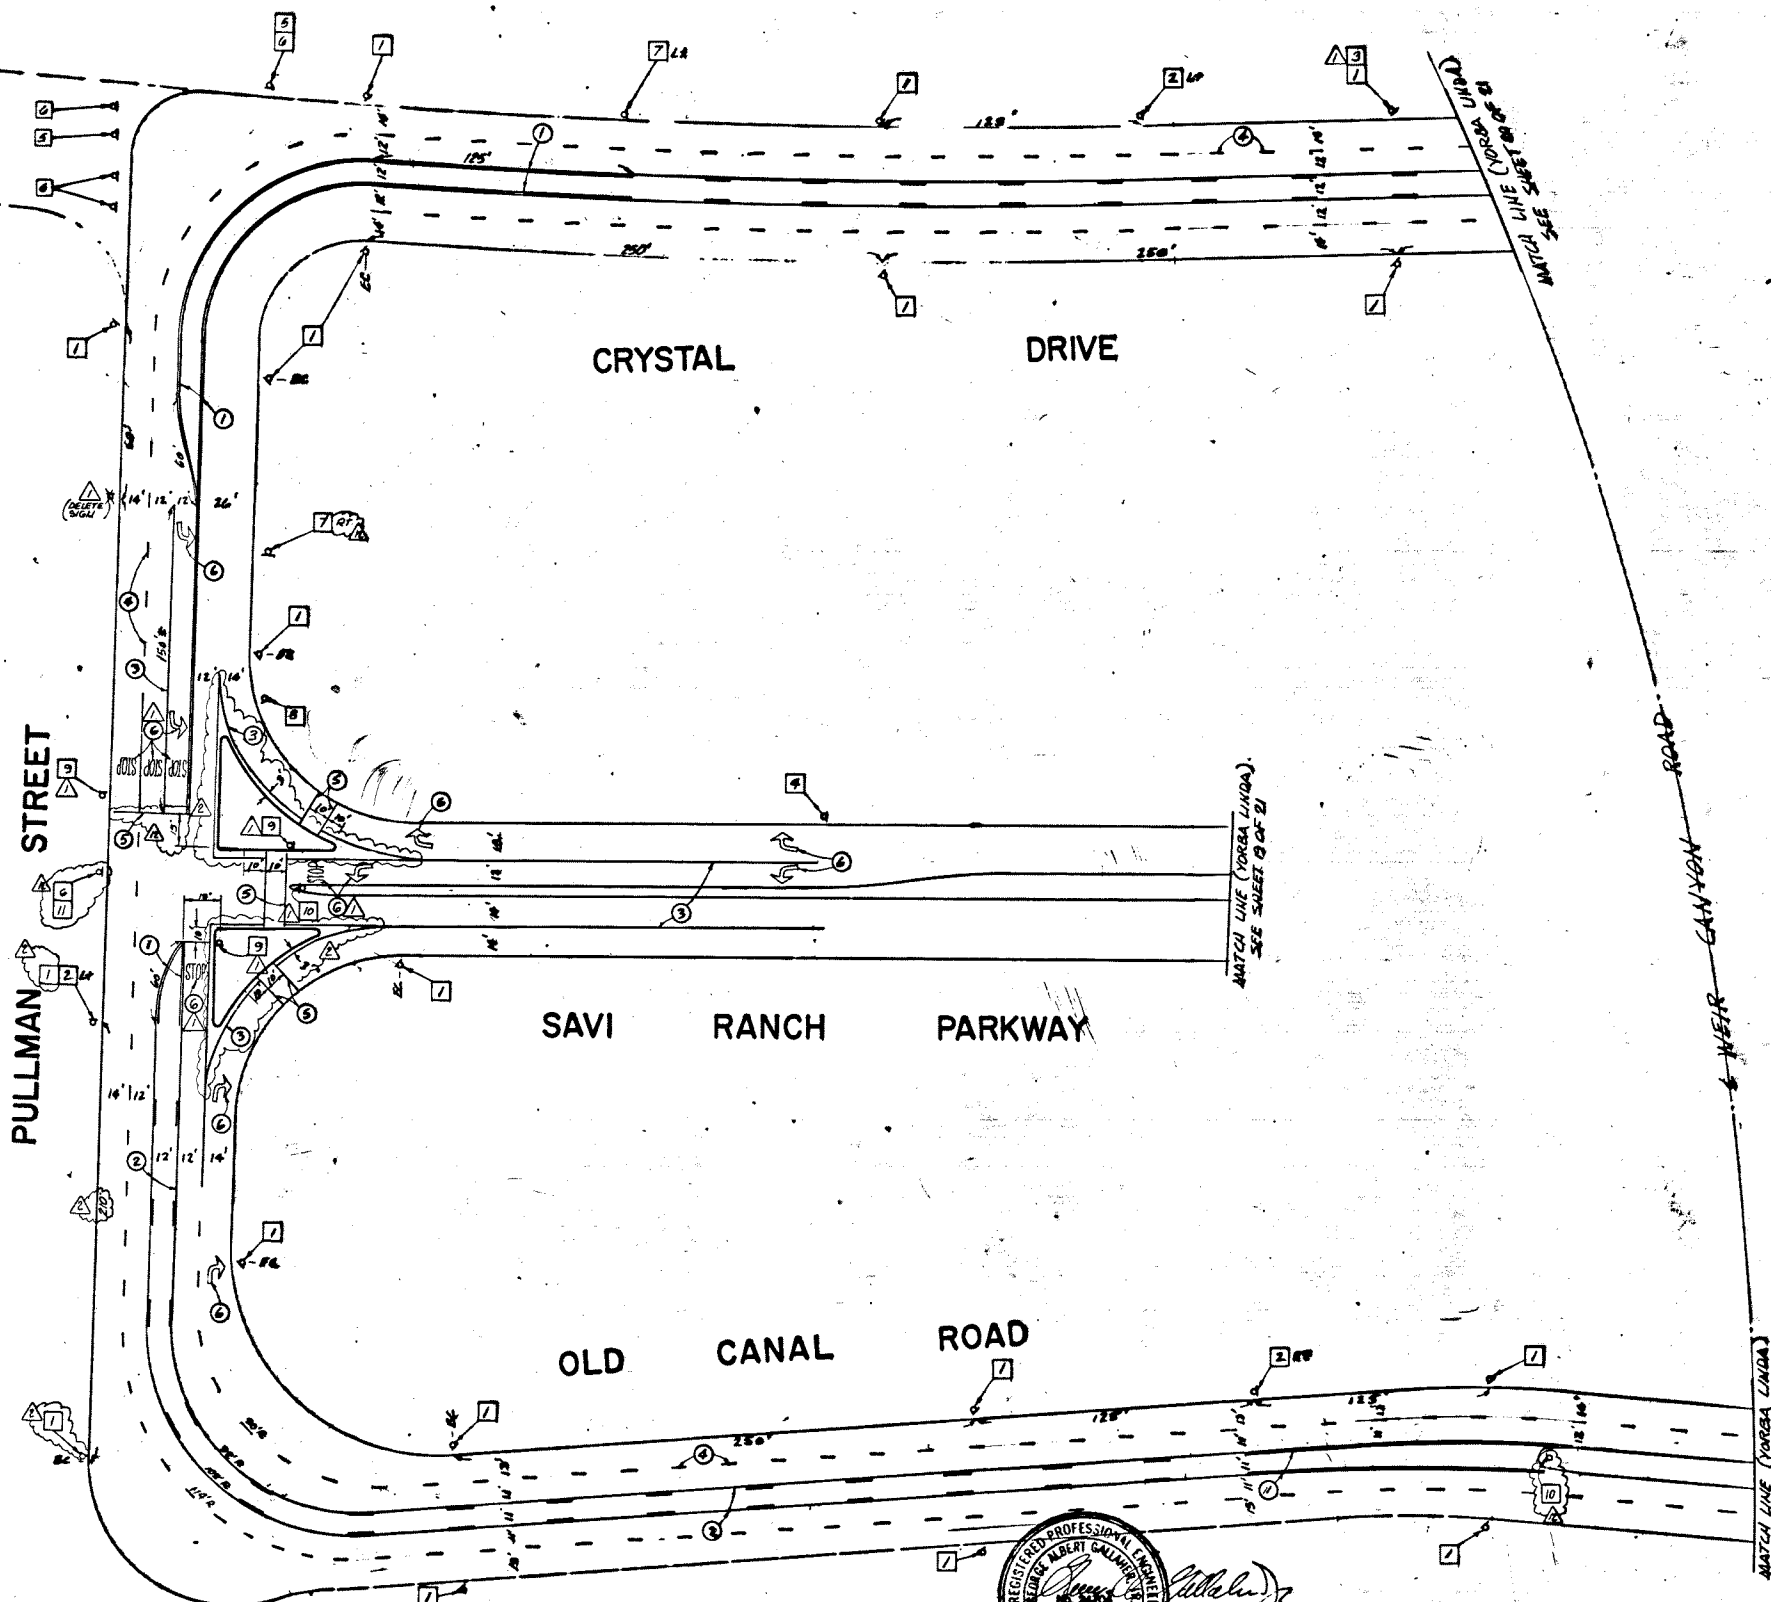


THIS PLAN HAS BEEN EXAMINED AND IS APPROVED ONLY AS TO COMPATIBILITY WITH ADJOINING EXISTING OR FUTURE IMPROVEMENTS AND CONFORMANCE WITH CITY OF ANAHEIM STANDARD DETAILS AND THE REQUIREMENTS FOR THE FOLLOWING APPLICABLE FACTORS: RIGHT OF WAY, ROADWAY MATERIALS, ALIGNMENTS AND GRADES, HYDROLOGY AND HYDRAULICS DESIGN OF STORM DRAIN OR SANITARY SEWER SYSTEMS AND UNDERGROUND CONDUIT OR OPEN-CHANNEL ALIGNMENTS, GRADES, SIZES AND MATERIALS.

FOR GENERAL NOTES, QUANTITY ESTIMATE & KEY MAP SEE PLAN 14771

## REFERENCES

PLANS FOR THESE IMPROVEMENTS CITY OF ANAHEIM STD. DTL.  
 STREET 14761-14766, 14712, 14773  
 SEWER 14774-14777  
 STORM DRAIN 14761, 14767-14771, 14772  
 APPR. ELECTRICAL ENGINEERING MANAGER  
 DATE

PREPARED BY  
**DSI**  
 DESIGNED BY  
 CHECKED BY  
 R.C. NO. 30540  
 RECOMMEND. APPROVAL  
 DATE

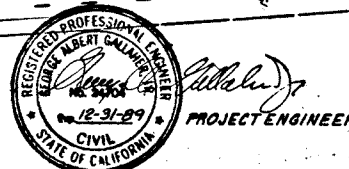

SIGNING & STRIPING PLAN  
 SAVI RANCH



CITY OF ANAHEIM

AS-BUILT  
 OCT 30 1990

SP 1556  
 SHEET 12 OF 14

14772  
 PLAN NUMBER



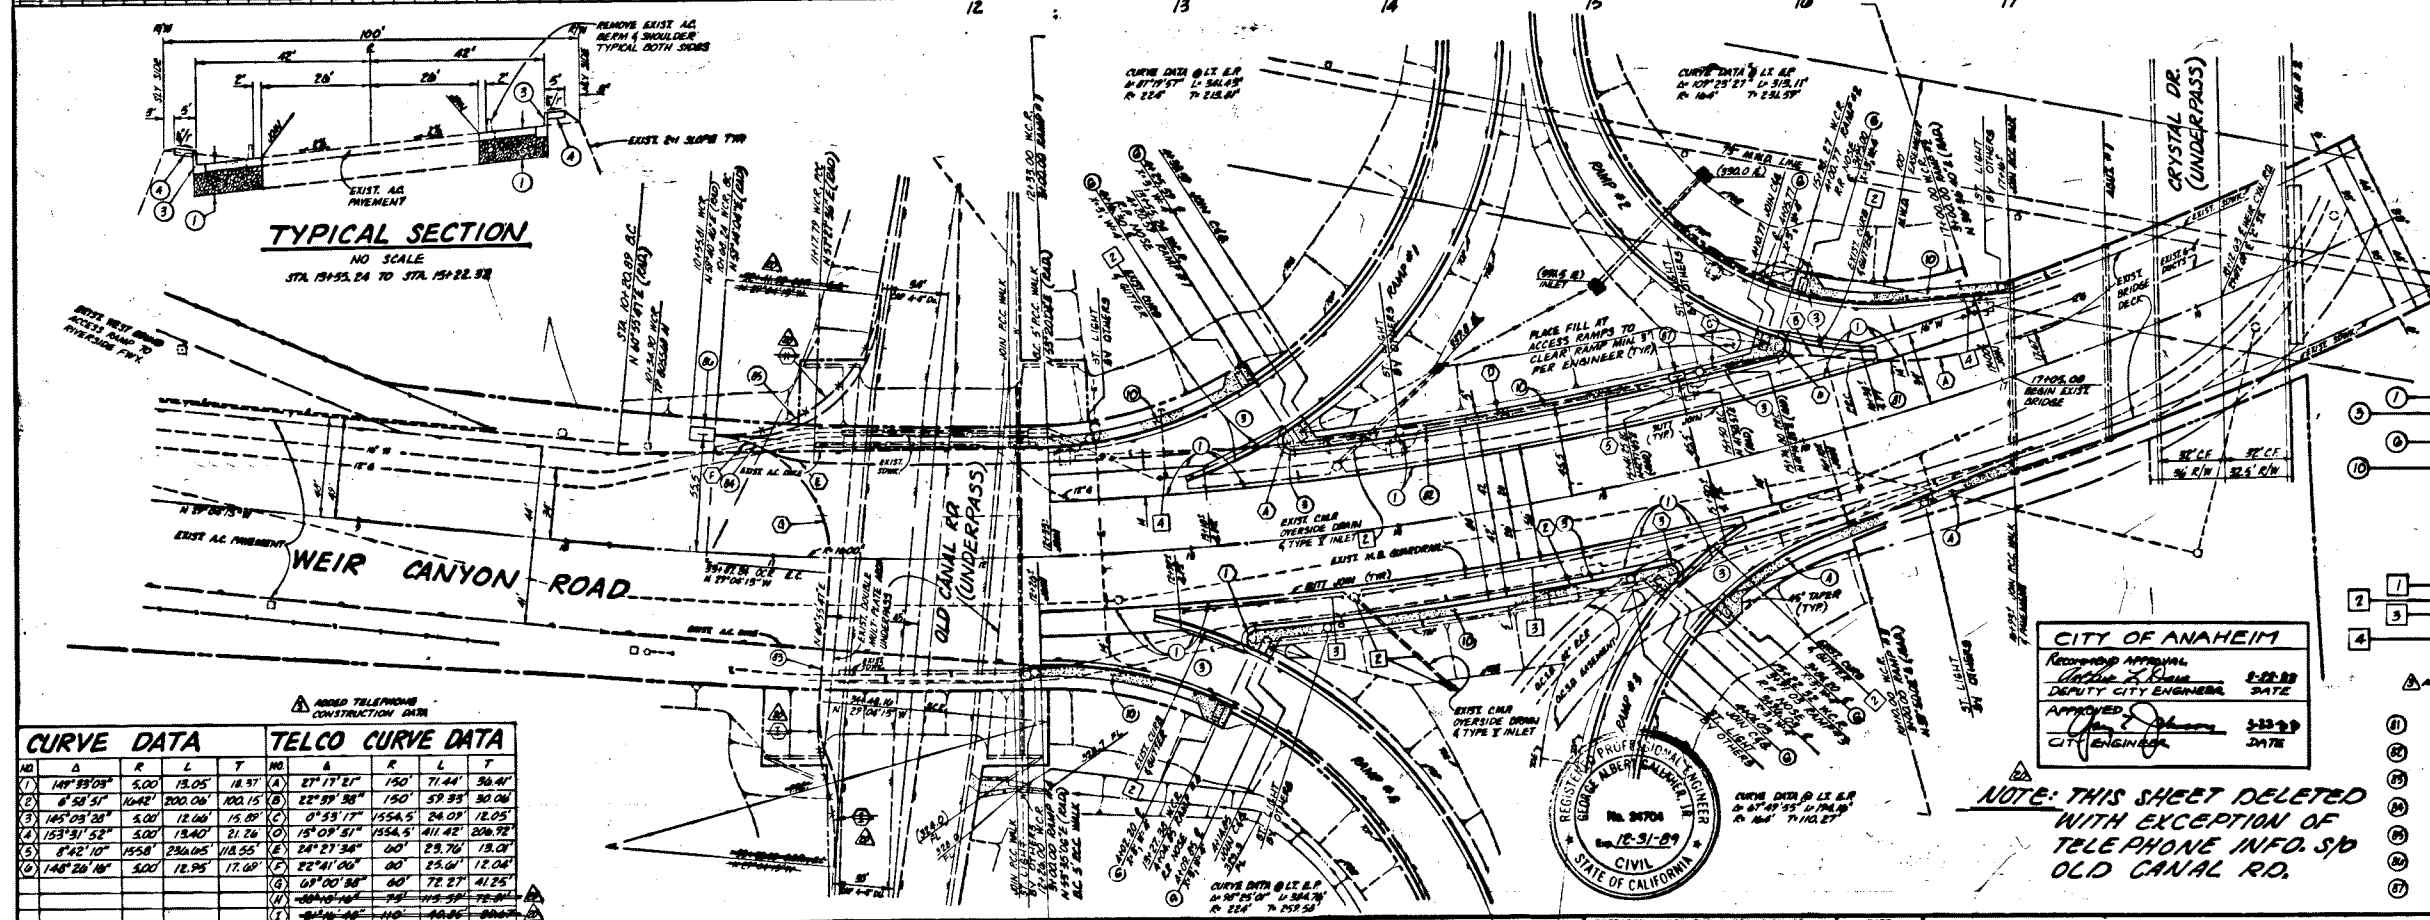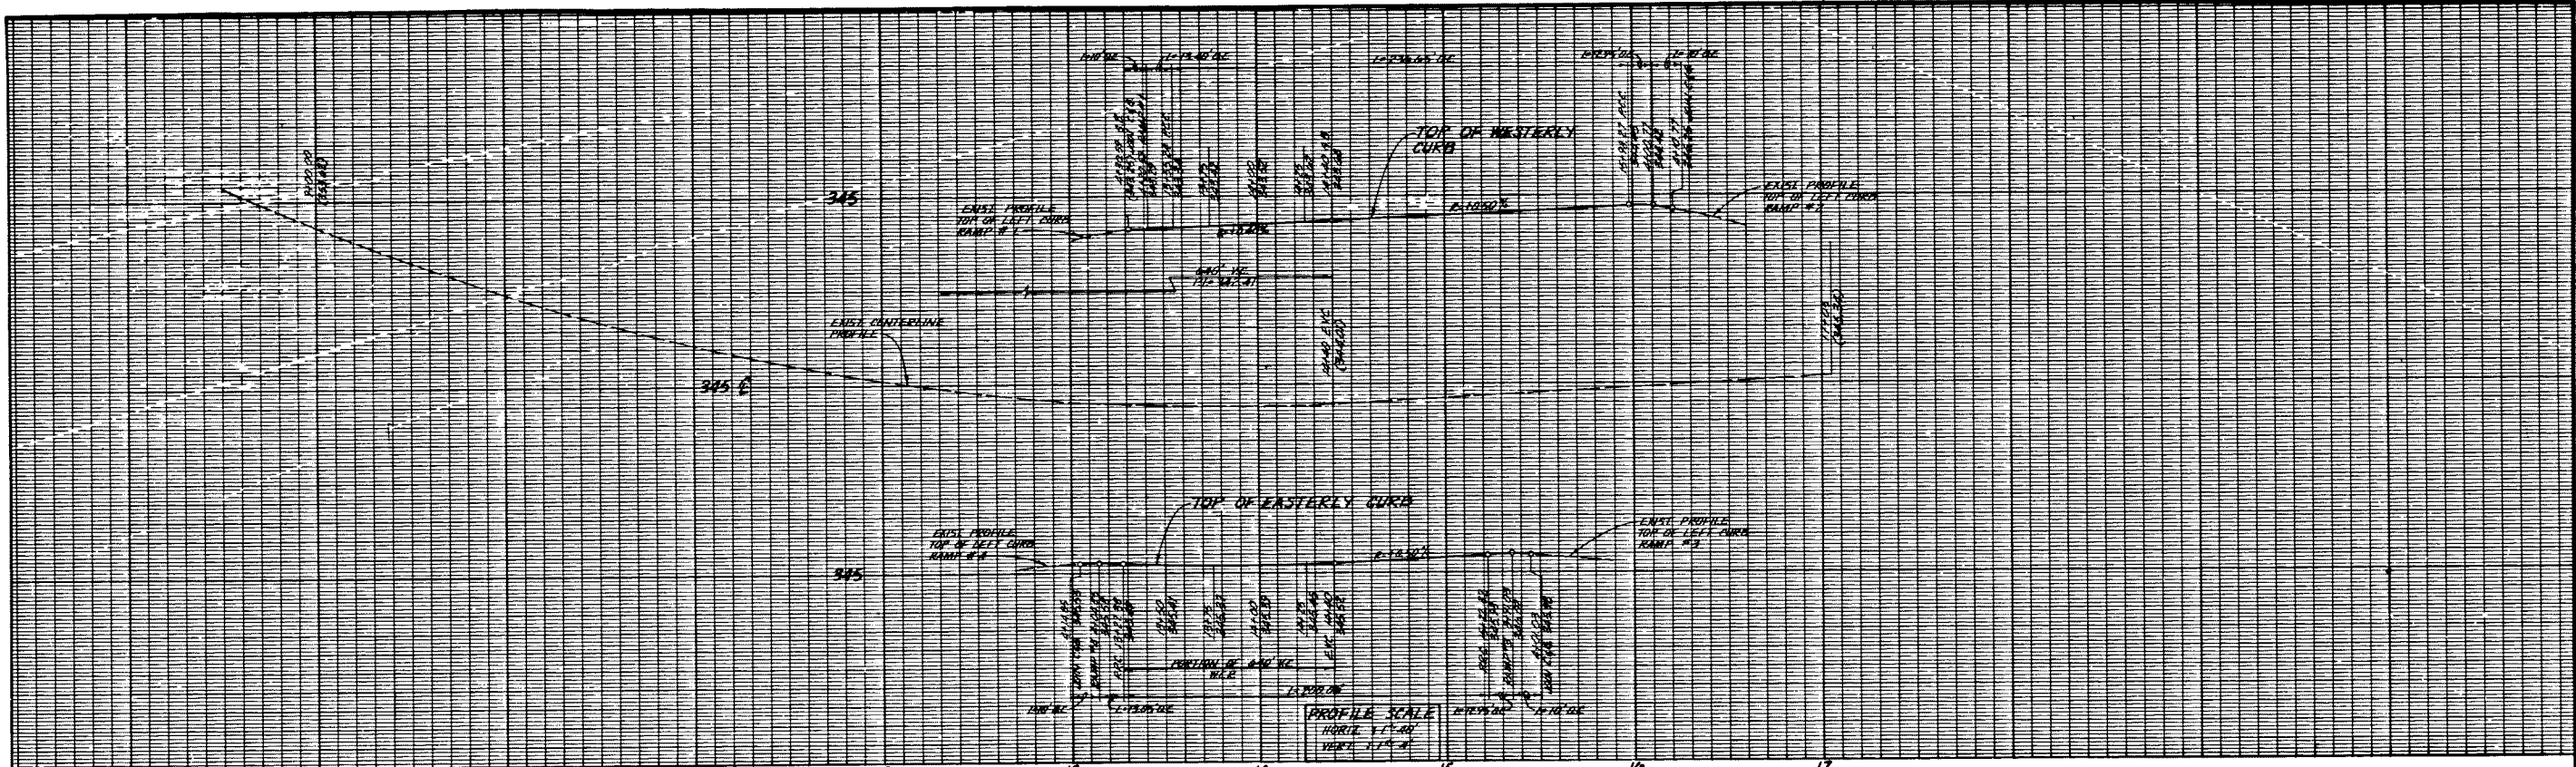

SCALE 1"=40'

\* 4" AC / 12" AS ASSUMED FOR BIDDING PURPOSES. FINAL PAVEMENT SECTION TO BE DETERMINED AFTER ROUGH GRADING IS COMPLETED.

- CONSTRUCTION NOTES**
- 1. CONST. A.C. PMT. ON A.B. & CONST. PCC CURB & GUTTER TYPE "A-2" PER OCMA STD. PLAN 201.
  - 2. CONST. ACCESS RAMP DEPRESSION PER OCMA STD. PLAN III.
  - 3. CONST. 4" THICK PCC SIDEWALK PER OCMA STD. PLAN 203.

- DISPOSITION NOTES**
- 1. PROTECT IN PLACE
  - 2. REMOVE
  - 3. REMOVE & SET ASIDE TO BE PICKED UP BY OTHERS
  - 4. ADJUST TO GRADE

- TELCO CONSTRUCTION NOTES**
- 1. PLACE 155' 0-4" DUCTS
  - 2. PLACE 455' 0-4" DUCTS
  - 3. PLACE 215' 0-4" DUCTS
  - 4. PLACE 20' 10-4" DUCTS
  - 5. PLACE 116' 0-4" DUCTS
  - 6. PLACE 12' X 6" W X 7" N MANHOLE
  - 7. PLACE 8 1/2' X 4 1/2' W X 6 1/2' N MANHOLE

CURVE DATA				TELCO CURVE DATA			
NO.	Δ	R	L	NO.	Δ	R	L
1	141° 59' 08"	5.00	13.05	1	27° 17' 21"	150	71.44
2	6° 50' 51"	1042	200.08	2	22° 59' 58"	150	59.93
3	145° 09' 28"	5.00	12.00	3	0° 58' 17"	1554.5	24.07
4	153° 31' 52"	5.00	13.40	4	16° 09' 51"	1554.5	41.42
5	8° 42' 10"	1958	290.05	5	24° 27' 36"	60	29.70
6	146° 26' 16"	5.00	12.95	6	22° 41' 06"	60	29.67
				7	07° 00' 38"	60	12.27
				8	28° 40' 18"	191	115.57
				9	24° 46' 46"	140	60.06

**REVISIONS**

NUMBER	DATE	INITIALS	DESCRIPTION
1	5-20-75	HSM	ADDED TELEPHONE CONSTRUCTION DATA
2	6-27-75	HSM	CHANGE PER CITY OF ANAHEIM
3	11-2-76	H.C.M.	PER "AS BUILT"

**REFERENCES**

BENCH MARK: EL. 345.897  
 0.15 MI. N. ON WEIR CANYON RD. FROM THE RIVERSIDE FWY TO A CONC. HOWL ON THE WEST SIDE, 25' N. OF THE CENTERLINE OF WEIR CANYON RD. 1/4" S. OF THE SAVI CANAL SET IN THE TOP OF THE CONC. HOWL - G.C.S. 1970 ADJ. 3K-K-20-71

**BASIS OF BEARING:**  
 THE S. OF WEIR CANYON RD. BEING N 29° 04' 15" W PER STATE DIVISION OF HIGHWAYS MAP N.E.R. 10-1-2 FOR THE RIGHT OF WAY OF THE RIVERSIDE FREEWAY.

PREPARED UNDER THE SUPERVISION OF  
*George A. Sallabau*  
 R.C.E. NO. 21201

DATE: 5/2/75

DRAWN BY  
 CHECKED  
 RECOMMENDED

APPROVED: *See Above*  
 DEPARTMENT OF PUBLIC WORKS

ASSESSMENT DISTRICT NO. 83-1 (SAVI)  
**WEIR CANYON ROAD**  
 FROM 1050' NORTH OF RIVERSIDE FWY.  
 TO 1550' NORTH OF RIVERSIDE FWY.  
 STREET IMPROVEMENTS

**CITY OF YORBA LINDA**

CITY OF ANAHEIM  
 PLAN NO. 14773

SHEET NO. 13 OF 14

# ATTACHMENT 5

---

WATER QUALITY EXHIBITS

---



A Forterra Company

# Modular Wetlands<sup>®</sup> System Linear

A Stormwater Biofiltration Solution



# OVERVIEW


The Bio Clean Modular Wetlands® System Linear represents a pioneering breakthrough in stormwater technology as the only biofiltration system to utilize patented horizontal flow, allowing for a smaller footprint, higher treatment capacity, and a wide range of versatility. While most biofilters use little or no pretreatment, the Modular Wetlands® incorporates an advanced pretreatment chamber that includes separation and pre-filter cartridges. In this chamber, sediment and hydrocarbons are removed from runoff before entering the biofiltration chamber, reducing maintenance costs and improving performance.

Horizontal flow also gives the system the unique ability to adapt to the environment through a variety of configurations, bypass orientations, and diversion applications.

### The Urban Impact

For hundreds of years, natural wetlands surrounding our shores have played an integral role as nature’s stormwater treatment system. But as cities grow and develop, our environment’s natural filtration systems are blanketed with impervious roads, rooftops, and parking lots.

Bio Clean understands this loss and has spent years re-establishing nature’s presence in urban areas, and rejuvenating waterways with the Modular Wetlands® System Linear.

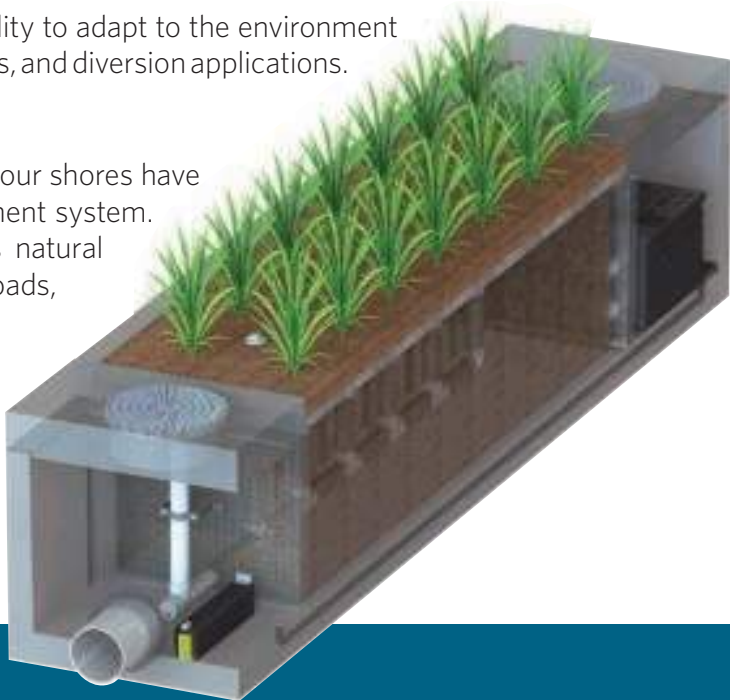

# PERFORMANCE

The Modular Wetlands® continues to outperform other treatment methods with superior pollutant removal for TSS, heavy metals, nutrients, hydrocarbons, and bacteria. Since 2007 the Modular Wetlands® has been field tested on numerous sites across the country and is proven to effectively remove pollutants through a combination of physical, chemical, and biological filtration processes. In fact, the Modular Wetlands® harnesses some of the same biological processes found in natural wetlands in order to collect, transform, and remove even the most harmful pollutants.

66% REMOVAL OF DISSOLVED ZINC	69% REMOVAL OF TOTAL ZINC	38% REMOVAL OF DISSOLVED COPPER	64% REMOVAL OF TOTAL PHOSPHORUS	
45% REMOVAL OF NITROGEN	50% REMOVAL OF TOTAL COPPER	95% REMOVAL OF MOTOR OIL	67% REMOVAL OF ORTHO PHOSPHORUS	85% REMOVAL OF TSS

# APPROVALS

The Modular Wetlands® System Linear has successfully met years of challenging technical reviews and testing from some of the most prestigious and demanding agencies in the nation and perhaps the world. Here is a list of some of the most high-profile approvals, certifications, and verifications from around the country.



### Washington State Department of Ecology TAPE Approved

The MWS Linear is approved for General Use Level Designation (GULD) for Basic, Enhanced, and Phosphorus treatment at 1 gpm/ft² loading rate. The highest performing BMP on the market for all main pollutant categories.



### California Water Resources Control Board, Full Capture Certification

The Modular Wetlands® System is the first biofiltration system to receive certification as a full capture trash treatment control device.



### Virginia Department of Environmental Quality, Assignment

The Virginia Department of Environmental Quality assigned the MWS Linear the highest phosphorus removal rating for manufactured treatment devices to meet the new Virginia Stormwater Management Program (VSMP) regulation technical criteria.



### Maryland Department of the Environment, Approved ESD

Granted Environmental Site Design (ESD) status for new construction, redevelopment, and retrofitting when designed in accordance with the design manual.



### MASTEP Evaluation

The University of Massachusetts at Amherst – Water Resources Research Center issued a technical evaluation report noting removal rates up to 84% TSS, 70% total phosphorus, 68.5% total zinc, and more.



### Rhode Island Department of Environmental Management, Approved BMP

Approved as an authorized BMP and noted to achieve the following minimum removal efficiencies: 85% TSS, 60% pathogens, 30% total phosphorus, and 30% total nitrogen.

# ADVANTAGES

- HORIZONTAL FLOW BIOFILTRATION
- GREATER FILTER SURFACE AREA
- PRETREATMENT CHAMBER
- PATENTED PERIMETER VOID AREA
- FLOW CONTROL
- NO DEPRESSED PLANTER AREA
- AUTO DRAINDOWN MEANS NO MOSQUITO VECTOR



# OPERATION

The Modular Wetlands® System Linear is the most efficient and versatile biofiltration system on the market, and it is the only system with horizontal flow which:

- Improves performance
- Reduces footprint
- Minimizes maintenance

Figure 1 & Figure 2 illustrate the invaluable benefits of horizontal flow and the multiple treatment stages.

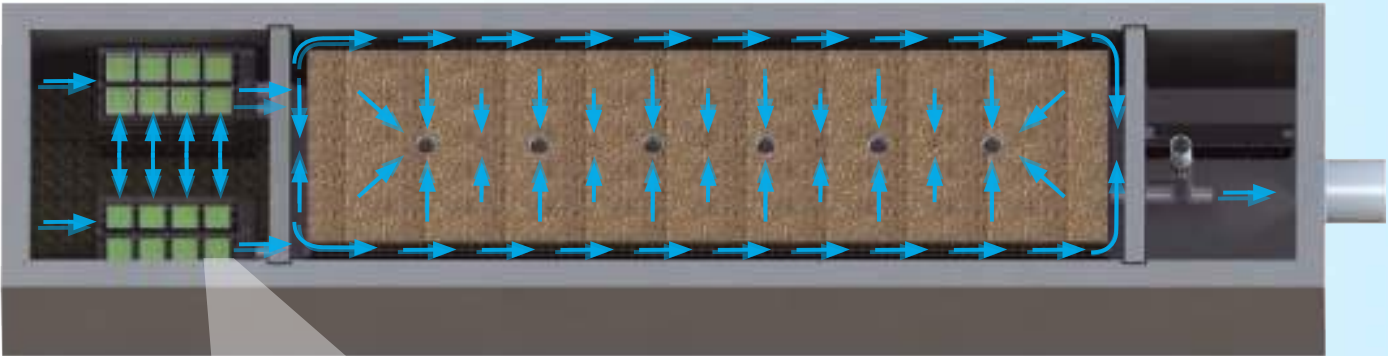


Figure 2,  
Top View

2x to 3x more surface area than traditional downward flow bioretention systems.


## 1 PRETREATMENT

### SEPARATION

- Trash, sediment, and debris are separated before entering the pre-filter cartridges
- Designed for easy maintenance access

### PRE-FILTER CARTRIDGES

- Over 25 sq. ft. of surface area per cartridge
- Utilizes BioMediaGREEN™ filter material
- Removes over 80% of TSS and 90% of hydrocarbons
- Prevents pollutants that cause clogging from migrating to the biofiltration chamber

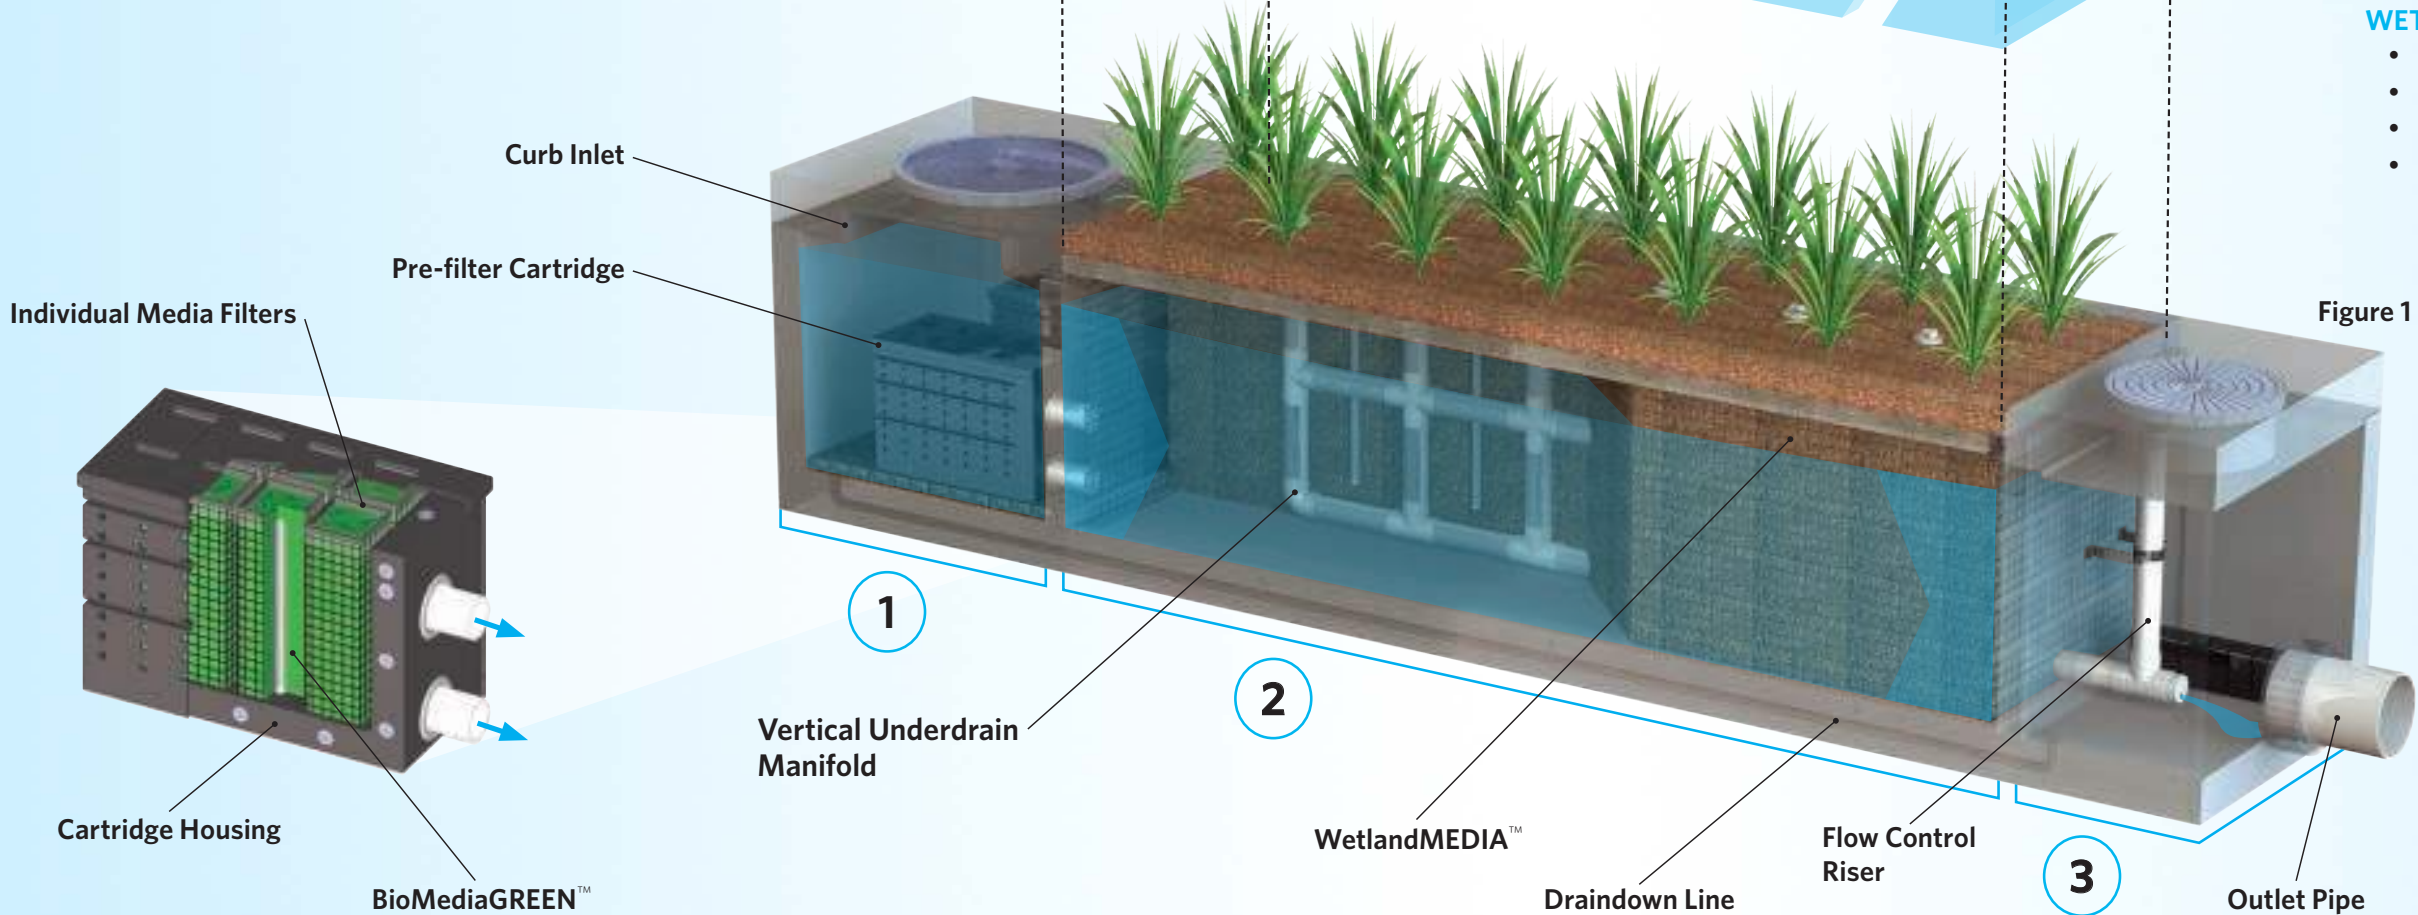

## 2 BIOFILTRATION

### HORIZONTAL FLOW

- Less clogging than downward flow biofilters
- Water flow is subsurface
- Improves biological filtration

### PATENTED PERIMETER VOID AREA

- Vertically extends void area between the walls and the WetlandMEDIA™ on all four sides
- Maximizes surface area of the media for higher treatment capacity

### WETLANDMEDIA

- Contains no organics and removes phosphorus
- Greater surface area and 48% void space
- Maximum evapotranspiration
- High ion exchange capacity and lightweight

## 3 DISCHARGE

### FLOW CONTROL

- Orifice plate controls flow of water through WetlandMEDIA™ to a level lower than the media's capacity
- Extends the life of the media and improves performance

### DRAINDOWN FILTER

- The draindown is an optional feature that completely drains the pretreatment chamber
- Water that drains from the pretreatment chamber between storm events will be treated






# CONFIGURATIONS

The Modular Wetlands® System Linear is the preferred biofiltration system of civil engineers across the country due to its versatile design. This highly versatile system has available “pipe-in” options on most models, along with built-in curb or grated inlets for simple integration into your storm drain design.




## CURB TYPE

The Curb Type configuration accepts sheet flow through a curb opening and is commonly used along roadways and parking lots. It can be used in sump or flow-by conditions. Length of curb opening varies based on model and size.

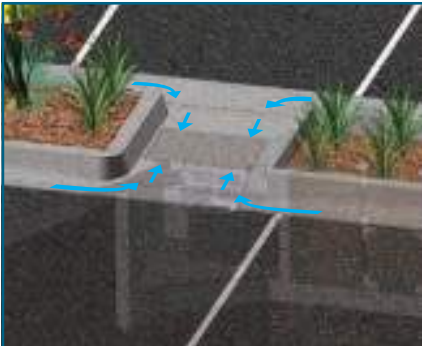

## GRATE TYPE

The Grate Type configuration offers the same features and benefits as the Curb Type but with a grated/drop inlet above the systems pretreatment chamber. It has the added benefit of allowing pedestrian access over the inlet. ADA-compliant grates are available to assure easy and safe access. The Grate Type can also be used in scenarios where runoff needs to be intercepted on both sides of landscape islands.

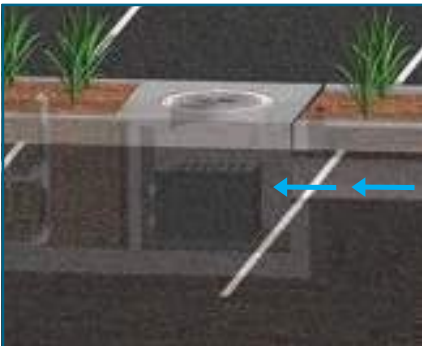

## VAULT TYPE

The system’s patented horizontal flow biofilter is able to accept inflow pipes directly into the pretreatment chamber, meaning the Modular Wetlands® can be used in end-of-the-line installations. This greatly improves feasibility over typical decentralized designs that are required with other biofiltration/ bioretention systems. Another benefit of the “pipe-in” design is the ability to install the system downstream of underground detention systems to meet water quality volume requirements.



## DOWNSPOUT TYPE

The Downspout Type is a variation of the Vault Type and is designed to accept a vertical downspout pipe from rooftop and podium areas. Some models have the option of utilizing an internal bypass, simplifying the overall design. The system can be installed as a raised planter, and the exterior can be stuccoed or covered with other finishes to match the look of adjacent buildings.

# ORIENTATIONS

## SIDE-BY-SIDE

The Side-By-Side orientation places the pretreatment and discharge chamber adjacent to one another with the biofiltration chamber running parallel on either side. This minimizes the system length, providing a highly compact footprint. It has been proven useful in situations such as streets with directly adjacent sidewalks, as half of the system can be placed under that sidewalk. This orientation also offers internal bypass options as discussed below.



## END-TO-END

The End-To-End orientation places the pretreatment and discharge chambers on opposite ends of the biofiltration chamber, therefore minimizing the width of the system to 5 ft. (outside dimension). This orientation is perfect for linear projects and street retrofits where existing utilities and sidewalks limit the amount of space available for installation. One limitation of this orientation is that bypass must be external.



# BYPASS

## INTERNAL BYPASS WEIR (SIDE-BY-SIDE ONLY)

The Side-By-Side orientation places the pretreatment and discharge chambers adjacent to one another allowing for integration of internal bypass. The wall between these chambers can act as a bypass weir when flows exceed the system’s treatment capacity, thus allowing bypass from the pretreatment chamber directly to the discharge chamber.

## EXTERNAL DIVERSION WEIR STRUCTURE


This traditional offline diversion method can be used with the Modular Wetlands® in scenarios where runoff is being piped to the system. These simple and effective structures are generally configured with two outflow pipes. The first is a smaller pipe on the upstream side of the diversion weir - to divert low flows over to the Modular Wetlands® for treatment. The second is the main pipe that receives water once the system has exceeded treatment capacity and water flows over the weir.

## FLOW-BY-DESIGN

This method is one in which the system is placed just upstream of a standard curb or grate inlet to intercept the first flush. Higher flows simply pass by the Modular Wetlands® and into the standard inlet downstream.

## DVERT LOW FLOW DIVERSION

This simple yet innovative diversion trough can be installed in existing or new curb and grate inlets to divert the first flush to the Modular Wetlands® via pipe. It works similar to a rain gutter and is installed just below the opening into the inlet. It captures the low flows and channels them over

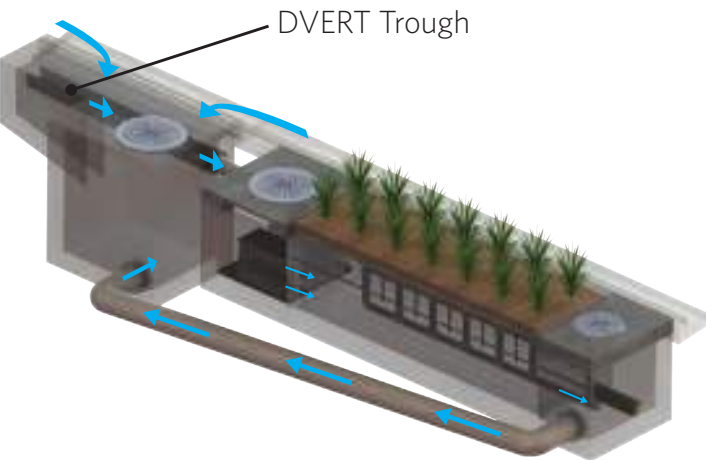

to a connecting pipe exiting out the wall of the inlet and leading to the MWS Linear. The DVERT is perfect for retrofit and green street applications that allow the Modular Wetlands® to be installed anywhere space is available.

# SPECIFICATIONS

## FLOW-BASED DESIGNS

The Modular Wetlands® System Linear can be used in stand-alone applications to meet treatment flow requirements. Since the Modular Wetlands® is the only biofiltration system that can accept inflow pipes several feet below the surface, it can be used not only in decentralized design applications but also as a large central end-of-the-line application for maximum feasibility.

MODEL #	DIMENSIONS	WETLANDMEDIA SURFACE AREA (sq. ft.)	TREATMENT FLOW RATE (cfs)
MWS-L-4-4	4' x 4'	23	0.052
MWS-L-4-6	4' x 6'	32	0.073
MWS-L-4-8	4' x 8'	50	0.115
MWS-L-4-13	4' x 13'	63	0.144
MWS-L-4-15	4' x 15'	76	0.175
MWS-L-4-17	4' x 17'	90	0.206
MWS-L-4-19	4' x 19'	103	0.237
MWS-L-4-21	4' x 21'	117	0.268
MWS-L-6-8	7' x 9'	64	0.147
MWS-L-8-8	8' x 8'	100	0.230
MWS-L-8-12	8' x 12'	151	0.346
MWS-L-8-16	8' x 16'	201	0.462
MWS-L-8-20	9' x 21'	252	0.577
MWS-L-8-24	9' x 25'	302	0.693
MWS-L-10-20	10' x 20'	302	0.693

# VOLUME-BASED DESIGNS

## HORIZONTAL FLOW BIOFILTRATION ADVANTAGE



The Modular Wetlands® System Linear offers a unique advantage in the world of biofiltration due to its exclusive horizontal flow design: Volume-Based Design. No other biofilter has the ability to be placed downstream of detention ponds, extended dry detention basins, underground storage systems and permeable paver reservoirs. The systems horizontal flow configuration and built-in orifice control allows it to be installed with just 6” of fall between inlet and outlet pipe for a simple connection to projects with shallow downstream tie-in points. In the example above, the Modular Wetlands® is installed downstream of underground box culvert storage. Designed for the water quality volume, the Modular Wetlands® will treat and discharge the required volume within local draindown time requirements.



### DESIGN SUPPORT

Bio Clean engineers are trained to provide you with superior support for all volume sizing configurations throughout the country. Our vast knowledge of state and local regulations allow us to quickly and efficiently size a system to maximize feasibility. Volume control and hydromodification regulations are expanding the need to decrease the cost and size of your biofiltration system. Bio Clean will help you realize these cost savings with the Modular Wetlands®, the only biofilter than can be used downstream of storage BMPs.

## ADVANTAGES

- LOWER COST THAN FLOW-BASED DESIGN
- BUILT-IN ORIFICE CONTROL STRUCTURE
- MEETS LID REQUIREMENTS
- WORKS WITH DEEP INSTALLATIONS



# APPLICATIONS

The Modular Wetlands® System Linear has been successfully used on numerous new construction and retrofit projects. The system's superior versatility makes it beneficial for a wide range of stormwater and waste water applications - treating rooftops, streetscapes, parking lots, and industrial sites.



## INDUSTRIAL

Many states enforce strict regulations for discharges from industrial sites. The Modular Wetlands® has helped various sites meet difficult EPA-mandated effluent limits for dissolved metals and other pollutants.



## STREETS

Street applications can be challenging due to limited space. The Modular Wetlands® is very adaptable, and it offers the smallest footprint to work around the constraints of existing utilities on retrofit projects.



## COMMERCIAL

Compared to bioretention systems, the Modular Wetlands® can treat far more area in less space, meeting treatment and volume control requirements.



## RESIDENTIAL

Low to high density developments can benefit from the versatile design of the Modular Wetlands®. The system can be used in both decentralized LID design and cost-effective end-of-the-line configurations.



## PARKING LOTS

Parking lots are designed to maximize space and the Modular Wetlands® 4 ft. standard planter width allows for easy integration into parking lot islands and other landscape medians.



## MIXED USE

The Modular Wetlands® can be installed as a raised planter to treat runoff from rooftops or patios, making it perfect for sustainable "live-work" spaces.

**More applications include:**

- Agriculture
- Reuse
- Low Impact Development
- Waste Water


# PLANT SELECTION

Abundant plants, trees, and grasses bring value and an aesthetic benefit to any urban setting, but those in the Modular Wetlands® System Linear do even more - they increase pollutant removal. What's not seen, but very important, is that below grade, the stormwater runoff/flow is being subjected to nature's secret weapon: a dynamic physical, chemical, and biological process working to break down and remove non-point source pollutants. The flow rate is controlled in the Modular Wetlands®, giving the plants more contact time so that pollutants are more successfully decomposed, volatilized, and incorporated into the biomass of the Modular Wetlands'® micro/macro flora and fauna.



A wide range of plants are suitable for use in the Modular Wetlands®, but selections vary by location and climate. View suitable plants by visiting [biocleanenvironmental.com/plants](https://biocleanenvironmental.com/plants).

# INSTALLATION

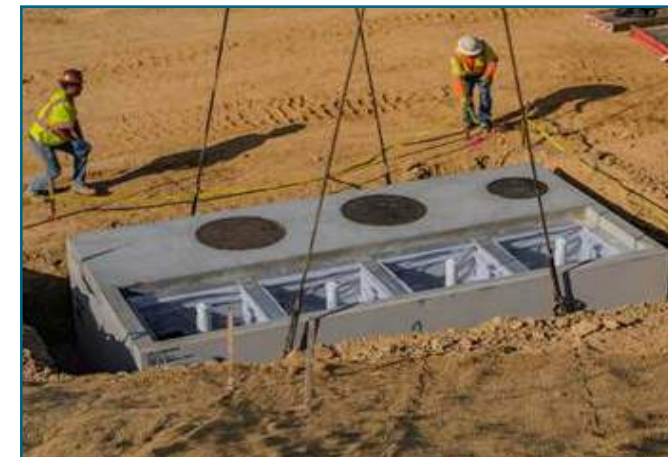

The Modular Wetlands® is simple, easy to install, and has a space-efficient design that offers lower excavation and installation costs compared to traditional tree-box type systems. The structure of the system resembles precast catch basin or utility vaults and is installed in a similar fashion.

The system is delivered fully assembled for quick installation. Generally, the structure can be unloaded and set in place in 15 minutes. Our experienced team of field technicians is available to supervise installations and provide technical support.

# MAINTENANCE



Reduce your maintenance costs, man hours, and materials with the Modular Wetlands®. Unlike other biofiltration systems that provide no pretreatment, the Modular Wetlands® is a self-contained treatment train which incorporates simple and effective pretreatment.

Maintenance requirements for the biofilter itself are almost completely eliminated, as the pretreatment chamber removes and isolates trash, sediments, and hydrocarbons. What's left is the simple maintenance of an easily accessible pretreatment chamber that can be cleaned by hand or with a standard vac truck. Only periodic replacement of low-cost media in the pre-filter cartridges is required for long-term operation, and there is absolutely no need to replace expensive biofiltration media.



5796 Armada Drive Suite 250  
Carlsbad, CA 92008

855.566.3938

[stormwater@forterrabp.com](mailto:stormwater@forterrabp.com)

[biocleanenvironmental.com](http://biocleanenvironmental.com)