 


PRELIMINARY HYDROLOGY & HYDRAULICS SUPPLEMENTAL REPORT

MOTTE COUNTRY PLAZA City of Menifee County of Riverside, California



PREPARED FOR:

City of Menifee
Engineering Department
29844 Haun Road
Menifee, CA 92586

December, 2020

PREPARED BY:



KWC Engineers
1880 Compton Avenue, Suite 100
Corona, CA 92881
Tel : (951) 734-2130
www.kwcengineers.com

Brandon M. Barnett, RCE 78472

December, 2020

JN: 20.2112.1

City of Menifee
29844 Haun Road
Menifee, CA 92586

Attention: Ryan Fowler

Subject: Supplemental Report
to the Preliminary Hydrology and Hydraulics Report

Regarding: Motte Country Plaza
Planning Application Plot Plan No. 2018-300, Conditional Use Permit No. 2018-301 &
2018-320 and Tentative Parcel Map No. 2018-302

1.0 INTRODUCTION

This report was prepared as a supplement to the *Motte Country Plaza, TPM 2018-302, Preliminary Hydrology and Hydraulics Report*, dated May 2020, by Webb and Associates. The Motte Country Plaza Tentative Parcel Map (TPM) 2018-302, located in the City of Menifee, California proposes to split the existing parcel into two parcels. Parcel 1 is to be located on the west and parcel 2 located on the east with an existing train cart restaurant being relocated to parcel 1 and a commercial center proposed in parcel 2.

The original report prepared by Webb and Associates, only addresses the existing and proposed conditions for the commercial center proposed in parcel 2. At the request of the City of Menifee, this supplemental report is prepared to address any change in drainage conditions resulting from the relocation of the train cart restaurant into parcel 1 and to examine potential storm drain connection to the proposed Riverside County Flood Control and Water Conservation District's (RCFC) Master Drainage Plan (MDP) Line A-3, known as Romoland MDP Line A-3, to be located in Palomar Road.

2.0 EXISTING CONDITIONS

The overall existing conditions utilized in this supplemental report are the same as the conditions utilized in the original report prepared by Webb and Associates. The existing site consists of a train cart restaurant, parking areas, drive aisles, and landscaped areas. The site layout generally drains to the southwesterly corner of the site through ribbon gutters, and continuing into the parking area of TPM 2018-302. The existing condition rational method hydrologic calculations and map are included within Section 3 – Hydrologic Studies of the Preliminary Hydrology and Hydraulics Report.

3.0 PROPOSED CONDITIONS

The proposed conditions utilized in this supplemental report are generally the same as the conditions in the Preliminary Hydrology and Hydraulics Report. The proposed project condition for the site is a redeveloped commercial site within parcel 2. The existing train car restaurant is to be relocated from parcel 2 to a

western portion of parcel 1 that is currently vacant. Parcel 2 will be redeveloped to include two proposed buildings, a gas station, and parking area. The proposed drainage will mimic the existing condition flowing to the southerly side of the project through ribbon gutters. The flows will be captured in the proposed underground chambers designed to store the flow. The proposed 18-inch RCP storm drain line is proposed to convey all captured flows offsite into the 48-inch RCP Romoland-Motte Farms Storm Drain.

This supplemental report proposes an alternate storm drain alignment to convey all captured flows offsite into the future Romoland MDP Line A-3. The storm drain alignment proposed in this supplemental report will be referred to as Storm Drain Line Alternative B. The supplemental report will discuss the impacts of Storm Drain Alternative B further in **Section 3.2** and **Section 3.3**, and the impacts of the parcel 1 improvements from the relocation of the train cart restaurant in **Section 3.1**.

3.1 PARCEL 1 IMPROVEMENTS

The train car restaurant to be relocated from parcel 2 to parcel 1. KWC Engineers has evaluated the site conditions to determine the impact of the addition of the train car within Parcel 1 of the existing development. The following quantities represent the proposed train car location and the associated improvements on Parcel 1:

| | |
|--------------------------------|-------------------|
| Train Car located in Parcel 1: | 3,566 s.f. |
| Access Ramp: | 193 s.f. |
| Restrooms: | 539 s.f. |
| Utility Room: | 187 s.f. |
| Trash Enclosure: | 403 s.f. |
| Total: | 4,888 s.f. |

The train car restaurant is 3,566 square feet and during the process of moving the restaurant to the neighboring parcel, the Motte Country Plaza project proposes the construction of 193 square feet of ADA ramp, 539 square feet of train car restrooms, a 187 square foot utility room, and a 403 square foot trash enclosure. Thus, the total impervious area being added to parcel 1 is 4,888 square feet. Additionally, approximately 637 square feet of pervious pavers are provided within the drive aisle and walkway that provide access to the proposed trash enclosure area.

A comparison of existing improvements to proposed improvements for parcel 1 is summarized in Table 1.

Table 1. Parcel 1 Existing vs Proposed Improvements

| Drainage Area | Existing Condition | | Proposed Condition | | Difference (Prop – Exist) | |
|---------------|--------------------|---------------|--------------------|---------------|---------------------------|--------------|
| | Impervious (sf) | Pervious (sf) | Impervious (sf) | Pervious (sf) | Impervious (%) | Pervious (%) |
| Parcel 1 | 71,556 | 49,857 | 76,444 | 44,969 | 4.0% | 4.0% |

The proposed relocation and improvements results in a 4% increase to the impervious area. Based on the fact that any redevelopment currently proposed within Parcel 1 will have an insignificant impact on the

hydrology, KWC is proposing that the project proceeds to be conditioned utilizing the currently provided information within the application package as well as the information provided in this supplemental report.

3.2 PARCEL 2 IMPROVEMENTS

The parcel 2 improvements are generally the same as the improvements proposed within the preliminary hydrology report. Parcel 2 will be redeveloped to include two proposed buildings, gas station, and parking area. The ribbon gutters will convey all the flows into a proposed sump catch basin located at the southeasterly corner of the site. The flow continues into a MWS vault in order to be treated for water quality requirements before entering into the underground chambers. A proposed 18-inch RCP storm drain line is proposed to convey all flows offsite directly into the Romoland-Motte Farms Storm Drain. KWC Engineers proposes a Storm Drain Line Alternative B that will outlet into the RCFC Romoland MDP Line A-3.

3.3 ROMOLAND MDP LINE A-3

This supplement concludes Riverside County Flood Control and Water Conservation District's Romoland Master Drainage Plan Line A-3 will be constructed prior to the entitlement of the Motte Country Plaza project. MDP Line A-3 begins on Mclaughlin Road and ends at Malone Avenue running through Varela Lane and Palomar Road, adjacent to the project site. Romoland MDP Line A-3 is proposed to be a 6.5-foot high by 12.0 feet wide single cell reinforced concrete box (RCB) designed Caltrans standards.

The City of Menifee has requested KWC Engineers to look at an alternate storm drain alignment for the Motte Country Plaza that discharges into the future Romoland MDP Line A-3. Storm Drain Line A is the currently proposed alignment that discharges into the existing Romoland Motte Farms Storm Drain mentioned in the preliminary Hydrology Report by Webb Associates. The alignment proposes approximately 1,260 linear feet of storm drain. Storm Drain Line Alternative B is the alternate alignment that is proposed within this supplemental report. The alignment proposes approximately 320 linear feet of storm drain that outlets into the MDP Line A-3.

4.0 HYDROLOGY

KWC Engineers has evaluated the site conditions and county hydrology requirements to determine the impact of discharging into the future storm drain line. Drainage area "A" consists of Parcel 2 and a small portion of Parcel 1, which totals to 1.40 acres. According to the County of Riverside's "Hydrology Manual", the rational method is intended for use on small watersheds of less than 300 to 500-acres. The hydrology analysis was prepared using the rational method. **Table 2** summarizes the proposed condition 10 and 100-year storm event rational method results for Storm Drain Line A and Line B. Refer to the Proposed Condition Hydrology Key Map **Figure 1** in **Appendix A** for locations of the drainage areas and peak flows. Both alignment alternatives discharge 3.70 cfs during the 100-year storm event. Proposed condition rational method calculations for Storm Drain Line B can be found in **Appendix A** of the supplemental report. Rational method calculations pertaining to Storm Drain Line A will be a part of the preliminary Hydrology Report.

Table 2. Proposed Condition Peak Flow Summary

| Storm Drain Line | Drainage Area | Area (acres) | Q ₁₀ (cfs) | Q ₁₀₀ (cfs) |
|--------------------|---------------|--------------|-----------------------|------------------------|
| Storm Drain Line A | A | 1.40 | 2.55 | 3.70 |
| Storm Drain Line B | A | 1.40 | 2.55 | 3.70 |

5.0 HYDRAULICS

The proposed drainage facilities for the Motte Country Plaza development were sized for the 100-year flow rates utilizing the WSPG (Water Surface and Pressure Gradient) computer program, see **Appendix B**. Storm Drain Line A discharges into the existing Romoland Motte Farms Storm Drain in Tract 29495-1. The proposed 18-inch RCP storm drain line is proposed to convey all captured flows offsite. Storm Drain Line A’s hydraulic grade line generally stays 5 feet below ground. All flows within the storm drain will be kept underneath the ground. The proposed 18-inch RCP conveys flows east and outlets directly into the 6.5-foot high x 12-foot wide Romoland MDP-Line A-3. Storm Drain Line B’s hydraulic grade line generally stays 4 feet below ground. All flows within the storm drain will be kept underneath the ground. The existing 48-inch Romoland Motte Farms Storm Drain, and is referred to as Storm Drain Line C in the hydraulic calculations. Storm Drain Line C’s hydraulic grade line generally stays 0.5 feet below the top of the v-channel at the portion of analysis. The storm drain runs through a v-channel and the hydraulic grade is approximately 0.5 feet above the center of the v-channel. All of the flow will be kept within the v-channel.

6.0 CONCLUSIONS

Based on the future development of Romoland MDP-Line A-3, an alternate storm drain alignment has been proposed by KWC Engineers as requested by the city. Storm Drain Line A is to be constructed if the Romoland MDP Line A-3 is not constructed before the entitlement of the Motte Country Plaza project. Alternative A proposes 1,260 linear feet of storm drain to connect into the existing 48” Romoland Motte Farms Storm Drain. Line A discharges 3.70 cfs into the existing storm drain system. Storm Drain Line B is to be constructed if the Romoland MDP Line A-3 is constructed before the entitlement of the project. Alternative B proposes 320 linear feet of storm drain to connect into the future Romoland MDP Line A-3. Line B discharges 3.70 cfs into the future storm drain system. The proposed hydrology and hydraulic calculations are utilizing the currently provided information within the application package as well as the newly proposed storm drain alignment to determine the results provided within this supplemental report.


Engineer of Responsibility:

Brandon Barnett, PE, PLS
 P.E. 78472

Appendix

A

**PROPOSED CONDITION HYDROLOGY
RATIONAL METHOD & KEY MAP**

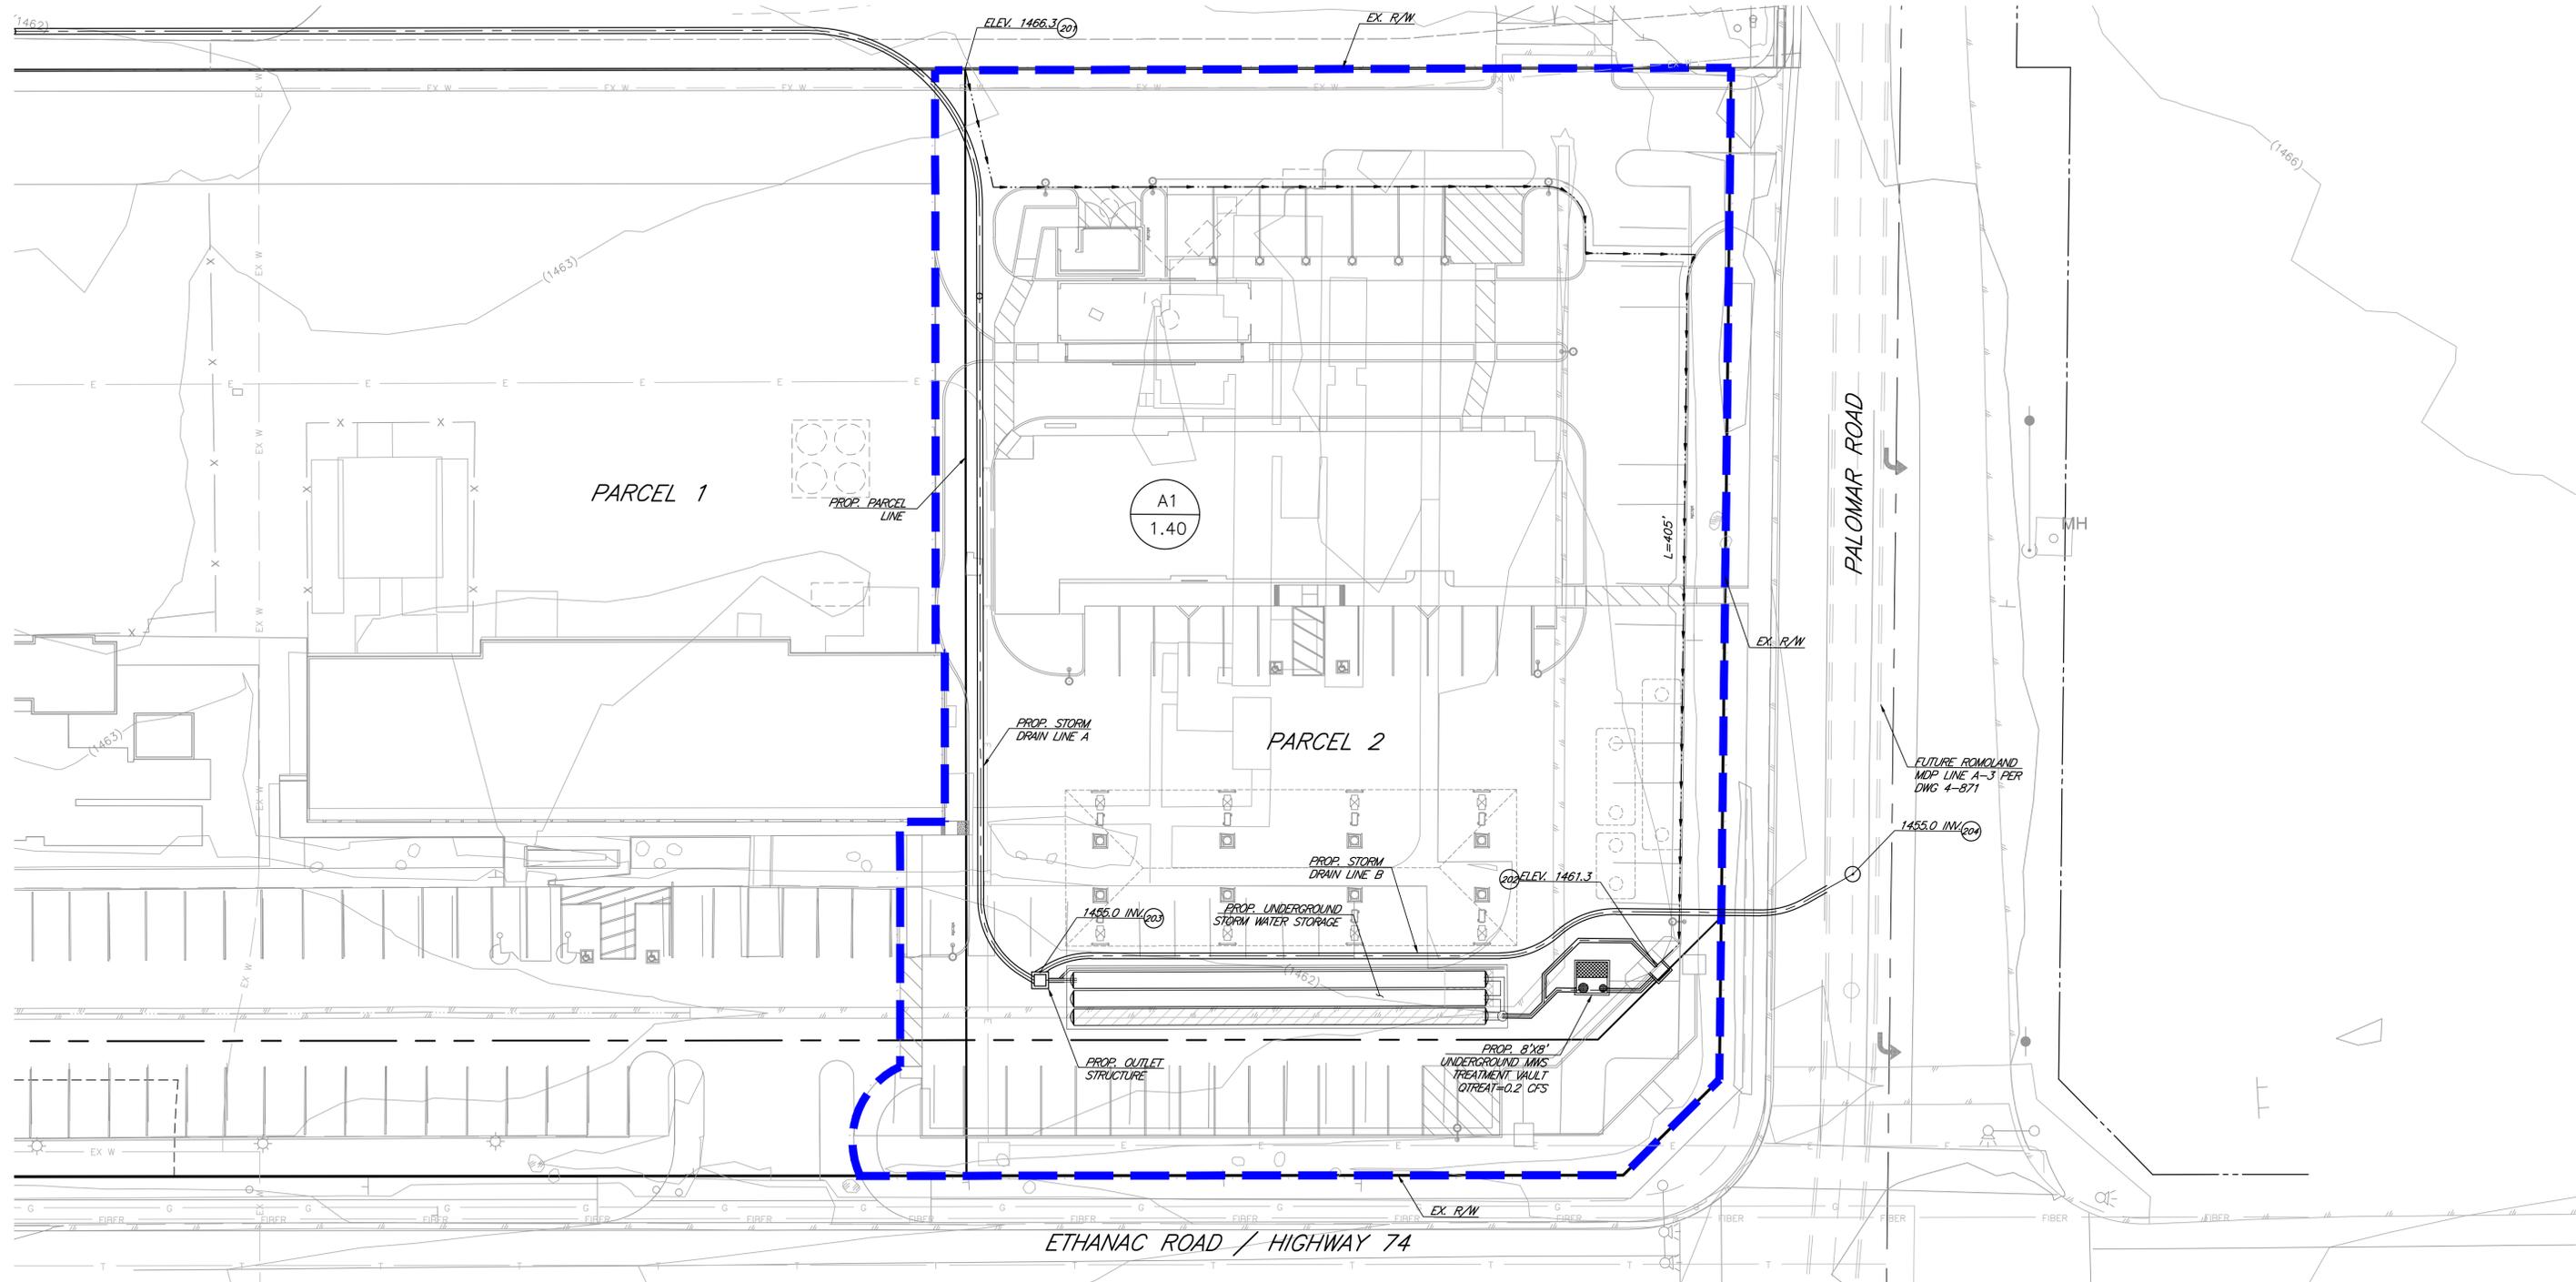

| DRAINAGE AREA A | | | | | TRIBUTARY AREA (AC.) |
|-----------------|--------------------|-----------|---------------------|-----------|----------------------|
| NODE | 10-YR STORM RUNOFF | TC (MIN.) | 100-YR STORM RUNOFF | TC (MIN.) | |
| 202 | Q10 = 2.55 CFS | - | Q100 = 3.70 CFS | - | 1.40 |
| 203 | Q10 = 2.55 CFS | - | Q100 = 3.70 CFS | - | - |
| 204 | Q10 = 2.55 CFS | - | Q100 = 3.70 CFS | - | - |

LEGEND

- MAJOR WATERSHED BOUNDARY
- MINOR WATERSHED BOUNDARY
- FLOW PATH
- SOIL BOUNDARY
- DRAINAGE AREA DESIGNATION
- ACRES
- NODE DESIGNATION
- LENGTH OF EXISTING FLOW PATH

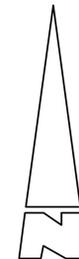


FIGURE 1

**PROPOSED CONDITION
HYDROLOGY KEY MAP**
 FOR
MOTTE COUNTRY PLAZA
 CITY OF CITY OF MENIFEE

| | | |
|------------|---|-------|
| HYD: CS | <small>CIVIL ENGINEERING, PLANNING AND CONSTRUCTION MANAGEMENT 1880 COMPTON AVENUE, SUITE 100A CORONA, CA 92881-3370 959-334-2130</small> | SHEET |
| DRAFT: CS | | 7 |
| CHECK: BMB | | OF |
| | | 1 |

R:\2012\12\12\PRELIM\REPORTS\HYDRO\2112 Prop. Hydro Key Map.dwg 12/16/2020 13:48 JOB_2112

10 YEAR PROPOSED CONDITION

Riverside County Rational Hydrology Program

CIVILCADD/CIVILDESIGN Engineering Software, (c) 1989 - 2005 Version
7.1

Rational Hydrology Study Date: 12/08/20
File:2112D10A.out

MOTTE COUNTRY PLAZA
PROPOSED CONDITION
RCFC&WCD 10-YEAR STORM
BY:CS

***** Hydrology Study Control Information *****

English (in-lb) Units used in input data file

Program License Serial Number 6062

Rational Method Hydrology Program based on
Riverside County Flood Control & Water Conservation District
1978 hydrology manual

Storm event (year) = 10.00 Antecedent Moisture Condition = 2

Standard intensity-duration curves data (Plate D-4.1)
For the [Perris Valley] area used.
10 year storm 10 minute intensity = 1.880 (In/Hr)
10 year storm 60 minute intensity = 0.780 (In/Hr)
100 year storm 10 minute intensity = 2.690 (In/Hr)
100 year storm 60 minute intensity = 1.120 (In/Hr)

Storm event year = 10.0
Calculated rainfall intensity data:
1 hour intensity = 0.780 (In/Hr)
Slope of intensity duration curve = 0.4900

++++
+++ Process from Point/Station 101.000 to Point/Station
102.000
**** INITIAL AREA EVALUATION ****

Initial area flow distance = 405.000(Ft.)
Top (of initial area) elevation = 1466.300(Ft.)
Bottom (of initial area) elevation = 1461.300(Ft.)
Difference in elevation = 5.000(Ft.)
Slope = 0.01235 s(percent)= 1.23
TC = $k(0.300)*[(length^3)/(elevation\ change)]^{0.2}$
Initial area time of concentration = 7.976 min.
Rainfall intensity = 2.097(In/Hr) for a 10.0 year storm
COMMERCIAL subarea type
Runoff Coefficient = 0.870
Decimal fraction soil group A = 0.000
Decimal fraction soil group B = 1.000
Decimal fraction soil group C = 0.000
Decimal fraction soil group D = 0.000
RI index for soil(AMC 2) = 56.00
Pervious area fraction = 0.100; Impervious fraction = 0.900
Initial subarea runoff = 2.554(CFS)
Total initial stream area = 1.400(Ac.)
Pervious area fraction = 0.100

++++
+++ Process from Point/Station 102.000 to Point/Station
103.000
**** PIPEFLOW TRAVEL TIME (Program estimated size) ****

Upstream point/station elevation = 1458.300(Ft.)
Downstream point/station elevation = 1455.000(Ft.)
Pipe length = 185.00(Ft.) Manning's N = 0.013
No. of pipes = 1 Required pipe flow = 2.554(CFS)
Nearest computed pipe diameter = 12.00(In.)
Calculated individual pipe flow = 2.554(CFS)
Normal flow depth in pipe = 6.26(In.)
Flow top width inside pipe = 11.99(In.)
Critical Depth = 8.22(In.)
Pipe flow velocity = 6.17(Ft/s)
Travel time through pipe = 0.50 min.
Time of concentration (TC) = 8.48 min.

++++
+++ Process from Point/Station 103.000 to Point/Station
104.000
**** PIPEFLOW TRAVEL TIME (Program estimated size) ****

Upstream point/station elevation = 1455.000(Ft.)
Downstream point/station elevation = 1452.420(Ft.)
Pipe length = 219.00(Ft.) Manning's N = 0.013

No. of pipes = 1 Required pipe flow = 2.554 (CFS)
Nearest computed pipe diameter = 12.00 (In.)
Calculated individual pipe flow = 2.554 (CFS)
Normal flow depth in pipe = 7.12 (In.)
Flow top width inside pipe = 11.79 (In.)
Critical Depth = 8.22 (In.)
Pipe flow velocity = 5.26 (Ft/s)
Travel time through pipe = 0.69 min.
Time of concentration (TC) = 9.17 min.
End of computations, total study area = 1.40 (Ac.)
The following figures may
be used for a unit hydrograph study of the same area.

Area averaged pervious area fraction (A_p) = 0.100
Area averaged RI index number = 56.0

100 YEAR PROPOSED CONDITION

Riverside County Rational Hydrology Program

CIVILCADD/CIVILDESIGN Engineering Software, (c) 1989 - 2005 Version
7.1

Rational Hydrology Study Date: 12/08/20
File:2112D100A.out

MOTTE COUNTRY PLAZA
PROPOSED CONDITION
RCFC&WCD 100-YEAR STORM
BY:CS

***** Hydrology Study Control Information *****

English (in-lb) Units used in input data file

Program License Serial Number 6062

Rational Method Hydrology Program based on
Riverside County Flood Control & Water Conservation District
1978 hydrology manual

Storm event (year) = 100.00 Antecedent Moisture Condition = 2

Standard intensity-duration curves data (Plate D-4.1)
For the [Perris Valley] area used.
10 year storm 10 minute intensity = 1.880 (In/Hr)
10 year storm 60 minute intensity = 0.780 (In/Hr)
100 year storm 10 minute intensity = 2.690 (In/Hr)
100 year storm 60 minute intensity = 1.120 (In/Hr)

Storm event year = 100.0
Calculated rainfall intensity data:
1 hour intensity = 1.120 (In/Hr)
Slope of intensity duration curve = 0.4900

++++
+++ Process from Point/Station 101.000 to Point/Station
102.000
**** INITIAL AREA EVALUATION ****

Initial area flow distance = 405.000(Ft.)
Top (of initial area) elevation = 1466.300(Ft.)
Bottom (of initial area) elevation = 1461.300(Ft.)
Difference in elevation = 5.000(Ft.)
Slope = 0.01235 s(percent)= 1.23
TC = $k(0.300)*[(length^3)/(elevation\ change)]^{0.2}$
Initial area time of concentration = 7.976 min.
Rainfall intensity = 3.010(In/Hr) for a 100.0 year storm
COMMERCIAL subarea type
Runoff Coefficient = 0.877
Decimal fraction soil group A = 0.000
Decimal fraction soil group B = 1.000
Decimal fraction soil group C = 0.000
Decimal fraction soil group D = 0.000
RI index for soil(AMC 2) = 56.00
Pervious area fraction = 0.100; Impervious fraction = 0.900
Initial subarea runoff = 3.695(CFS)
Total initial stream area = 1.400(Ac.)
Pervious area fraction = 0.100

++++
+++ Process from Point/Station 102.000 to Point/Station
103.000
**** PIPEFLOW TRAVEL TIME (Program estimated size) ****

Upstream point/station elevation = 1458.300(Ft.)
Downstream point/station elevation = 1455.000(Ft.)
Pipe length = 185.00(Ft.) Manning's N = 0.013
No. of pipes = 1 Required pipe flow = 3.695(CFS)
Nearest computed pipe diameter = 12.00(In.)
Calculated individual pipe flow = 3.695(CFS)
Normal flow depth in pipe = 7.95(In.)
Flow top width inside pipe = 11.35(In.)
Critical Depth = 9.83(In.)
Pipe flow velocity = 6.69(Ft/s)
Travel time through pipe = 0.46 min.
Time of concentration (TC) = 8.44 min.

++++
+++ Process from Point/Station 103.000 to Point/Station
104.000
**** PIPEFLOW TRAVEL TIME (Program estimated size) ****

Upstream point/station elevation = 1455.000(Ft.)
Downstream point/station elevation = 1452.420(Ft.)
Pipe length = 219.00(Ft.) Manning's N = 0.013


No. of pipes = 1 Required pipe flow = 3.695 (CFS)
Nearest computed pipe diameter = 12.00 (In.)
Calculated individual pipe flow = 3.695 (CFS)
Normal flow depth in pipe = 9.39 (In.)
Flow top width inside pipe = 9.91 (In.)
Critical Depth = 9.83 (In.)
Pipe flow velocity = 5.61 (Ft/s)
Travel time through pipe = 0.65 min.
Time of concentration (TC) = 9.09 min.
End of computations, total study area = 1.40 (Ac.)
The following figures may
be used for a unit hydrograph study of the same area.

Area averaged pervious area fraction (A_p) = 0.100
Area averaged RI index number = 56.0

Appendix

B

STORM DRAIN HYDRAULICS

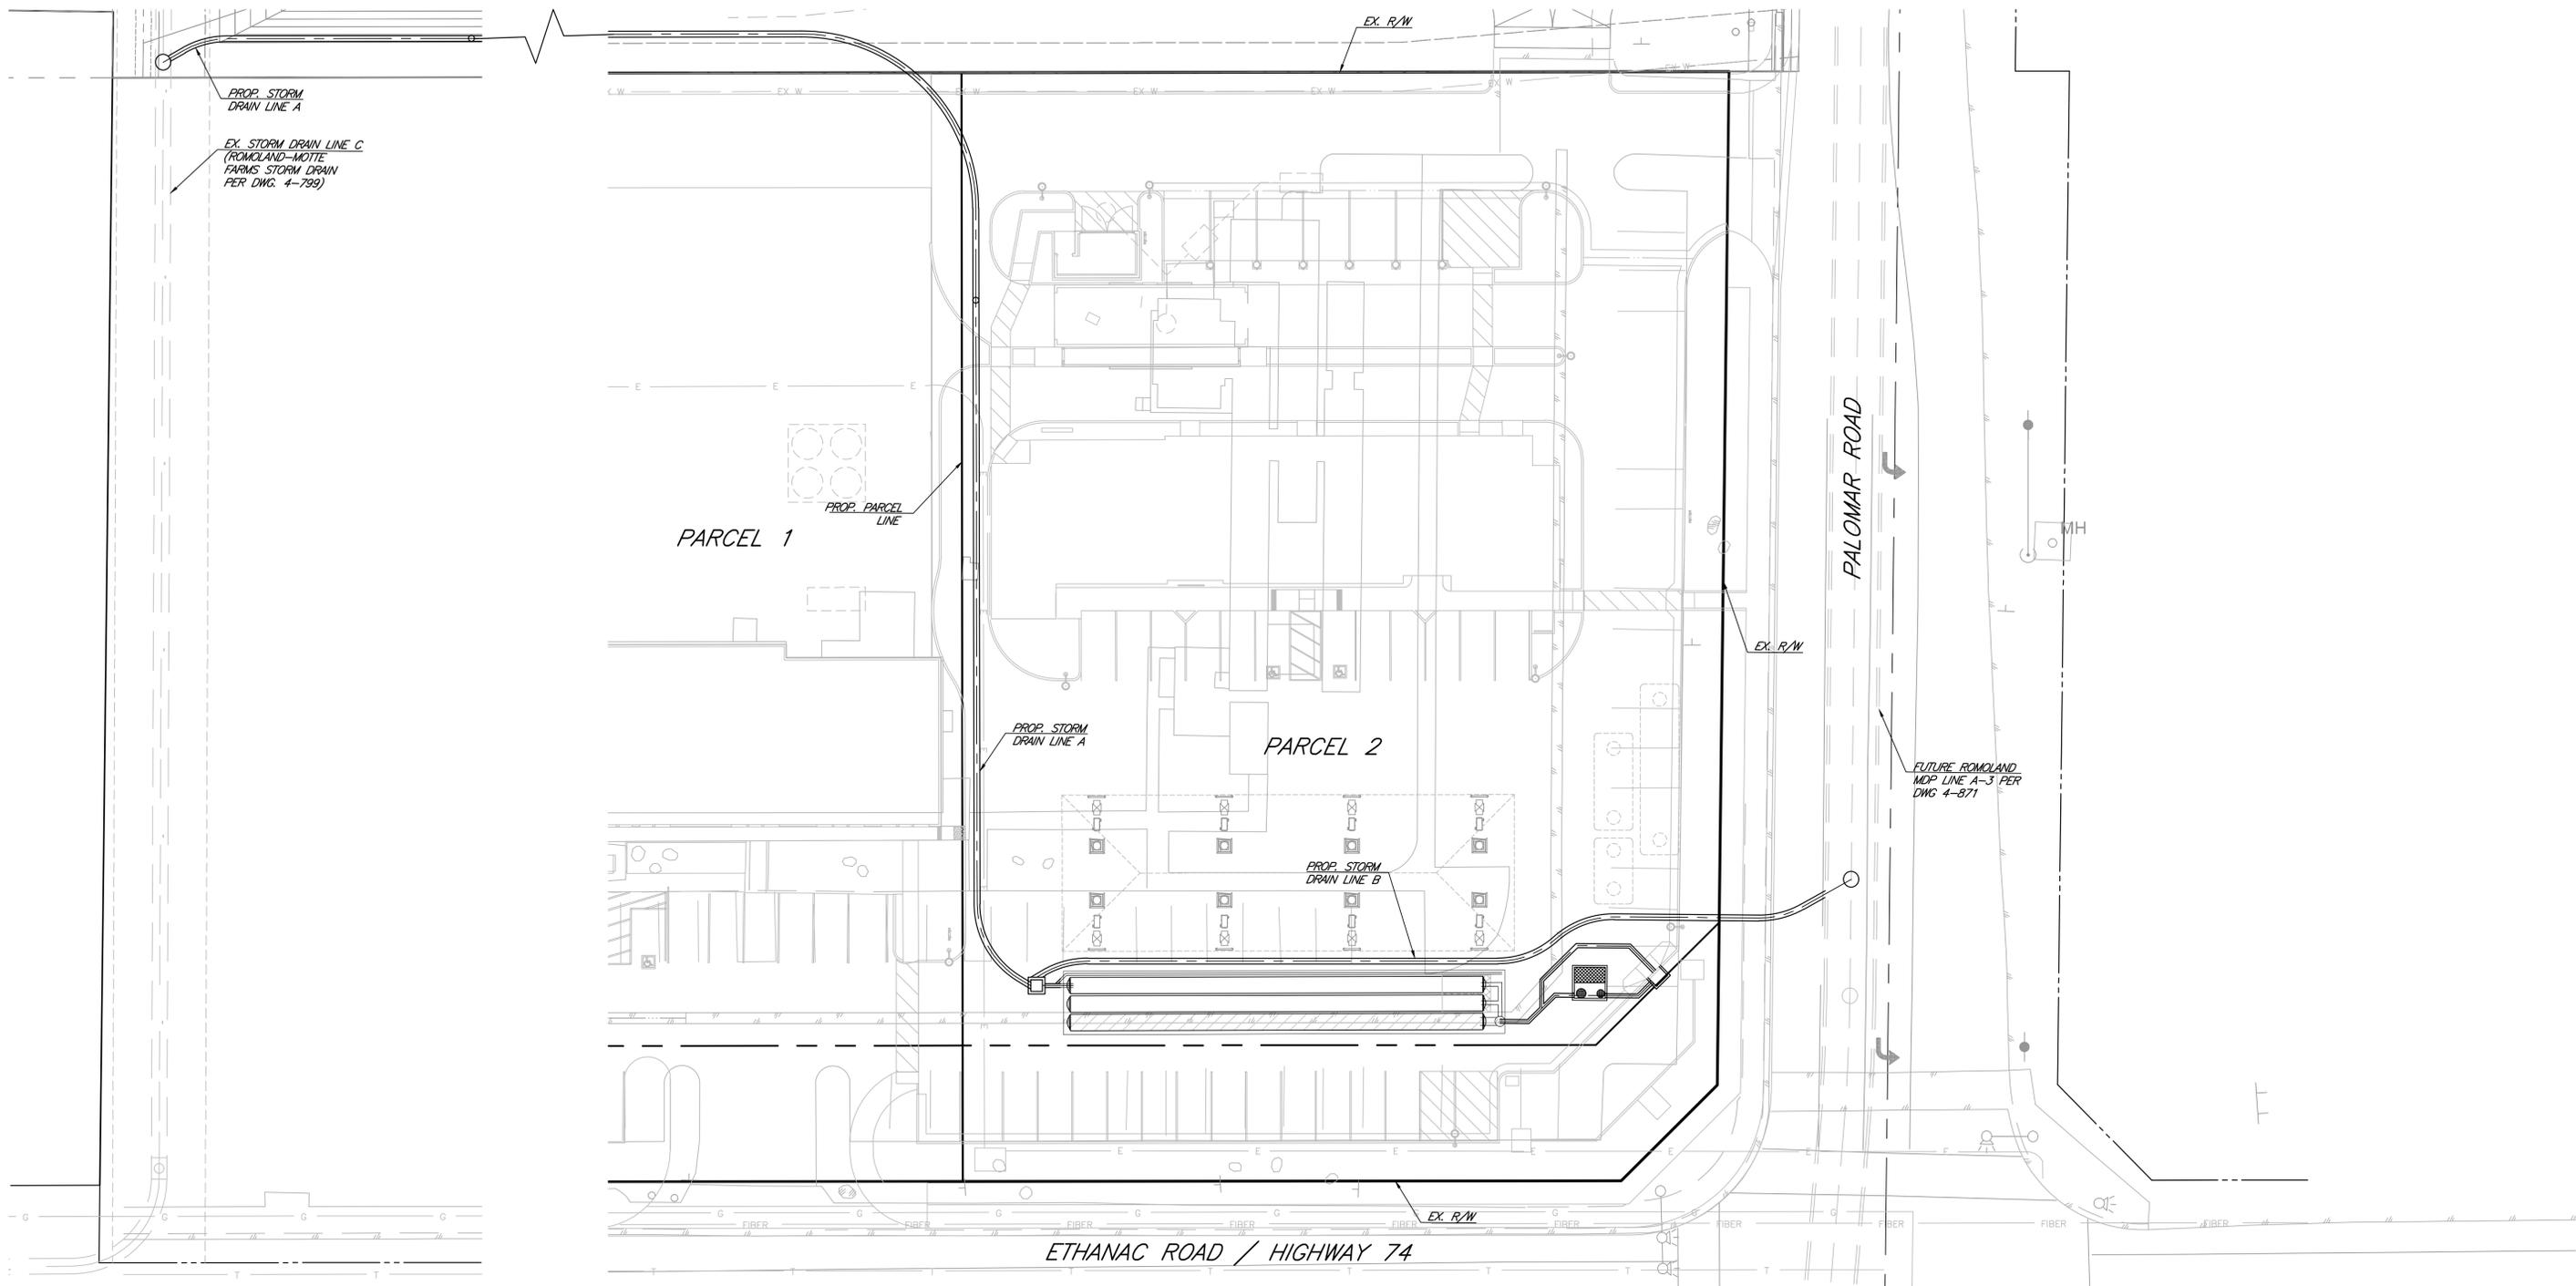

LEGEND

- BOUNDARY LINE
- - - PROPOSED PARCEL LINE
- - - EXISTING R/W
- ==== PROPOSED STORM DRAIN
- ==== EXISTING STORM DRAIN
- ==== FUTURE STORM DRAIN



STORM DRAIN LAYOUT
FOR
MOTTE COUNTRY PLAZA
CITY OF CITY OF MENIFEE



SHEET
1
OF
1

R:\20\2112\PRELIM\REPORTS\HYDRO\2112 SD Layout.dwg 12/16/2020 13:50 JOB_2112

T1 JN 20.2112.1 MOTTE COUNTRY PLAZA
 T2 CITY OF MENIFEE
 T3 STORM DRAIN LINE A - MODELED BY CS

0

| | | | | | | | | | | |
|----|----------|----------|----|------|-------|-------|----------|---------|------|-----|
| SO | 1000.000 | 1444.530 | 1 | | | | 1453.500 | | | |
| R | 1006.140 | 1444.590 | 1 | .013 | | | | .000 | .000 | 0 |
| R | 1017.810 | 1444.710 | 1 | .013 | | | | 29.700 | .000 | 0 |
| R | 1079.080 | 1445.320 | 1 | .013 | | | | .000 | .000 | 0 |
| JX | 1083.080 | 1445.330 | 2 | .013 | | | | | | |
| R | 1679.080 | 1451.490 | 1 | .013 | | | | .000 | .000 | 0 |
| JX | 1683.080 | 1451.500 | 3 | .013 | | | | | | |
| R | 1886.690 | 1453.190 | 3 | .013 | | | | .000 | .000 | 0 |
| R | 1957.360 | 1453.970 | 3 | .013 | | | | 89.970 | .000 | 0 |
| R | 1979.080 | 1454.080 | 1 | .013 | | | | .000 | .000 | 0 |
| JX | 1983.080 | 1454.090 | 4 | .013 | | | | | | |
| R | 2136.660 | 1454.870 | 4 | .013 | | | | .000 | .000 | 0 |
| R | 2160.200 | 1454.990 | 4 | .013 | | | | -59.950 | .000 | 0 |
| R | 2163.250 | 1455.000 | 4 | .013 | | | | .000 | .000 | 0 |
| WE | 2163.250 | 1455.000 | 5 | .200 | | | | | | |
| SH | 2163.250 | 1455.000 | 5 | | | | 1458.420 | | | |
| CD | 1 | 4 | 1 | .000 | 1.500 | .000 | .000 | .000 | .000 | .00 |
| CD | 2 | 4 | 1 | .000 | 1.500 | .000 | .000 | .000 | .000 | .00 |
| CD | 3 | 4 | 1 | .000 | 1.500 | .000 | .000 | .000 | .000 | .00 |
| CD | 4 | 4 | 1 | .000 | 1.500 | .000 | .000 | .000 | .000 | .00 |
| CD | 5 | 3 | 0 | .000 | 7.810 | 4.330 | .000 | .000 | .000 | .00 |
| Q | | 3.700 | .0 | | | | | | | |

STORM DRAIN LINE A - MODELED BY CS

| Station | Invert Elev | Depth (FT) | Water Elev | Q (CFS) | Vel (FPS) | Vel Head | Energy Grd.El. | Super Elev | Critical Depth | Flow Top Width | Height/Dia.-FT | Base Wt/ I.D. | ZL | No Wth Prs/Pip |
|-----------|-------------|------------|------------|---------|-----------|----------|----------------|------------|----------------|----------------|----------------|---------------|-----|----------------|
| L/Elem | Ch Slope | | | | | SF Ave | HF | SE Dpth | Froude N | Norm Dp | "N" | X-Fall | ZR | Type Ch |
| 1000.000 | 1444.530 | 8.970 | 1453.500 | 3.70 | 2.09 | .07 | 1453.57 | .00 | .73 | .00 | 1.500 | .000 | .00 | 1 .0 |
| 6.140 | .0098 | | | | | .0012 | .01 | 8.97 | .00 | .62 | .013 | .00 | .00 | PIPE |
| 1006.140 | 1444.590 | 8.918 | 1453.508 | 3.70 | 2.09 | .07 | 1453.58 | .00 | .73 | .00 | 1.500 | .000 | .00 | 1 .0 |
| 11.670 | .0103 | | | | | .0012 | .01 | .00 | .00 | .61 | .013 | .00 | .00 | PIPE |
| 1017.810 | 1444.710 | 8.820 | 1453.530 | 3.70 | 2.09 | .07 | 1453.60 | .00 | .73 | .00 | 1.500 | .000 | .00 | 1 .0 |
| 61.270 | .0100 | | | | | .0012 | .08 | 8.82 | .00 | .62 | .013 | .00 | .00 | PIPE |
| 1079.080 | 1445.320 | 8.286 | 1453.606 | 3.70 | 2.09 | .07 | 1453.67 | .00 | .73 | .00 | 1.500 | .000 | .00 | 1 .0 |
| JUNCT STR | .0025 | | | | | .0012 | .00 | 8.29 | .00 | .00 | .013 | .00 | .00 | PIPE |
| 1083.080 | 1445.330 | 8.281 | 1453.611 | 3.70 | 2.09 | .07 | 1453.68 | .00 | .73 | .00 | 1.500 | .000 | .00 | 1 .0 |
| 596.000 | .0103 | | | | | .0012 | .74 | 8.28 | .00 | .61 | .013 | .00 | .00 | PIPE |
| 1679.080 | 1451.490 | 2.860 | 1454.350 | 3.70 | 2.09 | .07 | 1454.42 | .00 | .73 | .00 | 1.500 | .000 | .00 | 1 .0 |
| JUNCT STR | .0025 | | | | | .0012 | .00 | 2.86 | .00 | .00 | .013 | .00 | .00 | PIPE |
| 1683.080 | 1451.500 | 2.855 | 1454.355 | 3.70 | 2.09 | .07 | 1454.42 | .00 | .73 | .00 | 1.500 | .000 | .00 | 1 .0 |
| 191.985 | .0083 | | | | | .0012 | .24 | 2.86 | .00 | .65 | .013 | .00 | .00 | PIPE |
| 1875.065 | 1453.094 | 1.500 | 1454.594 | 3.70 | 2.09 | .07 | 1454.66 | .00 | .73 | .00 | 1.500 | .000 | .00 | 1 .0 |
| 11.625 | .0083 | | | | | .0011 | .01 | 1.50 | .00 | .65 | .013 | .00 | .00 | PIPE |
| 1886.690 | 1453.190 | 1.413 | 1454.603 | 3.70 | 2.14 | .07 | 1454.67 | .00 | .73 | .70 | 1.500 | .000 | .00 | 1 .0 |
| 8.771 | .0110 | | | | | .0011 | .01 | 1.41 | .24 | .60 | .013 | .00 | .00 | PIPE |

WATER SURFACE PROFILE LISTING
JN 20.2112.1 MOTTE COUNTRY PLAZA
CITY OF MENIFEE

Date:12- 9-2020 Time:11:25:26

STORM DRAIN LINE A - MODELED BY CS

```

*****
| Invert | Depth | Water | Q | Vel | Vel | Energy | Super | Critical | Flow Top | Height/ | Base Wt | | No Wth |
Station | Elev | (FT) | Elev | (CFS) | (FPS) | Head | Grd.El. | Elev | Depth | Width | Dia.-FT | or I.D. | ZL | Prs/Pip |
|-----|-----|-----|-----|-----|-----|-----|-----|-----|-----|-----|-----|-----|-----|-----|
L/Elem | Ch Slope | | | | | SF Ave | HF | SE Dpth | Froude N | Norm Dp | "N" | X-Fall | ZR | Type Ch |
*****|*****|*****|*****|*****|*****|*****|*****|*****|*****|*****|*****|*****|*****|*****|
|-----|-----|-----|-----|-----|-----|-----|-----|-----|-----|-----|-----|-----|-----|-----|
1895.461 | 1453.287 | 1.318 | 1454.605 | 3.70 | 2.25 | .08 | 1454.68 | .00 | .73 | .98 | 1.500 | .000 | .00 | 1 | .0 |
|-----|-----|-----|-----|-----|-----|-----|-----|-----|-----|-----|-----|-----|-----|-----|
6.548 | .0110 | | | | | .0012 | .01 | 1.32 | .31 | .60 | .013 | .00 | .00 | PIPE |
|-----|-----|-----|-----|-----|-----|-----|-----|-----|-----|-----|-----|-----|-----|-----|
1902.010 | 1453.359 | 1.246 | 1454.605 | 3.70 | 2.36 | .09 | 1454.69 | .00 | .73 | 1.13 | 1.500 | .000 | .00 | 1 | .0 |
|-----|-----|-----|-----|-----|-----|-----|-----|-----|-----|-----|-----|-----|-----|-----|
5.475 | .0110 | | | | | .0013 | .01 | 1.25 | .35 | .60 | .013 | .00 | .00 | PIPE |
|-----|-----|-----|-----|-----|-----|-----|-----|-----|-----|-----|-----|-----|-----|-----|
1907.485 | 1453.419 | 1.184 | 1454.603 | 3.70 | 2.47 | .10 | 1454.70 | .01 | .73 | 1.22 | 1.500 | .000 | .00 | 1 | .0 |
|-----|-----|-----|-----|-----|-----|-----|-----|-----|-----|-----|-----|-----|-----|-----|
4.746 | .0110 | | | | | .0014 | .01 | 1.19 | .39 | .60 | .013 | .00 | .00 | PIPE |
|-----|-----|-----|-----|-----|-----|-----|-----|-----|-----|-----|-----|-----|-----|-----|
1912.231 | 1453.472 | 1.129 | 1454.600 | 3.70 | 2.59 | .10 | 1454.70 | .01 | .73 | 1.29 | 1.500 | .000 | .00 | 1 | .0 |
|-----|-----|-----|-----|-----|-----|-----|-----|-----|-----|-----|-----|-----|-----|-----|
4.197 | .0110 | | | | | .0016 | .01 | 1.13 | .44 | .60 | .013 | .00 | .00 | PIPE |
|-----|-----|-----|-----|-----|-----|-----|-----|-----|-----|-----|-----|-----|-----|-----|
1916.428 | 1453.518 | 1.078 | 1454.597 | 3.70 | 2.72 | .11 | 1454.71 | .01 | .73 | 1.35 | 1.500 | .000 | .00 | 1 | .0 |
|-----|-----|-----|-----|-----|-----|-----|-----|-----|-----|-----|-----|-----|-----|-----|
3.738 | .0110 | | | | | .0018 | .01 | 1.09 | .48 | .60 | .013 | .00 | .00 | PIPE |
|-----|-----|-----|-----|-----|-----|-----|-----|-----|-----|-----|-----|-----|-----|-----|
1920.166 | 1453.559 | 1.032 | 1454.592 | 3.70 | 2.85 | .13 | 1454.72 | .01 | .73 | 1.39 | 1.500 | .000 | .00 | 1 | .0 |
|-----|-----|-----|-----|-----|-----|-----|-----|-----|-----|-----|-----|-----|-----|-----|
3.335 | .0110 | | | | | .0020 | .01 | 1.04 | .52 | .60 | .013 | .00 | .00 | PIPE |
|-----|-----|-----|-----|-----|-----|-----|-----|-----|-----|-----|-----|-----|-----|-----|
1923.501 | 1453.596 | .989 | 1454.586 | 3.70 | 2.99 | .14 | 1454.72 | .01 | .73 | 1.42 | 1.500 | .000 | .00 | 1 | .0 |
|-----|-----|-----|-----|-----|-----|-----|-----|-----|-----|-----|-----|-----|-----|-----|
2.968 | .0110 | | | | | .0022 | .01 | 1.00 | .57 | .60 | .013 | .00 | .00 | PIPE |
|-----|-----|-----|-----|-----|-----|-----|-----|-----|-----|-----|-----|-----|-----|-----|
1926.469 | 1453.629 | .949 | 1454.578 | 3.70 | 3.14 | .15 | 1454.73 | .01 | .73 | 1.45 | 1.500 | .000 | .00 | 1 | .0 |
|-----|-----|-----|-----|-----|-----|-----|-----|-----|-----|-----|-----|-----|-----|-----|
2.622 | .0110 | | | | | .0025 | .01 | .96 | .61 | .60 | .013 | .00 | .00 | PIPE |
|-----|-----|-----|-----|-----|-----|-----|-----|-----|-----|-----|-----|-----|-----|-----|
1929.091 | 1453.658 | .911 | 1454.569 | 3.70 | 3.29 | .17 | 1454.74 | .01 | .73 | 1.46 | 1.500 | .000 | .00 | 1 | .0 |
|-----|-----|-----|-----|-----|-----|-----|-----|-----|-----|-----|-----|-----|-----|-----|
2.197 | .0110 | | | | | .0028 | .01 | .92 | .66 | .60 | .013 | .00 | .00 | PIPE |

```

STORM DRAIN LINE A - MODELED BY CS

| Station | Invert Elev | Depth (FT) | Water Elev | Q (CFS) | Vel (FPS) | Vel Head | Energy Grd.El. | Super Elev | Critical Depth | Flow Top Width | Height/Dia.-FT | Base Wt/ I.D. | No ZL | Wth Prs/Pip |
|----------------|-------------|------------|------------|---------|-----------|----------|----------------|------------|----------------|----------------|----------------|---------------|-------|-------------|
| L/Elem | Ch Slope | | | | | SF Ave | HF | SE Dpth | Froude N | Norm Dp | "N" | X-Fall | ZR | Type Ch |
| 1931.287 | 1453.682 | .876 | 1454.558 | 3.70 | 3.45 | .19 | 1454.74 | .01 | .73 | 1.48 | 1.500 | .000 | .00 | 1 .0 |
| HYDRAULIC JUMP | | | | | | | | | | | | | | |
| 1931.287 | 1453.682 | .598 | 1454.281 | 3.70 | 5.63 | .49 | 1454.77 | .03 | .73 | 1.47 | 1.500 | .000 | .00 | 1 .0 |
| 2.363 | .0110 | | | | | .0106 | .03 | .63 | 1.48 | .60 | .013 | .00 | .00 | PIPE |
| 1933.650 | 1453.708 | .612 | 1454.320 | 3.70 | 5.46 | .46 | 1454.78 | .03 | .73 | 1.47 | 1.500 | .000 | .00 | 1 .0 |
| 13.462 | .0110 | | | | | .0096 | .13 | .64 | 1.42 | .60 | .013 | .00 | .00 | PIPE |
| 1947.112 | 1453.857 | .634 | 1454.491 | 3.70 | 5.21 | .42 | 1454.91 | .03 | .73 | 1.48 | 1.500 | .000 | .00 | 1 .0 |
| 5.651 | .0110 | | | | | .0084 | .05 | .66 | 1.33 | .60 | .013 | .00 | .00 | PIPE |
| 1952.763 | 1453.919 | .657 | 1454.577 | 3.70 | 4.97 | .38 | 1454.96 | .03 | .73 | 1.49 | 1.500 | .000 | .00 | 1 .0 |
| 2.851 | .0110 | | | | | .0074 | .02 | .68 | 1.24 | .60 | .013 | .00 | .00 | PIPE |
| 1955.614 | 1453.951 | .682 | 1454.633 | 3.70 | 4.74 | .35 | 1454.98 | .02 | .73 | 1.49 | 1.500 | .000 | .00 | 1 .0 |
| 1.354 | .0110 | | | | | .0065 | .01 | .70 | 1.15 | .60 | .013 | .00 | .00 | PIPE |
| 1956.968 | 1453.966 | .707 | 1454.673 | 3.70 | 4.52 | .32 | 1454.99 | .02 | .73 | 1.50 | 1.500 | .000 | .00 | 1 .0 |
| .392 | .0110 | | | | | .0057 | .00 | .73 | 1.08 | .60 | .013 | .00 | .00 | PIPE |
| 1957.360 | 1453.970 | .735 | 1454.705 | 3.70 | 4.30 | .29 | 1454.99 | .00 | .73 | 1.50 | 1.500 | .000 | .00 | 1 .0 |
| 2.998 | .0051 | | | | | .0052 | .02 | .73 | 1.00 | .75 | .013 | .00 | .00 | PIPE |
| 1960.358 | 1453.985 | .746 | 1454.731 | 3.70 | 4.22 | .28 | 1455.01 | .00 | .73 | 1.50 | 1.500 | .000 | .00 | 1 .0 |
| 18.722 | .0051 | | | | | .0050 | .09 | .75 | .97 | .75 | .013 | .00 | .00 | PIPE |

Program Package Serial Number: 1873

WATER SURFACE PROFILE LISTING

Date:12- 9-2020 Time:11:25:26

JN 20.2112.1 MOTTE COUNTRY PLAZA

CITY OF MENIFEE

STORM DRAIN LINE A - MODELED BY CS

```

*****
| Invert | Depth | Water | Q | Vel | Vel | Energy | Super |Critical|Flow Top|Height/|Base Wt| |No Wth
Station | Elev | (FT) | Elev | (CFS) | (FPS) | Head | Grd.El.| Elev | Depth | Width | Dia.-FT|or I.D.| ZL |Prs/Pip
-|- -|- -|- -|- -|- -|- -|- -|- -|- -|- -|- -|- -|- -|-
L/Elem |Ch Slope | | | | | SF Ave| HF |SE Dpth|Froude N|Norm Dp | "N" | X-Fall| ZR |Type Ch
*****|*****|*****|*****|*****|*****|*****|*****|*****|*****|*****|*****|*****|*****|*****|*****
| | | | | | | | | | | | | | | |
2163.250 1455.000 1.143 1456.143 3.70 .75 .01 1456.15 .00 .28 4.33 7.810 4.330 .00 0 .0
-|- -|- -|- -|- -|- -|- -|- -|- -|- -|- -|- -|-
    
```

T1 JN 20.2112.1 MOTTE COUNTRY PLAZA
 T2 CITY OF MENIFEE
 T3 STORM DRAIN LINE B - MODELED BY CS

0

| | | | | | | | | | | | | | |
|----|----------|----------|---|-------|-------|-------|------|------|---------|----------|------|---|----------|
| SO | 1000.000 | 1453.420 | 1 | | | | | | | 1458.250 | | | |
| R | 1014.460 | 1453.530 | 1 | .013 | | | | | .000 | | .000 | 0 | |
| R | 1026.160 | 1453.610 | 1 | .013 | | | | | 29.800 | | .000 | 0 | |
| R | 1063.630 | 1453.880 | 1 | .013 | | | | | .000 | | .000 | 0 | |
| R | 1080.200 | 1454.000 | 1 | .013 | | | | | -42.190 | | .000 | 0 | |
| R | 1096.580 | 1454.120 | 1 | .013 | | | | | 41.720 | | .000 | 0 | |
| R | 1202.750 | 1454.890 | 1 | .013 | | | | | .000 | | .000 | 0 | |
| R | 1214.530 | 1454.980 | 1 | .013 | | | | | -30.000 | | .000 | 0 | |
| R | 1216.790 | 1455.000 | 1 | .013 | | | | | .000 | | .000 | 0 | |
| WE | 1216.790 | 1455.000 | 2 | .200 | | | | | | | | | |
| SH | 1216.790 | 1455.000 | 2 | | | | | | | | | | 1458.420 |
| CD | 1 | 4 | 1 | .000 | 1.500 | .000 | .000 | .000 | .00 | | | | |
| CD | 2 | 3 | 0 | .000 | 7.810 | 4.330 | .000 | .000 | .00 | | | | |
| Q | | | | 3.700 | .0 | | | | | | | | |

WATER SURFACE PROFILE LISTING

JN 20.2112.1 MOTTE COUNTRY PLAZA

CITY OF MENIFEE

STORM DRAIN LINE B - MODELED BY CS

```

*****
| Invert | Depth | Water | Q | Vel | Vel | Energy | Super |Critical|Flow Top|Height/|Base Wt| |No Wth
Station | Elev | (FT) | Elev | (CFS) | (FPS) | Head | Grd.El.| Elev | Depth | Width | Dia.-FT|or I.D.| ZL |Prs/Pip
-|- -|- -|- -|- -|- -|- -|- -|- -|- -|- -|- -|- -|- -|-
L/Elem |Ch Slope | | | | | SF Ave| HF |SE Dpth|Froude N|Norm Dp | "N" | X-Fall| ZR |Type Ch
*****|*****|*****|*****|*****|*****|*****|*****|*****|*****|*****|*****|*****|*****|*****|*****
| | | | | | | | | | | | | | | |
1216.790 1455.000 3.635 1458.635 3.70 .24 .00 1458.64 .00 .28 4.33 7.810 4.330 .00 0 .0
-|- -|- -|- -|- -|- -|- -|- -|- -|- -|- -|- -|-
    
```


JN 20.2112.1 MOTTE COUNTRY PLAZA

CITY OF MENIFEE

EXISTING STORM DRAIN LINE C - MODELED BY CS

```

*****
| Invert | Depth | Water | Q | Vel | Vel | Energy | Super | Critical | Flow Top | Height/ | Base Wt | | No Wth
Station | Elev | (FT) | Elev | (CFS) | (FPS) | Head | Grd.El. | Elev | Depth | Width | Dia.-FT | or I.D. | ZL | Prs/Pip
|-----|-----|-----|-----|-----|-----|-----|-----|-----|-----|-----|-----|-----|-----|-----|
L/Elem | Ch Slope | | | | | SF Ave | HF | SE Dpth | Froude N | Norm Dp | "N" | X-Fall | ZR | Type Ch
*****|*****|*****|*****|*****|*****|*****|*****|*****|*****|*****|*****|*****|*****|*****|
2972.620 | 1443.680 | 9.320 | 1453.000 | 52.80 | 4.20 | .27 | 1453.27 | .00 | 2.18 | .00 | 4.000 | .000 | .00 | 1 | .0
|-----|-----|-----|-----|-----|-----|-----|-----|-----|-----|-----|-----|-----|-----|-----|
296.640 | .0030 | | | | | .0014 | .40 | 9.32 | .00 | 2.40 | .013 | .00 | .00 | PIPE
|-----|-----|-----|-----|-----|-----|-----|-----|-----|-----|-----|-----|-----|-----|-----|
3269.260 | 1444.570 | 8.831 | 1453.401 | 52.80 | 4.20 | .27 | 1453.67 | .00 | 2.18 | .00 | 4.000 | .000 | .00 | 1 | .0
|-----|-----|-----|-----|-----|-----|-----|-----|-----|-----|-----|-----|-----|-----|-----|
31.500 | .0032 | | | | | .0014 | .04 | .00 | .00 | 2.35 | .013 | .00 | .00 | PIPE
|-----|-----|-----|-----|-----|-----|-----|-----|-----|-----|-----|-----|-----|-----|-----|
3300.760 | 1444.670 | 8.810 | 1453.480 | 52.80 | 4.20 | .27 | 1453.75 | .00 | 2.18 | .00 | 4.000 | .000 | .00 | 1 | .0
|-----|-----|-----|-----|-----|-----|-----|-----|-----|-----|-----|-----|-----|-----|-----|
31.410 | .0029 | | | | | .0014 | .04 | .00 | .00 | 2.44 | .013 | .00 | .00 | PIPE
|-----|-----|-----|-----|-----|-----|-----|-----|-----|-----|-----|-----|-----|-----|-----|
3332.170 | 1444.760 | 8.799 | 1453.559 | 52.80 | 4.20 | .27 | 1453.83 | .00 | 2.18 | .00 | 4.000 | .000 | .00 | 1 | .0
|-----|-----|-----|-----|-----|-----|-----|-----|-----|-----|-----|-----|-----|-----|-----|
JUNCT STR | .0036 | | | | | .0000 | .00 | .00 | .00 | .013 | .00 | .00 | PIPE
----- WARNING - Junction Analysis - Change in Channel Type -----
WALL ENTRANCE
|-----|-----|-----|-----|-----|-----|-----|-----|-----|-----|-----|-----|-----|-----|-----|
3337.670 | 1444.780 | 9.038 | 1453.818 | 52.80 | 1.11 | .02 | 1453.84 | .00 | 1.42 | 5.50 | | | | |

```

Appendix

C

REFERENCE MATERIAL

GENERAL NOTES RIVERSIDE COUNTY FLOOD CONTROL AND WATER CONSERVATION DISTRICT ROMOLAND MOTTE FARMS STORM DRAIN

- THE CONTRACTOR SHALL CONSTRUCT THE FLOOD CONTROL IMPROVEMENTS SHOWN ON THE DRAWINGS IN CONFORMANCE WITH THE REQUIREMENTS OF THE RIVERSIDE COUNTY FLOOD CONTROL AND WATER CONSERVATION DISTRICT'S SPECIAL PROVISIONS AND DETAILED SPECIFICATIONS DATED SEPTEMBER 1984, AND DESIGN MANUAL STANDARD DRAWINGS DATED MAY 1971.
- AN ENCROACHMENT PERMIT IS REQUIRED FROM RIVERSIDE COUNTY FLOOD CONTROL. CONTACT ED LOTZ AT (909) 955-1266. AFTER THE PERMIT IS ISSUED THE DISTRICT MUST BE NOTIFIED TWO WEEKS PRIOR TO CONSTRUCTION.
- CONSTRUCTION INSPECTION WILL BE PERFORMED BY RIVERSIDE COUNTY FLOOD CONTROL. CONTACT DALE ANDERSON AT (909) 955-1288. (THE DISTRICT MUST BE NOTIFIED 20 DAYS PRIOR TO CONSTRUCTION.)
- ALL STATIONING REFERS TO CENTERLINE OF CONSTRUCTION UNLESS OTHERWISE NOTIFIED.
- STATIONING FOR LATERALS AND CONNECTOR PIPE REFER TO THE CENTERLINE-CENTERLINE INTERSECTION STATION.
- FORTY-EIGHT HOURS BEFORE EXCAVATION, CALL UNDERGROUND SERVICE ALERT 1-800-227-2600
- ALL ELEVATIONS SHOWN ARE IN FEET AND DECIMALS THEREOF BASED ON U.S.C. & G.S. DATUM.
- ALL CROSS SECTIONS ARE TAKEN LOOKING DOWNSTREAM.
- ELEVATIONS OF UTILITIES ARE APPROXIMATE UNLESS OTHERWISE NOTED.
- OPENINGS RESULTING FROM THE CUTTING OR PARTIAL REMOVAL OF EXISTING CULVERTS, PIPES OR SIMILAR STRUCTURES TO BE ABANDONED SHALL BE SEALED WITH 6" OF CLASS "B" CONCRETE.
- PIPE CONNECTED TO THE MAINLINE PIPE SHALL CONFORM TO JUNCTION STRUCTURE NO. 4 (JS 229) UNLESS OTHERWISE NOTED.
- BEDDING PIPE SHALL CONFORM TO R.C.F.C. & W.C.D. STD. M815, EXCEPT FOR COVER < 2 FEET. FOR COVER < 2 FEET, CONCRETE SLURRY (2000 PSI - 2 SACK) SHALL BE USED. THE ENTIRE TRENCH SHALL BE SLURRY EXTENDING 4 INCHES MINIMUM AND 12 INCHES MAXIMUM ABOVE THE TOP OF THE PIPE.
- ALL EXCAVATION, BEDDING & BACKFILL FOR THESE PLANS SHALL BE PERFORMED PER THE SOILS REPORT BY JOHN R. BYERLY INCORPORATED DATED JANUARY 9, 1991.
- "V" IS THE DEPTH OF INLET OF CATCH BASINS MEASURED FROM THE TOP OF CURB TO INVERT OF CONNECTOR PIPE.
- CATCH BASINS SHALL BE LOCATED SO THAT LOCAL DEPRESSION SHALL BEGIN AT EXISTING CURB RETURN JOINT, UNLESS OTHERWISE SPECIFIED.
- ALL CURBS, GUTTERS, SIDEWALKS, DRIVEWAYS AND OTHER EXISTING IMPROVEMENTS TO BE RECONSTRUCTED IN KIND AND AT THE SAME ELEVATION AND LOCATION AS THE EXISTING IMPROVEMENTS UNLESS OTHERWISE NOTED.
- TEMPORARY EROSION CONTROL MEASURES SHALL BE IMPLEMENTED IMMEDIATELY FOLLOWING ROUGH GRADING TO PREVENT DEPOSITION OF DEBRIS ONTO DOWNSTREAM PROPERTIES OR DRAINAGE FACILITIES.


NOTICE:
THE CONTRACTOR SHALL NOTIFY THE DISTRICT IN WRITING A MINIMUM OF 20 DAYS BEFORE BEGINNING CONSTRUCTION, AND SHALL NOT BEGIN CONSTRUCTION BEFORE OBTAINING AUTHORIZATION TO PROCEED.

THE CONTRACTOR SHALL CONSTRUCT THE FLOOD CONTROL IMPROVEMENTS SHOWN ON THE DRAWING IN CONFORMANCE WITH THE REQUIREMENTS OF THE RIVERSIDE COUNTY FLOOD CONTROL AND WATER CONSERVATION DISTRICT'S M.O.U. STANDARD SPECIFICATIONS, DATED SEPTEMBER 1984, AND DESIGN MANUAL STD. DRAWINGS, RECENT EDITION.

THE FOLLOWING ITEMS ARE TO BE INSPECTED AND MAINTAINED BY RIVERSIDE COUNTY FLOOD CONTROL AND WATER CONSERVATION DISTRICT.

48" RCP FROM STA. 29+67.12 TO STA. 43+54.66 AS SHOWN ON SHEETS 3-6
ALL MANHOLES AND OTHER STRUCTURES REQUIRED TO COMPLETE THE CONSTRUCTION OF THE ABOVE MENTIONED MAINLINE PIPE. EXCLUDING CATCH BASINS AND CONNECTOR PIPES.

NOTE: WORK CONTAINED WITHIN THESE PLANS SHALL NOT COMMENCE UNTIL AN ENCROACHMENT PERMIT AND/OR GRADING PERMIT HAS BEEN ISSUED

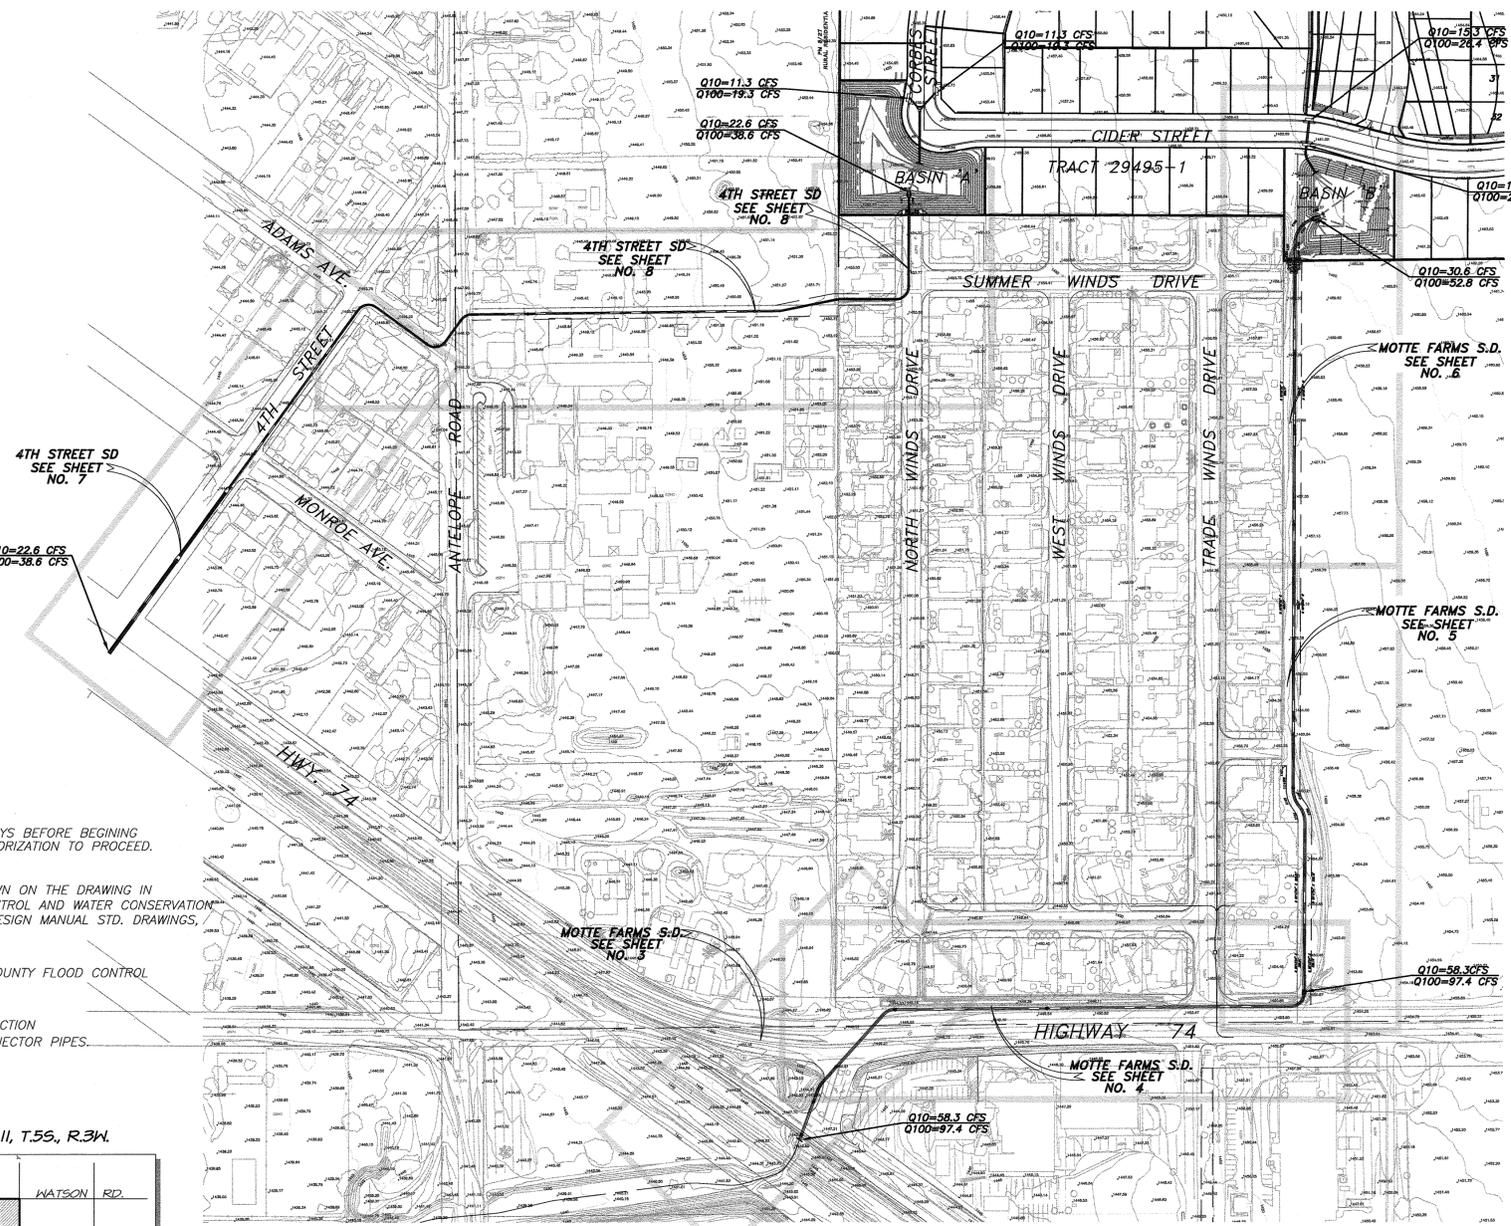

INDEX:

| | |
|----------------------|-------------|
| TITLE SHEET | SHEET NO. 1 |
| DETAIL SHEET | 2 |
| PLAN & PROFILE SHEET | 3-8 |

R.C.F.C. & W.C.D. STANDARD DRAWINGS

| | | |
|--------|----------------------------|---------------|
| MH 252 | MANHOLE NO. 2 | SHEET NO. 3-8 |
| TS 303 | TRANSITION STRUCTURE NO. 3 | 3-8 |

- CONSTRUCTION NOTES & QUANTITIES:**
QUANTITIES ARE FOR BONDING PURPOSES ONLY - CONTRACTOR TO BID PROJECT BASED ON HIS OWN TAKE-OFF"
- | | R.C.F.C. | R.C.T.D. |
|---|----------|----------|
| * ① INSTALL 19" x 30" OF LO-HED PIPE MANUFACTURED BY HYDRO CONDUIT PER DETAIL SHEET 7 OF 8 | | 400 LF |
| * ② INSTALL 24" R.C.P. - DLOAD PER PLAN | | 276 LF |
| * ③ INSTALL 36" R.C.P. - DLOAD PER PLAN | | 1,453 LF |
| * ④ CONSTRUCT MANHOLE PER DETAIL ON SHEET 7 | | 1 EA |
| * ⑤ CONSTRUCT TRANSITION STRUCTURE PER DETAIL ON SHEET 7 | | 1 EA |
| * ⑥ CONSTRUCT PIPE HEADWALL PER CAL TRANS STD. DWG. D89 | | 1 EA |
| * ⑦ INSTALL 48" R.C.P. - DLOAD PER PLAN | 2,320 LF | * 70 LF |
| * ⑧ CONSTRUCT MANHOLE NO. 2 PER R.C.F.C. & W.C.D. STD. DWG. NO. MH 252 | 3 EA | * 4 EA |
| * ⑨ CONSTRUCT MANHOLE NO. 2 PER R.C.F.C. & W.C.D. STD. DWG. NO. MH 252 AND DETAIL "A" | 3 EA | * 2 EA |
| * ⑩ CONSTRUCT 48" STAND PIPE WITH GRATE ASSEMBLY PER DETAIL ON SHEET 6 | 1 EA | |
| * ⑪ CONSTRUCT 48" STAND PIPE WITH GRATE ASSEMBLY PER DETAIL ON SHEET 8 | | * 1 EA |
| * ⑫ PLACE GROUTED NO.2 BACKING RIP RAP - 1 FOOT THICK FOR EMERGENCY OVERFLOW | 2 EA | |
| * ⑬ INSTALL MANHOLE FRAME AND COVER (PRESSURE TYPE) PER R.C.F.C. & W.C.D. ST. DWG. NO.256 (SEE DETAIL ON SHEET 2) | 3 EA | * 2 EA |
| * ⑭ INSTALL STANDARD PRESSURE MANHOLE SHAFT PER R.C.F.C. & W.C.D. ST. DWG. NO.258 (SEE DETAIL ON SHEET 2) | 3 EA | * 2 EA |
| * ⑮ PLACE NO.2 BACKING RIP RAP - 1 FOOT THICK PLACED OVER MIFAT 7000 FILTER FABRIC OR EQUIVALENT AND 8" OF CLASS 2 BASE | 1,039 SF | |
| * ⑯ CONSTRUCT 2'x4' RC BOX PER CAL TRANS STD. DWG. D80 (ALTERNATE OPTION FOR ⑬) | | * 344 LF |
| * ⑰ CONSTRUCT MH NO. 3 PER R.C.F.C. & W.C.D. STD. DWG. NO. MH253 (ALTERNATE FOR NO. ④) | | * 1 EA |
| * ⑱ CONSTRUCT JUNCTION STRUCTURE NO.2 PER R.C.F.C. & W.C.D. STD. DWG. NO. JS 227 | | * 1 EA |
| * ⑲A INSTALL BROOKS 36" x 36" CATCH BASIN 3636 CB MODIFY TO USE ALHAMBRA 36" x 36" COVER AND FRAME VANDAL PROOF IN 4 PLACES A2017 | | * 1 EA |
| * ⑲B INSTALL BROOKS 36" x 36" CATCH BASIN 3636 CB MODIFY TO USE ALHAMBRA 36" x 36" GRATE AND FRAME ADA COMPLIANT, GALVANIZED, VANDAL PROOF TWO PLACES (LOCK DOWN) | 1 EA | |
| * ⑲C INSTALL 18" RCP CLASS IV (2000 D)..... 49 LF | | * 10 LF |
| * ⑲D INSTALL TRASH RACK PER DETAIL ON SHEET 2 | | * 1 EA |
| * ⑲E CONSTRUCT P.C.C. DIP SECTION PER COUNTY OF RIVERSIDE STD. NO. 307 | | * 1 EA |

INDICATES POSSIBLE ALTERNATE OPTION. TO BE DETERMINED BY CONTRACTOR.
* INDICATES ITEMS TO BE MAINTAINED BY THE RIVERSIDE COUNTY TRANSPORTATION DEPT. WITHIN RCTD R/W
** INDICATES ITEMS TO BE MAINTAINED BY THE ROMOLAND SCHOOL DISTRICT

BENCHMARK
1.1 MILES SOUTHWEST OF LAKE SKINNER DAM FROM THE INTERSECTION OF BOREL ROAD AND BOOTLEG ROAD, 118 FEET NORTH OF THE CENTERLINE OF BOOTLEG ROAD, 21 FEET EAST OF THE CENTERLINE OF BOREL RD. 8 FEET SOUTH OF A TELEPHONE RISER, A 3-1/4 INCH STANDARD MWDC ALUMINUM DISK, SET FLUSH, IN TOP OF, AND IN THE CENTER OF A 3 FEET WIDE CATCH BASIN, 1 FEET EAST OF CURB FACE.

MWD DESIGNATION: SD 6 1
NAVD 88 ELEV. 1401.44



MONUMENT NOTE:
CONTRACTOR SHALL BE RESPONSIBLE FOR ANY MONUMENTATION AND/OR BENCHMARKS WHICH WILL BE DISTURBED OR DESTROYED BY CONSTRUCTION. SUCH POINTS SHALL BE REFERENCED AND REPLACED WITH APPROPRIATE MONUMENTATION BY A LICENSED LAND SURVEYOR OR A REGISTERED CIVIL ENGINEER AUTHORIZED TO PRACTICE LAND SURVEYING, A CORNER RECORD OF SURVEY, AS APPROPRIATE, SHALL BE FILLED BY THE LICENSED LAND SURVEYOR OR REGISTERED CIVIL ENGINEER AS REQUIRED BY THE LAND SURVEYOR'S ACT.

BASIS OF BEARING
THE CENTERLINE ANTELOPE ROAD AS SHOWN ON TRACT 4540, M.B. 74/62-63 RECORDS OF RIVERSIDE COUNTY, CALIFORNIA AND BEING N 00°21'19" W

AS BUILT
APPROVED BY: *[Signature]*
DATE: 7/5/06

INDEX OF SHEETS:

| SHEET NO.(S) | DESCRIPTION |
|--------------|------------------|
| SHEET # 1 | TITLE SHEET |
| SHEET # 2 | DETAIL SHEET |
| SHEET # 3-8 | PLAN AND PROFILE |

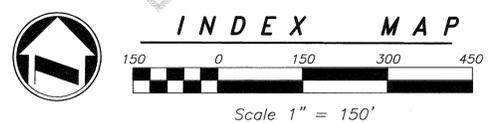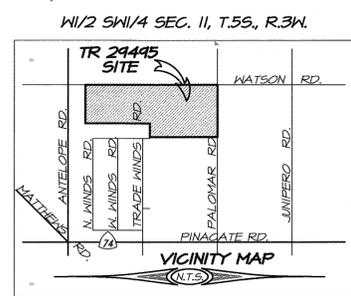

Underground Service Alert
Call: TOLL FREE 1-800-227-2600
TWO WORKING DAYS BEFORE YOU DIG

DIGALERT
Call: TOLL FREE 1-800-227-2600
TWO WORKING DAYS BEFORE YOU DIG

REGISTERED PROFESSIONAL ENGINEER
NO. 33950
EXP. 06-30-06
CIVIL
STATE OF CALIFORNIA

APPROVED BY: *[Signature]*
RECOMMENDED FOR APPROVAL BY: *[Signature]*
DATE: 12/15/03

PREPARED BY: **adkan ENGINEERS**
6820 AIRPORT DRIVE, RIVERSIDE, CA 92504
(909) 688-0241, FAX: (909) 688-0599

REGISTERED PROFESSIONAL ENGINEER
NO. 53390
EXP. 6-30-07
CIVIL
STATE OF CALIFORNIA

BENCH MARK: SEE SHEET 1



REVISIONS

| NO. | DESCRIPTION | DATE |
|----------|-------------|---------|
| AS BUILT | | 6/16/06 |

RIVERSIDE COUNTY FLOOD CONTROL AND WATER CONSERVATION DISTRICT
RECOMMENDED FOR APPROVAL BY: *[Signature]*
PLANNING ENGINEER
DATE: 12-24-2003

APPROVED BY: *[Signature]*
CHIEF ENGINEER
DATE: 12-24-03

PROJECT NO. 4-0-0314
DRAWING NO. 4-799
SHEET NO. 1 OF 8

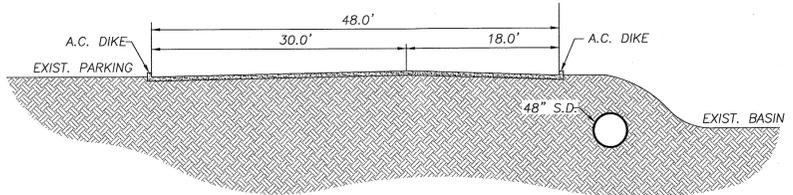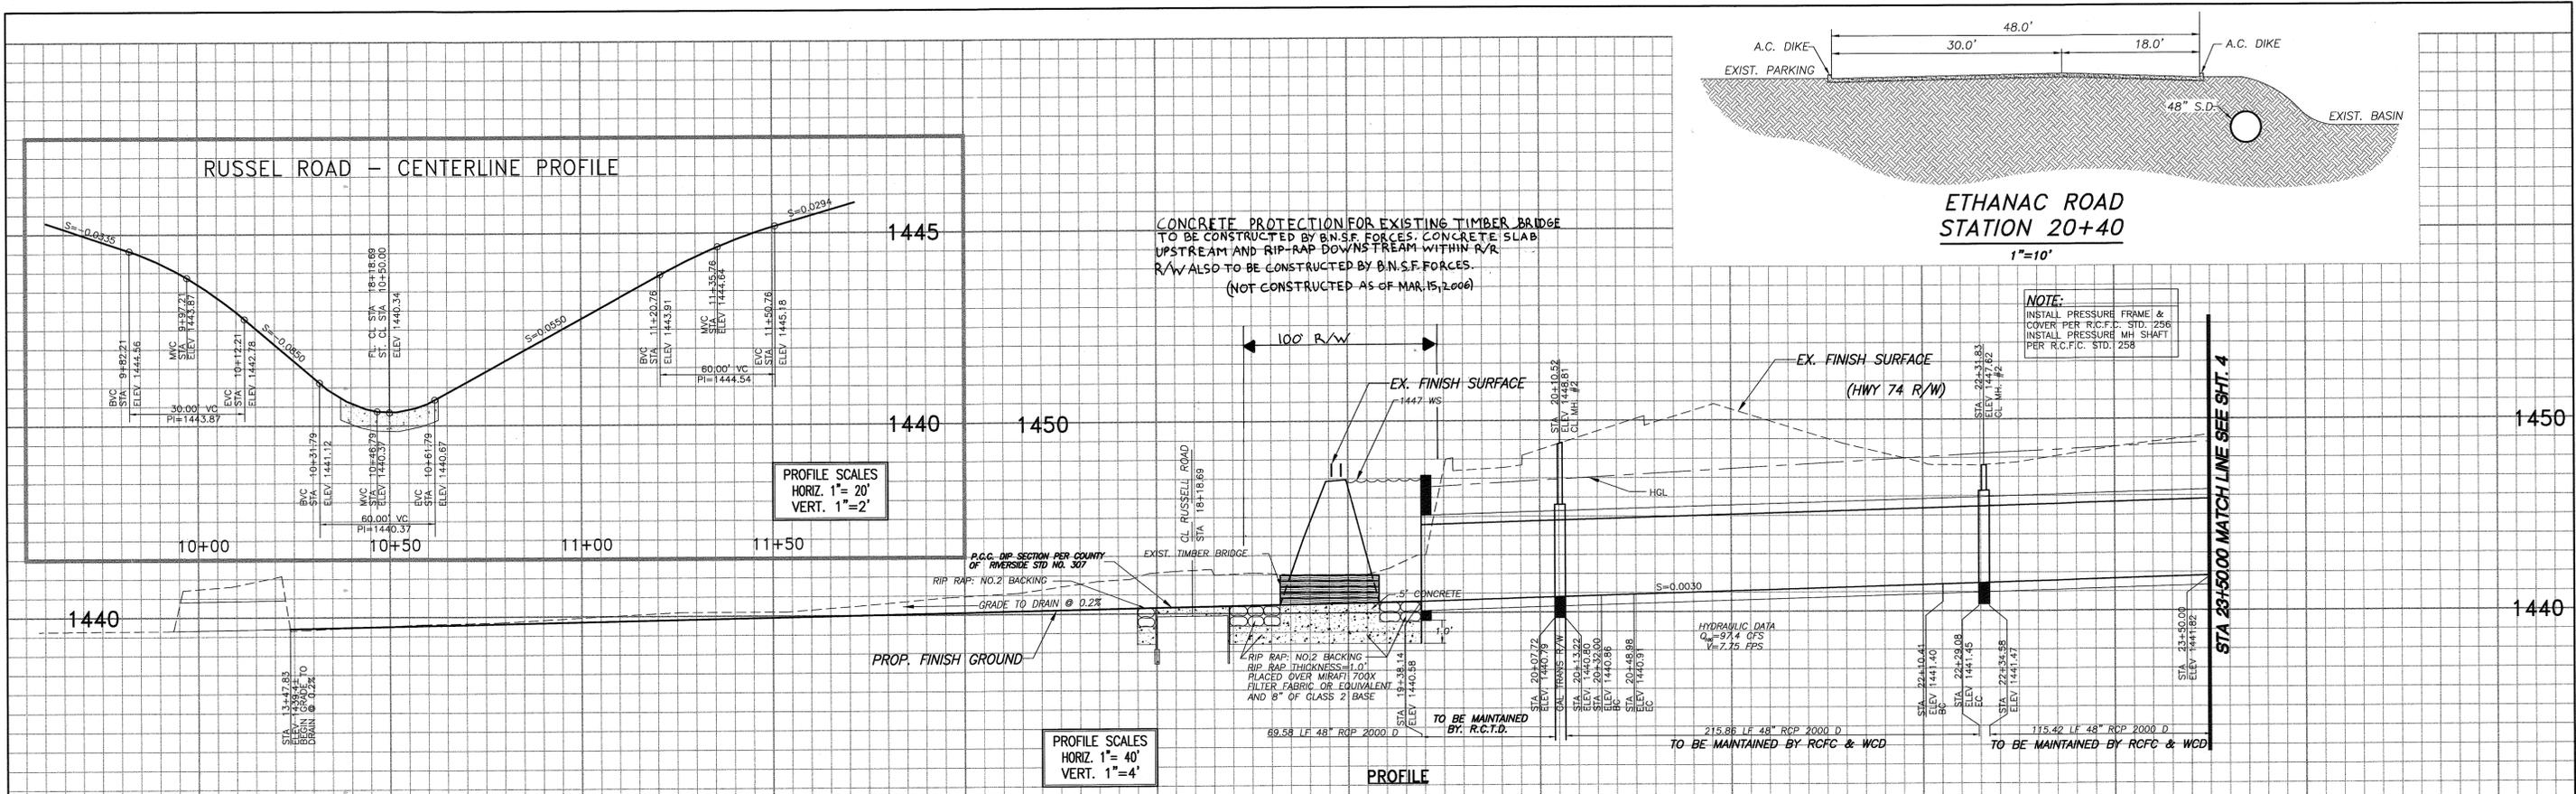



- ### CONSTRUCTION NOTES
- CONSTRUCT PIPE HEADWALL PER CAL TRANS STD. DWG. DB9
 - INSTALL 48" R.C.P. DLOAD PER PLAN
 - INSTALL 48" R.C.P. JACK PIPE STA. 20+48.99 TO STA. 22+10.42 NOT INSTALLED WITH JACK AND BORE. OPEN TRENCH INSTALLATION.
 - CONSTRUCT MANHOLE NO. 2 PER R.C.F.C. & W.C.D. STD. DWG. NO. MH 252
 - INSTALL MANHOLE FRAME AND COVER (PRESSURE TYPE) PER R.C.F.C. & W.C.D. STD. DWG. NO. 256
 - INSTALL STANDARD PRESSURE MANHOLE SHAFT PER R.C.F.C. & W.C.D. STD. DWG. NO. 258
 - PLACE NO.2 BACKING RIP RAP - 1 FOOT THICK PLACED OVER MIRAFI 700X FILTER FABRIC OR EQUIVALENT AND 8" OF CLASS 2 BASE
 - INSTALL TRASH RACK PER DETAIL ON SHEET 2
 - CONSTRUCT P.C.C. DIP SECTION PER COUNTY OF RIVERSIDE STD. NO. 307
 - PLACE NO.2 BACKING RIP-RAP - 6 INCH THICK PLACED OVER MIRAFI 700 X FILTER FABRIC OR EQUIVALENT AND 8" OF CLASS 2 BASE.

STORM DRAIN DATA TABLE

| NUMBER | DIRECTION | DISTANCE |
|--------|-------------|----------|
| L1 | N20°17'43"E | 93.86' |
| L2 | N41°54'57"E | 161.43' |
| L3 | N89°28'11"E | 702.99' |

| NUMBER | Δ | R _c ' | L _c ' | T _c ' |
|--------|-----------|------------------|------------------|------------------|
| C7 | 21°37'15" | 45.00 | 16.98 | 8.59 |
| C8 | 47°33'14" | 22.50 | 18.67 | 9.91 |



AS BUILT
 APPROVED BY: *[Signature]*
 DATE: 7/5/06

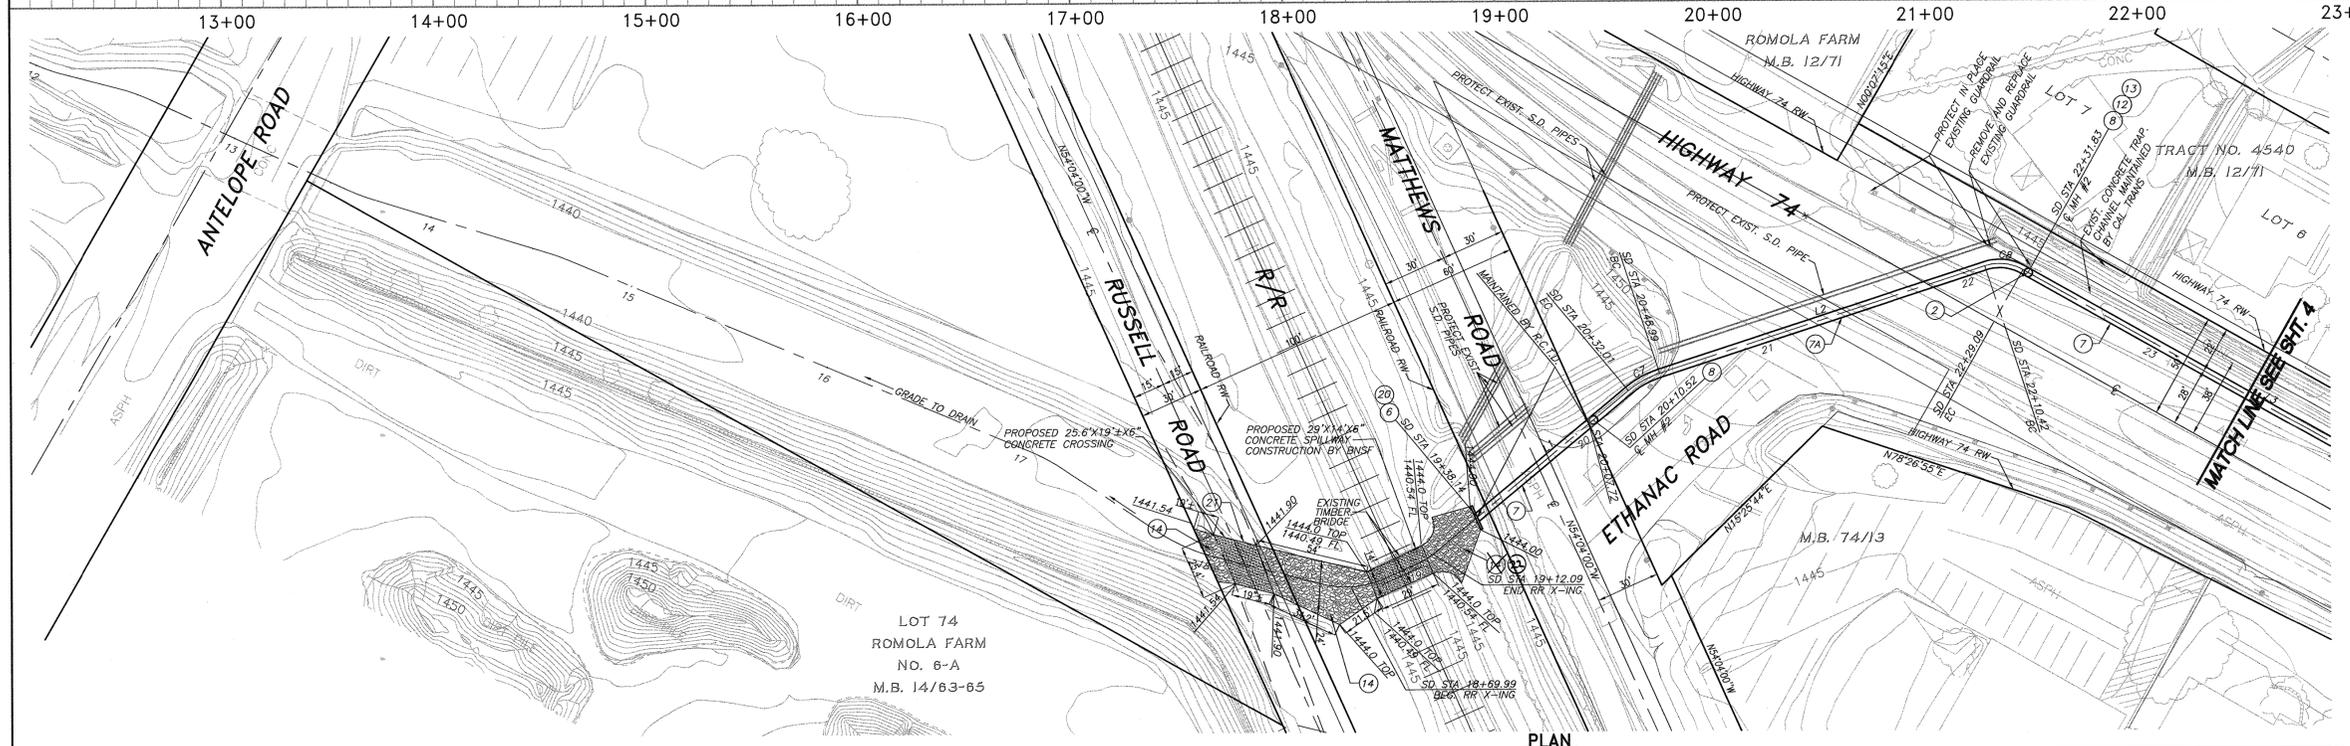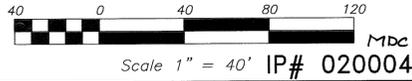

| Underground Service Alert DIGALERT Call: TOLL FREE 1-800-227-2600 TWO WORKING DAYS BEFORE YOU DIG | APPROVED BY: <i>[Signature]</i> HALED A. JTHMAN R.C.E. No. 33850 EXP. DATE: 6/30/08 FOR TRANSPORTATION DEPT. | RECOMMENDED FOR APPROVAL BY: <i>[Signature]</i> WILLDAN DATE: 11/15/08 | PREPARED BY: adkan ENGINEERS 5820 AIRPORT DRIVE, RIVERSIDE, CA 92504 TEL: (951) 686-0241 FAX: (951) 686-0599 DATE: 12-5-03 | ENGINEERS SEAL: CHARISSA J.A. LEACH, R.C.E. 53390 DATE: 12/24/03 | BENCH MARK: SEE SHEET 1 | REVISIONS <table border="1"> <tr> <th>NO.</th> <th>DESCRIPTION</th> <th>DATE</th> </tr> <tr> <td>1</td> <td>AS BUILT</td> <td>12/24/03</td> </tr> </table> | NO. | DESCRIPTION | DATE | 1 | AS BUILT | 12/24/03 | DESIGNED BY: <i>[Signature]</i> DRAWN BY: <i>[Signature]</i> DATE DRAWN: 12/23/03 | RECOMMENDED FOR APPROVAL BY: <i>[Signature]</i> DATE: 12/23/03 | APPROVED BY: <i>[Signature]</i> DATE: 12-24-2003 | PROJECT NO. 4-0-0314 DRAWING NO. 4-799 SHEET NO. 3 OF 8 |
|---|---|--|---|---|----------------------------|---|-------------|-------------|------|---|----------|----------|--|--|--|---|
| | | | | | | NO. | DESCRIPTION | DATE | | | | | | | | |
| 1 | AS BUILT | 12/24/03 | | | | | | | | | | | | | | |
| RIVERSIDE COUNTY FLOOD CONTROL AND WATER CONSERVATION DISTRICT ROMOLAND-MOTTE FARMS STORM DRAIN PLAN & PROFILE TRACT 29495-1 | | | | | | | | | | | | | | | | |

CONSTRUCTION NOTES



- ⑦ INSTALL 48" R.C.P. - DLOAD PER PLAN
- ⑧ CONSTRUCT MANHOLE NO. 2 PER R.C.F.C.&W.C.D. STD. DWG. NO. MH 252
- ⑨A CONSTRUCT MANHOLE NO. 2 PER R.C.F.C.&W.C.D. STD. DWG. NO. MH 252 AND DETAIL "A", THIS SHEET.
- ⑫ INSTALL MANHOLE FRAME AND COVER (PRESSURE TYPE) PER R.C.F.C.&W.C.D. ST. DWG. NO.256 (SEE DETAIL ON SHT. 2)
- ⑬ INSTALL STANDARD PRESSURE MANHOLE SHAFT PER R.C.F.C.&W.C.D. ST. DWG. NO.258 (SEE DETAIL ON SHT. 2)

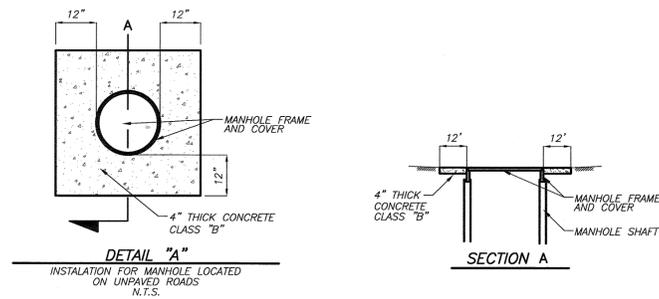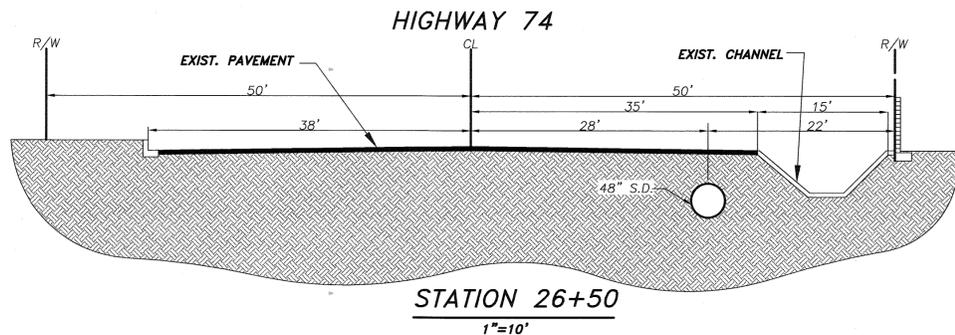

STORM DRAIN DATA TABLE

| NUMBER | DIRECTION | DISTANCE |
|--------|-------------|----------|
| L3 | N89°28'11"E | 702.99' |
| L4 | N00°13'04"E | 302.14' |

| NUMBER | Δ= | R= | L= | T= |
|--------|-----------|-------|-------|-------|
| C9 | 89°15'07" | 22.50 | 35.05 | 22.21 |

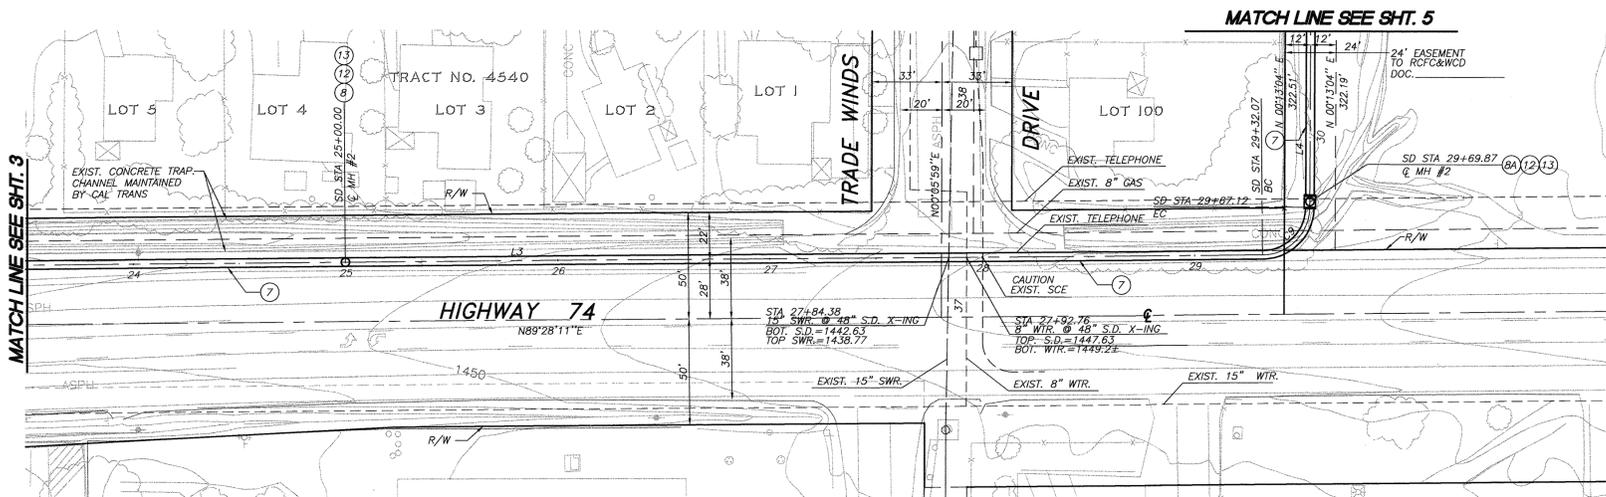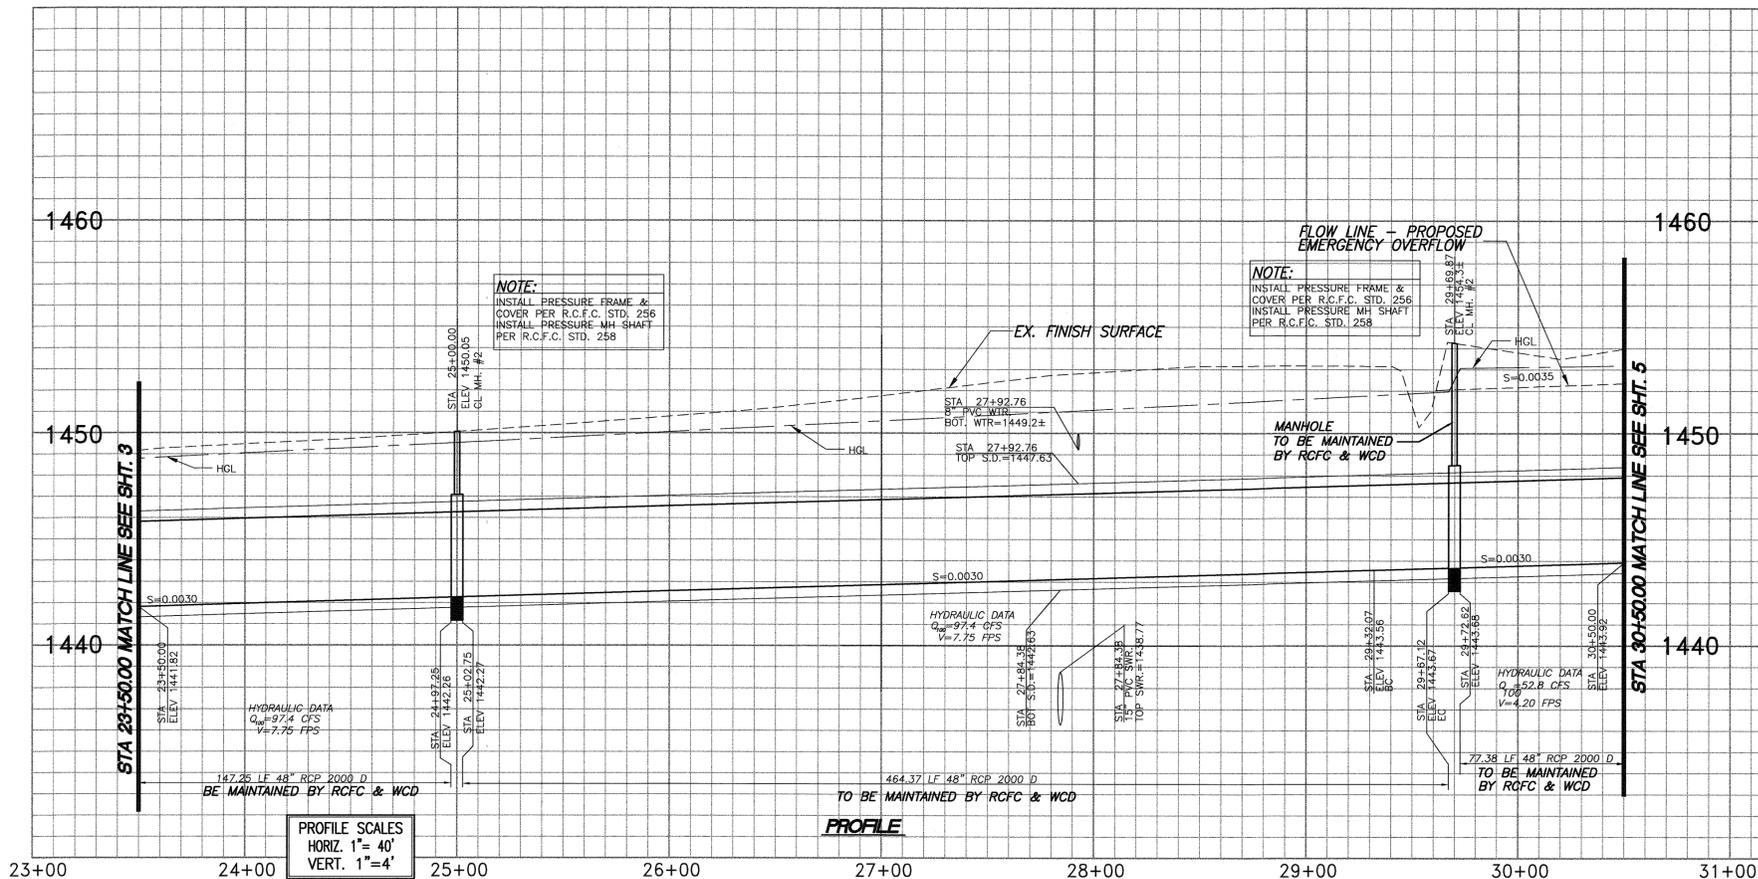

AS BUILT
APPROVED BY: *[Signature]*
DATE: 7/5/06

Underground Service Alert
DIGALERT
Call: TOLL FREE
1-800-227-2600
TWO WORKING DAYS BEFORE YOU DIG

REGISTERED PROFESSIONAL ENGINEER
KHALID A. OTHMAN
NO. 33950
EXP. 06-30-06
CIVIL
STATE OF CALIFORNIA

APPROVED BY: *[Signature]*
KHALID A. OTHMAN
R.C.E. No. 33950 EXP. DATE: 6/30/06
FOR TRANSPORTATION DEPT.

RECOMMENDED FOR APPROVAL BY: *[Signature]*
DATE: 12/15/03
PREPARED BY: *[Signature]*
DATE: 12-5-03



adkan ENGINEERS
6820 AIRPORT DRIVE, RIVERSIDE, CA 92504
TEL: (909) 688-0241 • FAX: (909) 688-0599
CHARISSA J.A. LEACH, R.C.E. 53390

REGISTERED PROFESSIONAL ENGINEER
CHARISSA J.A. LEACH
NO. 53390
EXP. 6-30-07
CIVIL
STATE OF CALIFORNIA


| REVISIONS | DATE | BY |
|-----------|----------|-------------|
| AS BUILT | 12/16/06 | [Signature] |

RIVERSIDE COUNTY FLOOD CONTROL AND WATER CONSERVATION DISTRICT
RECOMMENDED FOR APPROVAL BY: *[Signature]*
APPROVED BY: *[Signature]*
DATE: 12/23/03 DATE: 12-24-2003



ROMOLAND-MOTTE FARMS STORM DRAIN
PLAN & PROFILE
TRACT 29495-1
PROJECT NO. 4-0-0314
DRAWING NO. 4-799
SHEET NO. 4 OF 8

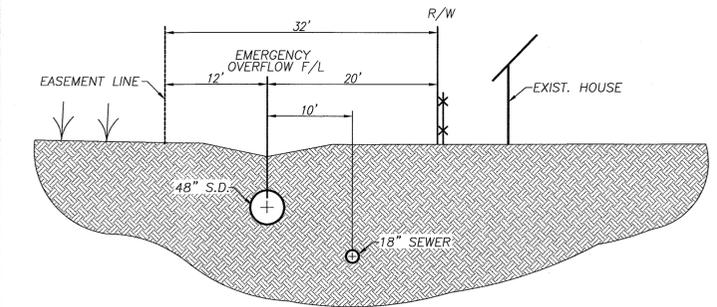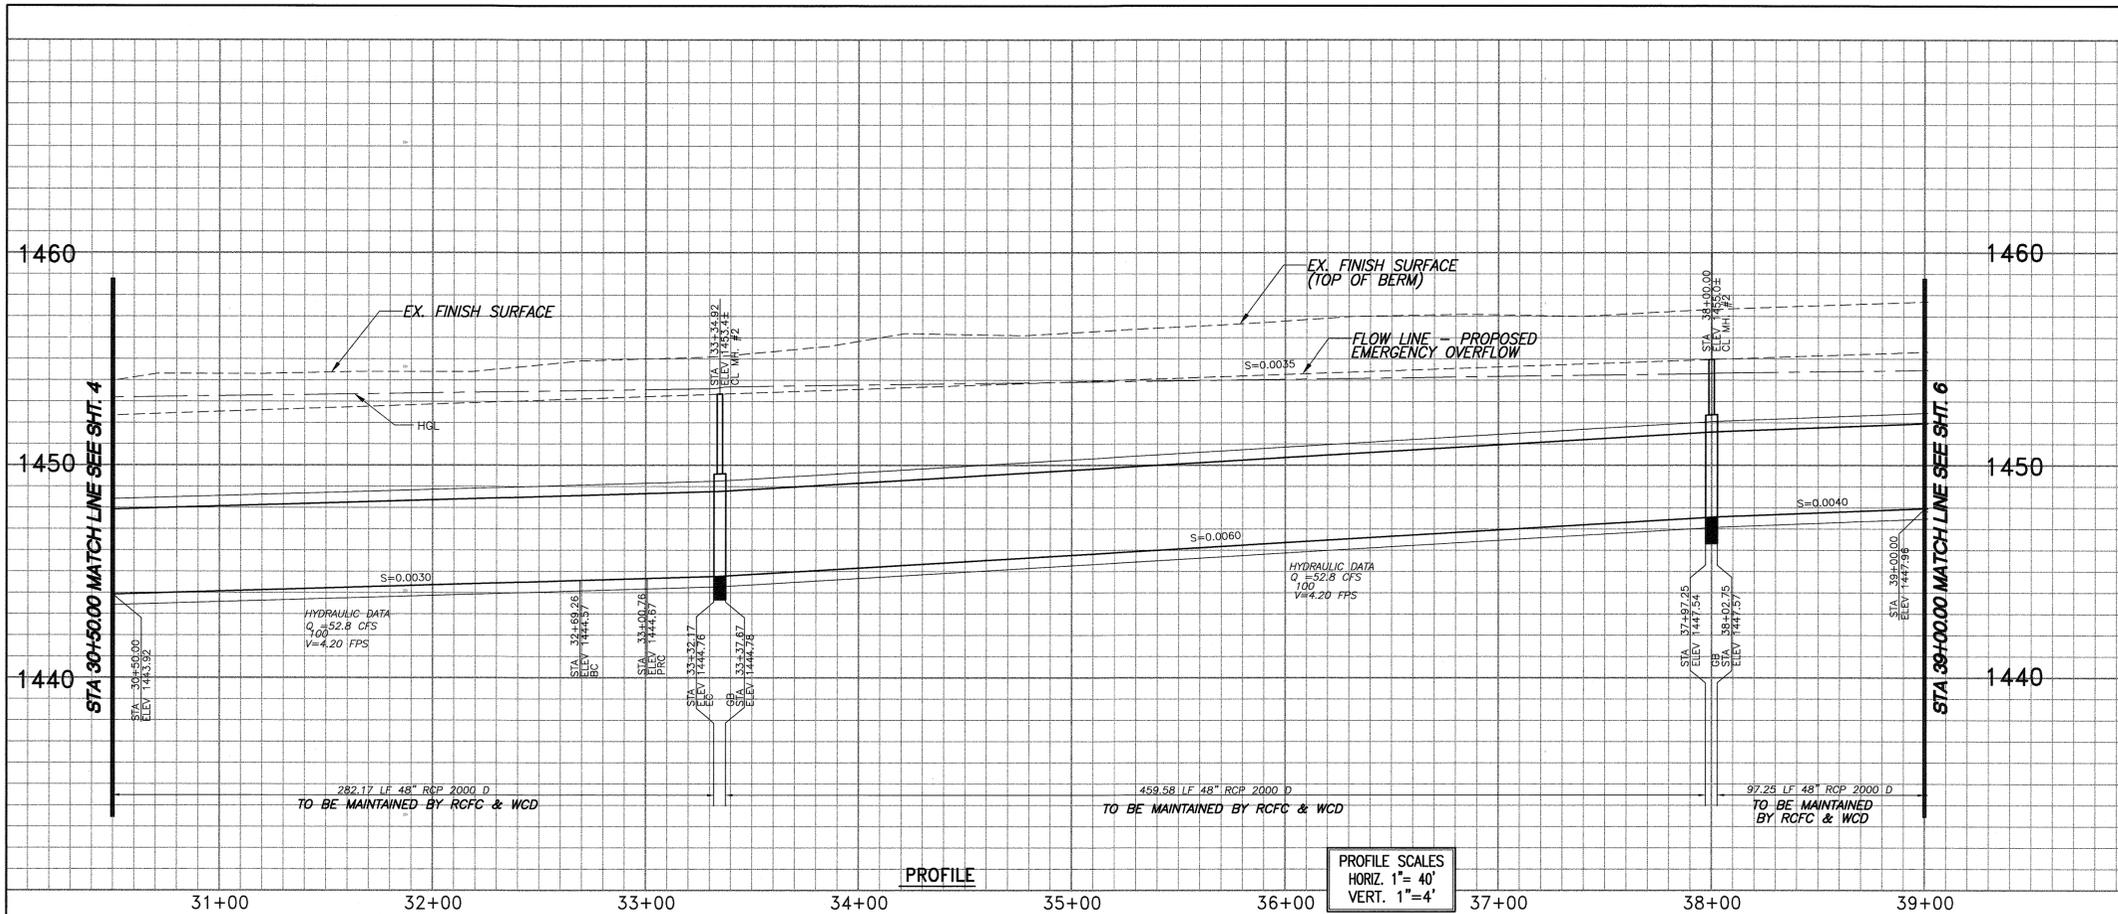

STATION 36+00
1"=10'

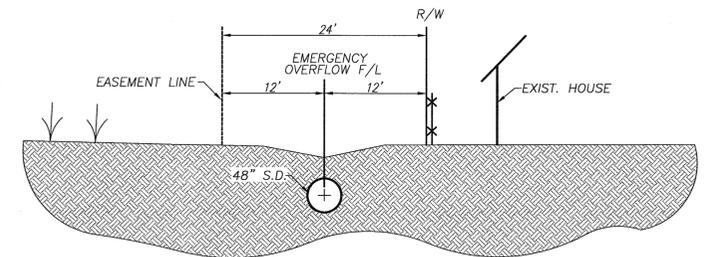

STATION 31+00
1"=10'

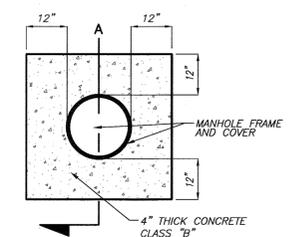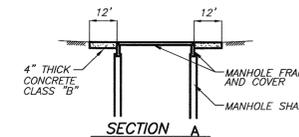

CONSTRUCTION NOTES


- 7 INSTALL 48" R.C.P. - DLOAD PER PLAN
- 8A CONSTRUCT MANHOLE NO. 2 PER R.C.F.C.&W.C.D. STD. DWG. NO. MH 252 AND DETAIL "A", THIS SHEET.

STORM DRAIN DATA TABLE

| NUMBER | DIRECTION | DISTANCE |
|--------|-------------|----------|
| L4 | N00°13'04"E | 302.14' |
| L23 | N00°05'59"E | 565.08' |
| L107 | N89°54'01"W | 8.00' |
| L108 | N00°05'59"E | 42.09' |

| NUMBER | A= | R= | L= | T= |
|--------|-----------|-------|-------|-------|
| C10 | 40'06"45" | 45.00 | 31.50 | 16.43 |
| C11 | 39'59"39" | 45.00 | 31.41 | 16.38 |
| C102 | 40'06"45" | 33.00 | 23.10 | 12.05 |
| C103 | 39'59"39" | 57.00 | 39.79 | 20.74 |
| C104 | 40'06"45" | 57.00 | 39.91 | 20.81 |
| C105 | 39'59"39" | 33.00 | 23.03 | 12.01 |

AS BUILT
APPROVED BY: *[Signature]*
DATE: 7/5/06

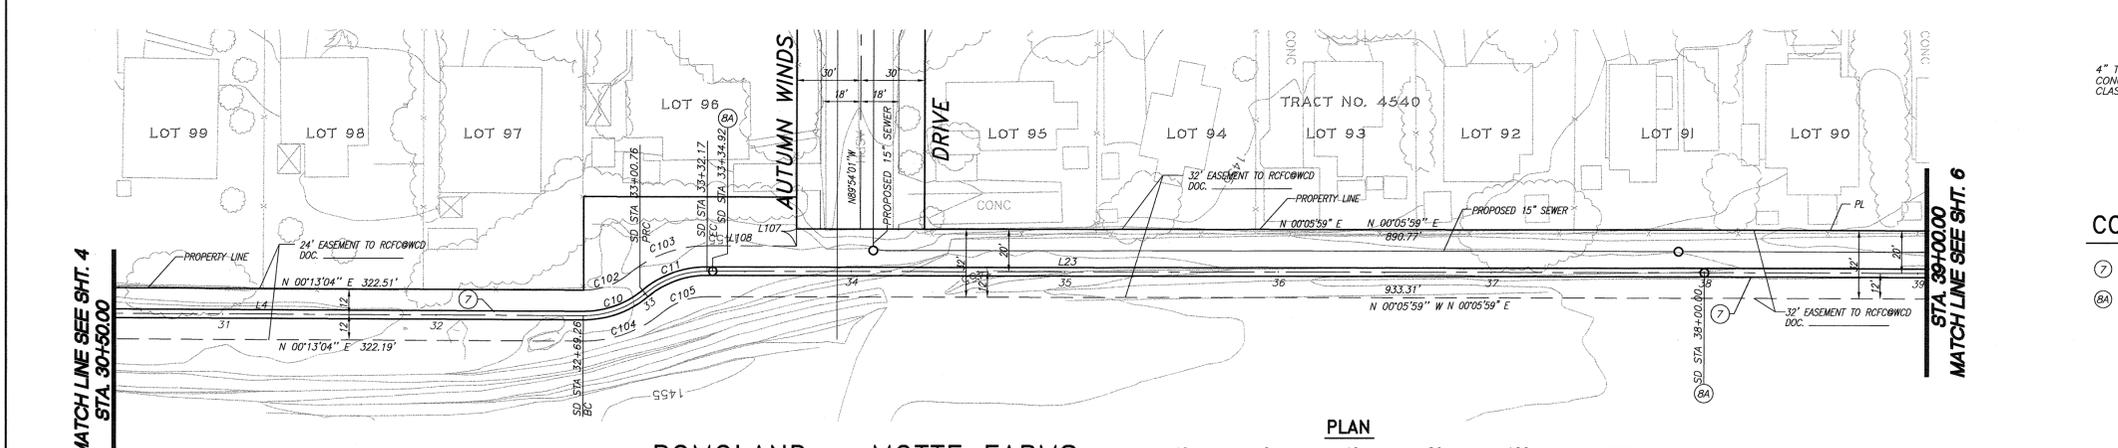

ROMOLAND - MOTTE FARMS
STORM DRAIN



Underground Service Alert
DIGALERT
Call: TOLL FREE
1-800-227-2600
TWO WORKING DAYS BEFORE YOU DIG

REGISTERED PROFESSIONAL ENGINEER
STATE OF CALIFORNIA
NO. 33950
EXP. 06-30-06
CIVIL

APPROVED BY:
[Signature]
DATE: 12/23/03
R.C.E. No. 33950 EXP. DATE: 6/30/06
FOR TRANSPORTATION DEPT.

RECOMMENDED FOR APPROVAL BY:
[Signature]
DATE: 12/15/03

PREPARED BY:
adkan ENGINEERS
6820 AIRPORT DRIVE, RIVERSIDE, CA 92504
TEL: (909) 888-0241, FAX: (909) 888-0599
CHARISSA J.A. LEACH, R.C.E. 53390 DATE: 12-5-03

ENGINEER'S SEAL
REGISTERED PROFESSIONAL ENGINEER
STATE OF CALIFORNIA
NO. 53390
EXP. 6-30-07
CIVIL

BENCH MARK:
SEE SHEET 1


| REVISIONS | DATE | BY |
|-----------|----------|-------------|
| AS BUILT | 12/23/03 | [Signature] |

DESIGNED BY:
DRAWN BY:
DATE DRAWN:
CHECKED BY:







RECOMMENDED FOR APPROVAL BY:
[Signature]
DATE: 12/23/03

APPROVED BY:
[Signature]
DATE: 12-24-2003



MDC
PROJECT NO. 4-0-0314
DRAWING NO. 4-799
SHEET NO. 5 OF 8

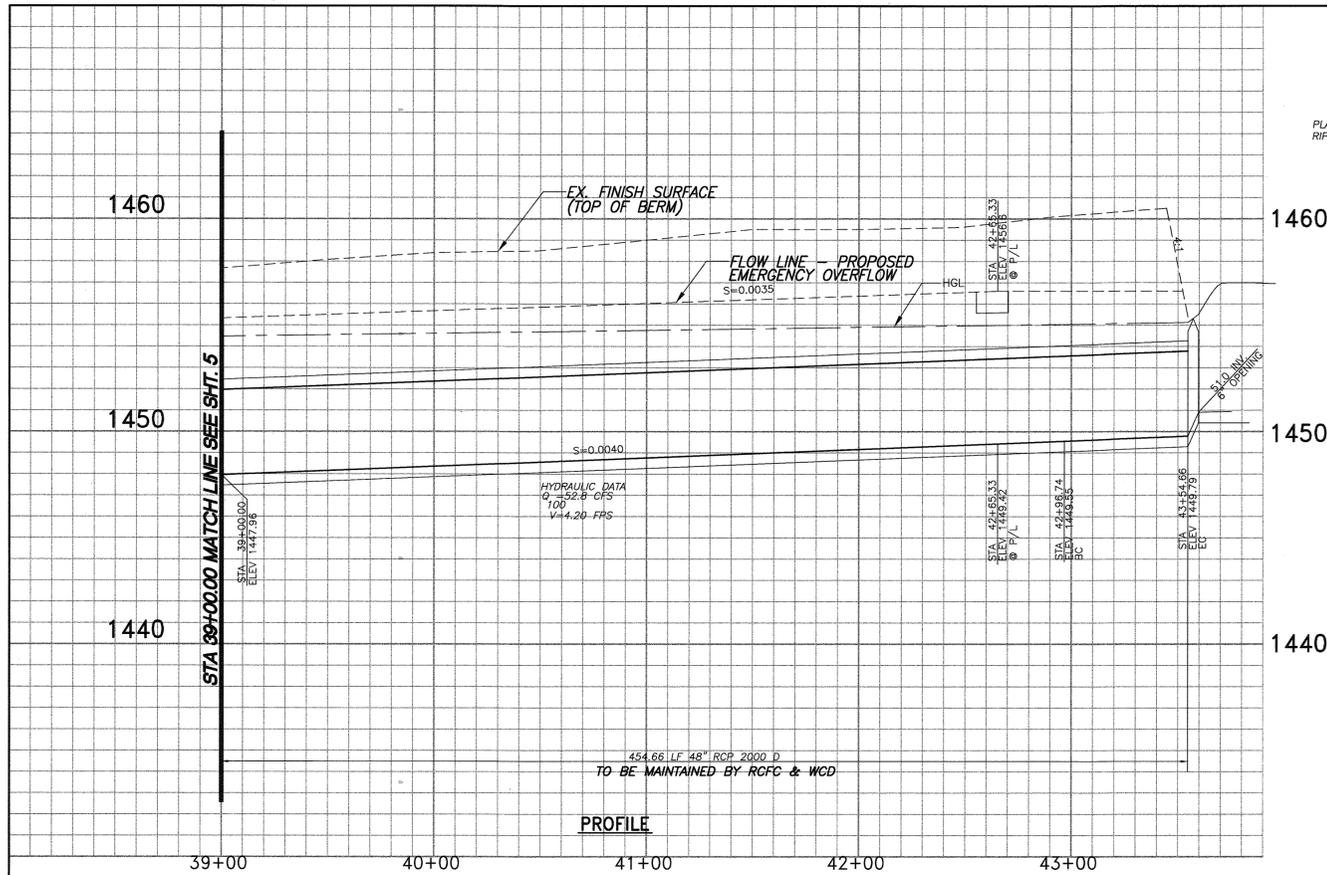

PROFILE SCALES
 HORIZ. 1" = 40'
 VERT. 1" = 4'

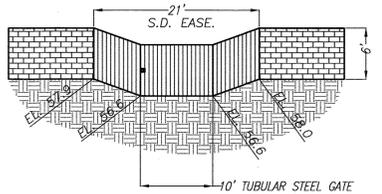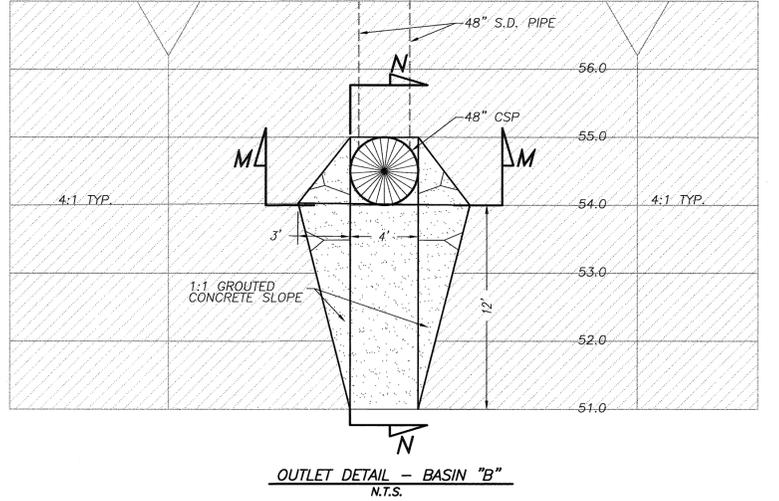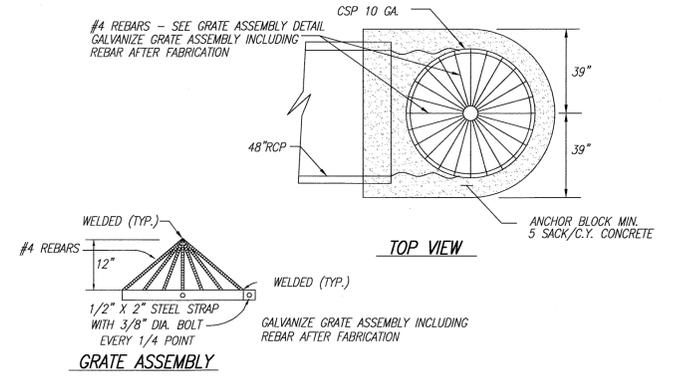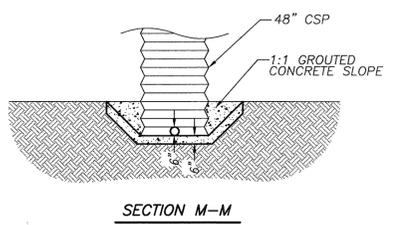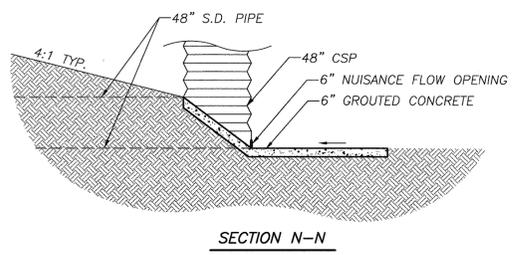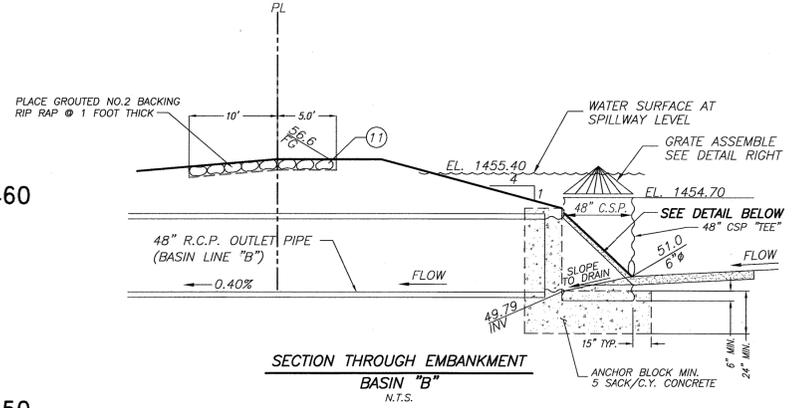

SECTION J-J AS BUILT
 1" = 10'
 APPROVED BY: *[Signature]*
 DATE: 7/5/06

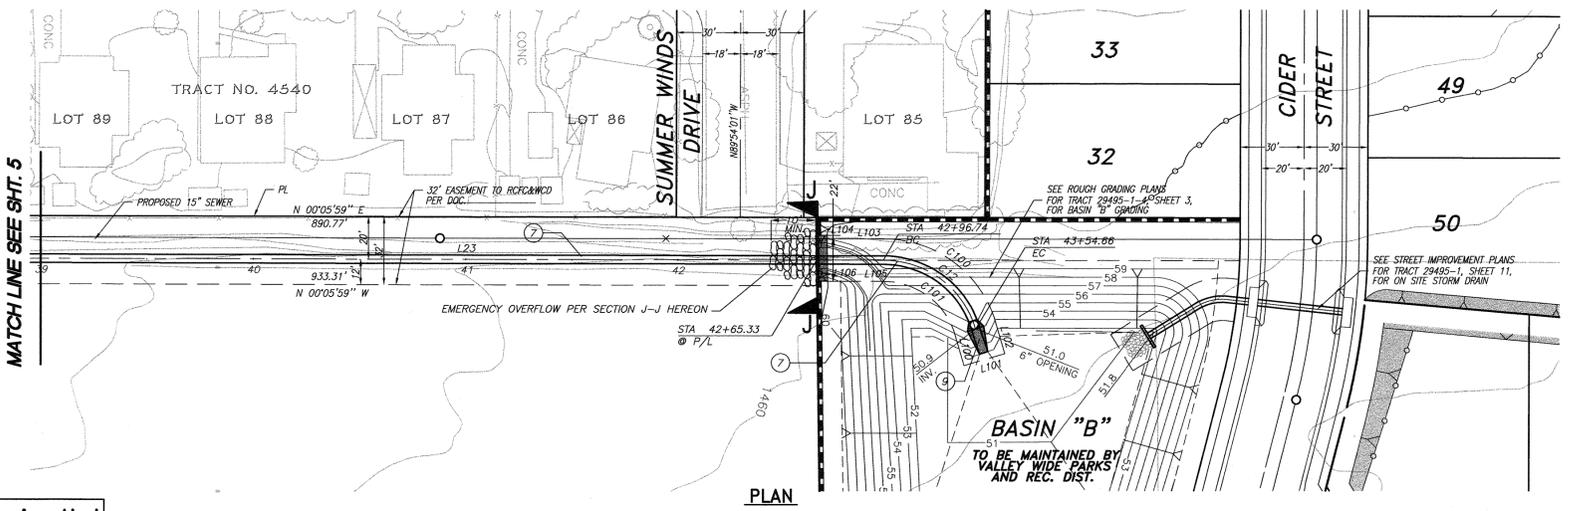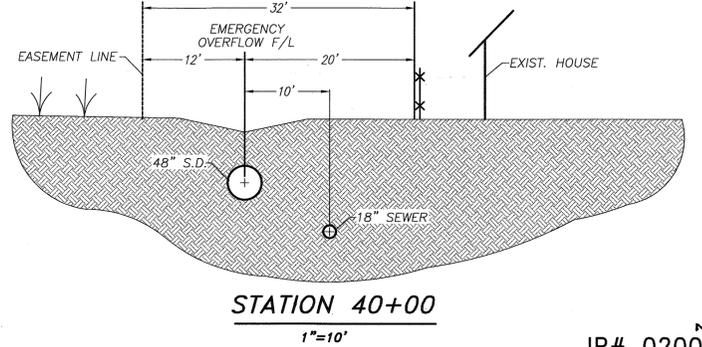


STORM DRAIN DATA TABLE

| NUMBER | DIRECTION | DISTANCE |
|--------|-------------|----------|
| L23 | N00°05'59"E | 565.08' |
| L100 | N73°50'26"E | 15.00' |
| L101 | N16°09'34"W | 20.00' |
| L102 | N73°50'26"E | 15.00' |
| L103 | N00°05'59"E | 31.40' |
| L104 | N88°29'57"E | 10.00' |
| L105 | N00°05'59"E | 31.40' |
| L106 | N85°18'29"E | 2.00' |

| NUMBER | d= | R= | L= | T= |
|--------|-----------|--------|--------|--------|
| C12 | 73°44'27" | 45.00' | 57.92' | 33.75' |
| C100 | 73°44'27" | 55.00' | 70.79' | 41.25' |
| C101 | 73°44'27" | 35.00' | 45.05' | 26.25' |

ROMOLAND - MOTTE FARMS STORM DRAIN

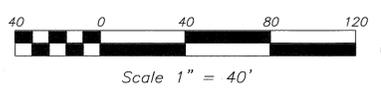

CONSTRUCTION NOTES

- ⑦ INSTALL 48" R.C.P. - LOAD PER PLAN
- ⑨ CONSTRUCT 48" STAND PIPE RISER WITH GRATE ASSEMBLY PER DETAIL ABOVE
- ⑪ PLACE GROUDED NO.2 BACKING RIP RAP - 1 FOOT THICK FOR EMERGENCY OVERFLOW

Underground Service Alert
 DIGALERT
 Call: TOLL FREE
 1-800
 227-2600
 TWO WORKING DAYS BEFORE YOU DIG

Underground Service Alert
 DIGALERT
 Call: TOLL FREE
 1-800
 227-2600
 TWO WORKING DAYS BEFORE YOU DIG

REGISTERED PROFESSIONAL ENGINEER
 MAILED A OTHMAN
 NO. 33950
 EXP. 06-30-06
 CIVIL
 STATE OF CALIFORNIA

APPROVED BY:
[Signature]
 MAILED A OTHMAN
 DATE: 12/16/03
 R.C.E. No. 33950 EXP. DATE: 6/30/08
 FOR TRANSPORTATION DEPT.

RECOMMENDED FOR APPROVAL BY:
[Signature]
 WILLIDAN
 DATE: 12/15/03

PREPARED BY:
adkan ENGINEERS
 6820 AIRPORT DRIVE, RIVERSIDE, CA 92504
 TEL: (951) 696-0241, FAX: (909) 688-0599
 CHARISSA J.A. LEACH, R.C.E. 53390
 DATE: 12-5-03

ENGINEER'S SEAL
 REGISTERED PROFESSIONAL ENGINEER
 CHARISSA J.A. LEACH
 NO. 53390
 EXP. 6-30-07
 CIVIL
 STATE OF CALIFORNIA

BENCH MARK:
 SEE SHEET 1


| REVISIONS | DATE | BY |
|-----------|---------|----|
| AS BUILT | 6/16/06 | |

RIVERSIDE COUNTY FLOOD CONTROL
 AND
 WATER CONSERVATION DISTRICT
 RECOMMENDED FOR APPROVAL BY:
[Signature]
 DATE: 12/23/03




APPROVED BY:
[Signature]
 DATE: 12-24-2003

ROMOLAND-MOTTE FARMS
 STORM DRAIN
 PLAN & PROFILE
 TRACT 29495-1

PROJECT NO. 4-0-0314
 DRAWING NO. 4-799
 SHEET NO. 6 OF 8
 IP# 020004

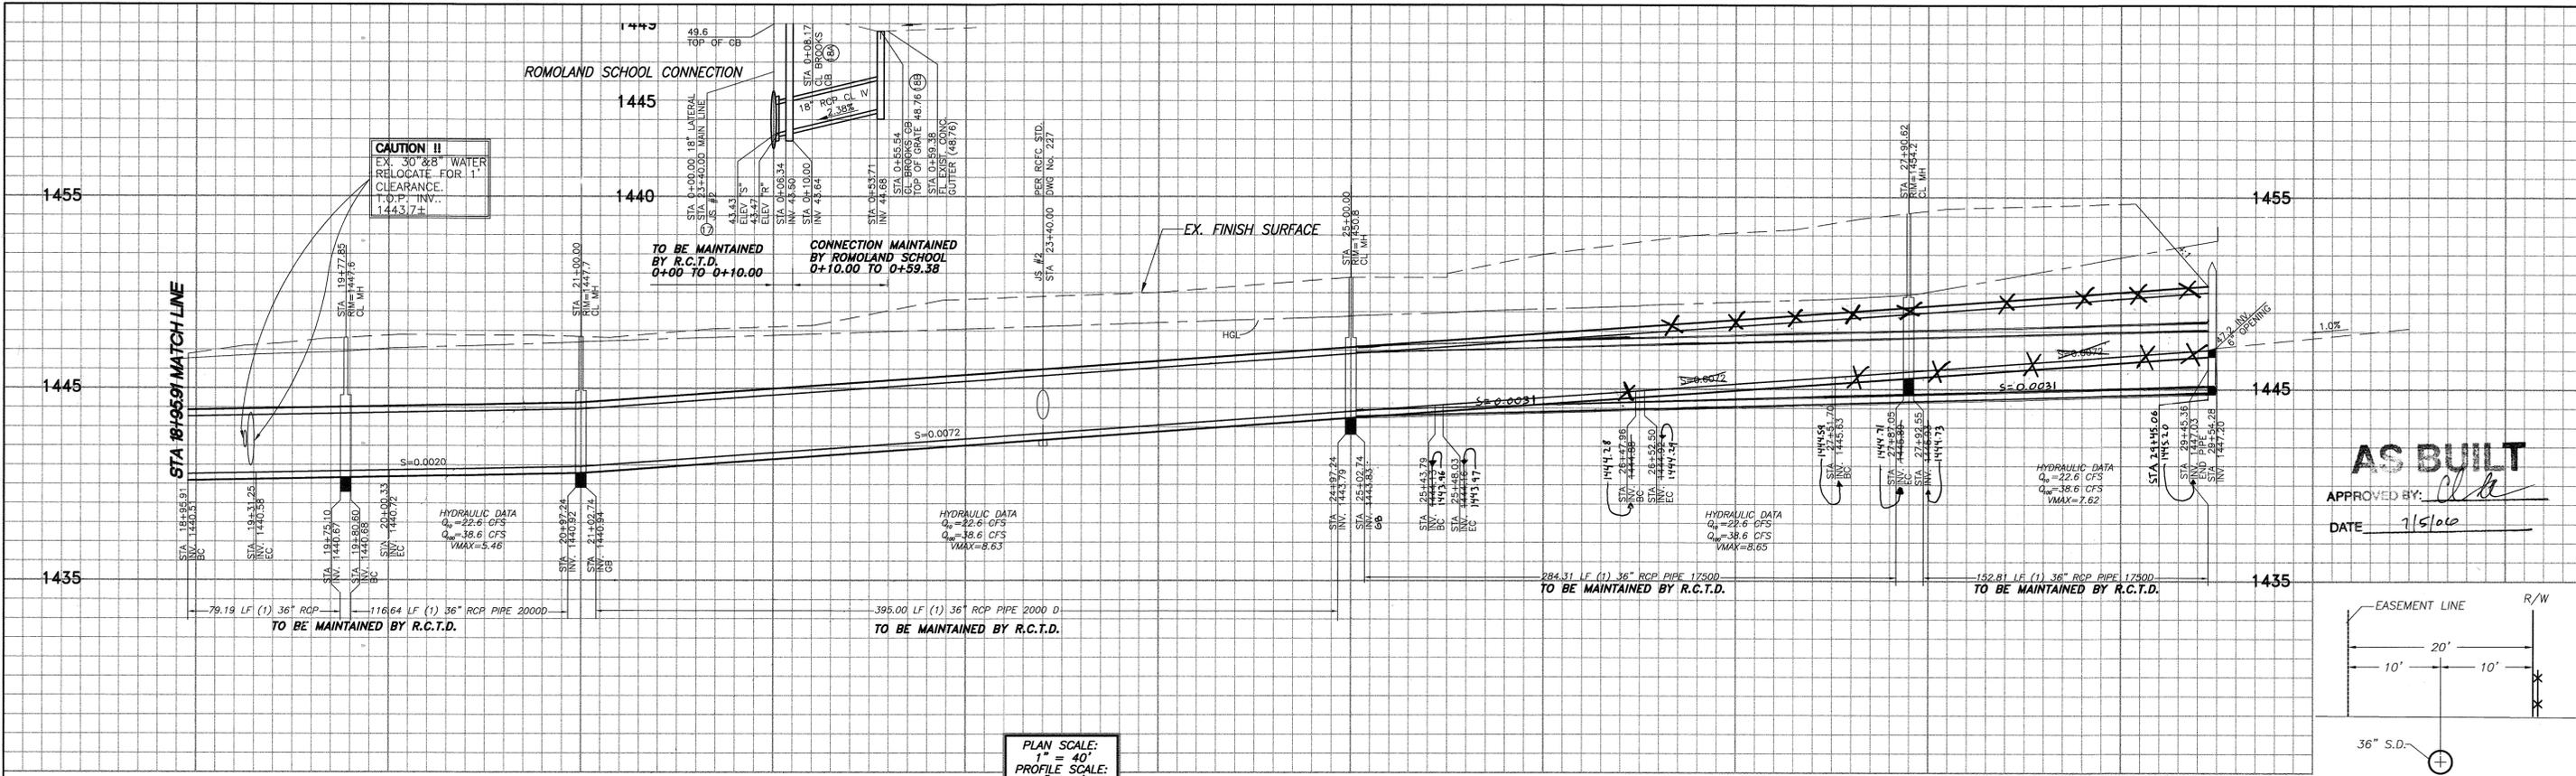

AS BUILT
 APPROVED BY: *[Signature]*
 DATE: 7/5/02

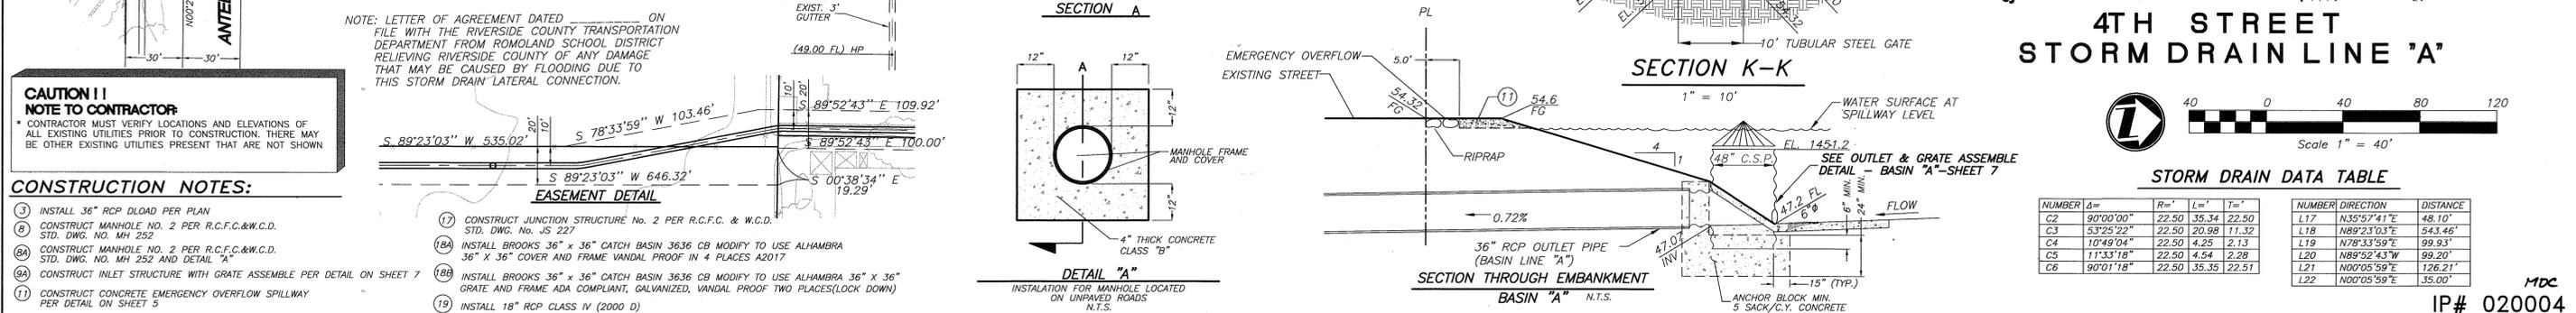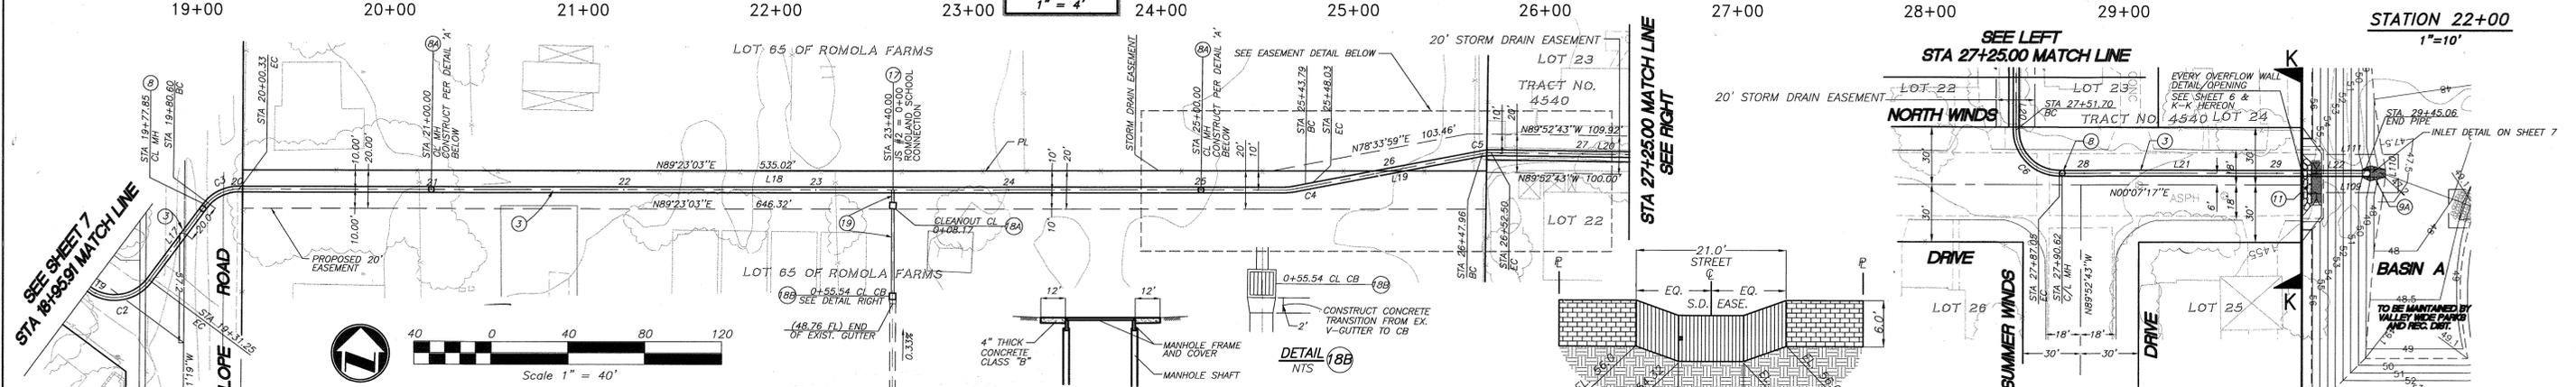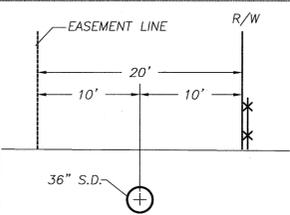

STORM DRAIN DATA TABLE

| NUMBER | Δ= | R= | L= | T= | NUMBER | DIRECTION | DISTANCE |
|--------|-----------|-------|-------|-------|--------|-------------|----------|
| C2 | 90°00'00" | 22.50 | 35.34 | 22.50 | L17 | N35°57'41"E | 48.10' |
| C3 | 53°25'22" | 22.50 | 20.98 | 11.32 | L18 | N89°23'03"E | 543.46' |
| C4 | 10°49'04" | 22.50 | 4.25 | 2.13 | L19 | N78°33'59"E | 99.93' |
| C5 | 11°33'18" | 22.50 | 4.54 | 2.28 | L20 | N89°52'43"W | 99.20' |
| C6 | 90°01'18" | 22.50 | 35.35 | 22.51 | L21 | N00°05'59"E | 126.21' |
| | | | | | L22 | N00°05'59"E | 35.00' |

Underground Service Alert
DIGALERT
 Call: TOLL FREE
1-800-227-2600
 TWO WORKING DAYS BEFORE YOU DIG

APPROVED BY: *[Signature]*
 KHALED A. OTHMAN
 R.C.E. No. 33950 EXP. DATE: 8/30/08
 FOR TRANSPORTATION DEPT.

RECOMMENDED FOR APPROVAL BY: *[Signature]*
 WILLIDAN
 DATE: 12/15/03

PREPARED BY: **adkan ENGINEERS**
 6820 AIRPORT DRIVE, RIVERSIDE, CA 92504
 TEL: (909) 949-0241, FAX: (909) 688-0599
 CHARISSA J.A. LEACH, R.C.E. 53390
 DATE: 12-5-03

ENGINEERS SEAL
 REGISTERED PROFESSIONAL ENGINEER
 CHARISSA J.A. LEACH
 NO. 53390
 EXP. 6-30-07
 CIVIL
 STATE OF CALIFORNIA

REVISIONS
 AS BUILT
 6/16/04

RIVERSIDE COUNTY FLOOD CONTROL AND WATER CONSERVATION DISTRICT
 ROMOLAND-MOTTE FARMS STORM DRAIN
 PLAN & PROFILE
 TRACT 29495-1
 PROJECT NO. 4-0-0314
 DRAWING NO. 4-799
 SHEET NO. 8 OF 8

RIVERSIDE COUNTY FLOOD CONTROL AND WATER CONSERVATION DISTRICT

SCRRRA AND RCTC NOTES:


1. CONTRACTOR SHALL CONTACT THE SOUTHERN CALIFORNIA REGIONAL RAIL AUTHORITY (SCRRRA), CHRISTOS SOURMELIS 909-394-3418, AT LEAST 5 WORKING DAYS (MONDAY THROUGH FRIDAY) BEFORE STARTING CONSTRUCTION.
2. CONTRACTOR SHALL CONTACT THE RIVERSIDE COUNTY TRANSPORTATION COMMISSION, RUBY ARELLANO 951-787-7141, AT LEAST 5 WORKING DAYS (MONDAY THROUGH FRIDAY) BEFORE STARTING CONSTRUCTION.
3. RAIL TRACK ELEVATIONS OVER THE RCB SHALL BE PROFILED TO DETECT ANY CHANGE IN ELEVATION. BEFORE AND AFTER PROFILES SHALL BE PERFORMED BY A LICENSED SURVEYOR.
4. A LETTER REPORT FROM THE SURVEYOR SHALL BE SUBMITTED TO SCRRRA AND RCTC STATING MONITORING RESULTS, WITHIN SEVEN (7) DAYS OF THE COMPLETION WORK WITHIN THE RCTC R/W. THE REPORT SHALL BE SENT TO CHRISTOS SOURMELIS OF SCRRRA AT 279 E. ARROW HIGHWAY, SUITE 101, SAN DIMAS, CA 91773 AND RUBY ARELLANO OF RCTC AT POST OFFICE BOX 12008, RIVERSIDE, CALIFORNIA 92502-2208.
5. THE CONTRACTOR SHALL NOTIFY SCRRRA, RCTC AND RCFCO WITHIN FORTY FIVE (45) DAYS OF THE DATE AND LOCATION FOR FABRICATION OF RCB ELEMENTS. INSPECTIONS OF THESE ELEMENTS WILL BE MADE BY RCFCO PERSONNEL DURING FABRICATION. THE CONTRACTOR WILL BE REQUIRED TO PRESENT A COPY OF THE RCFCO INSPECTION CERTIFICATION TO THE SCRRRA AND RCTC REPRESENTATIVES AT THE CONSTRUCTION COORDINATION MEETING.
6. BEFORE EXCAVATING, THE CONTRACTOR MUST DETERMINE WHETHER ANY UNDERGROUND PIPE LINES, ELECTRIC WIRES, OR CABLES, INCLUDING FIBER OPTIC CABLE SYSTEMS, ARE PRESENT AND LOCATED WITHIN THE PROJECT WORK AREA BY CALLING THE SOUTHERN CALIFORNIA UNDERGROUND SERVICE ALERT AT 811.
7. CONTRACTOR IS TO COMPLETE SCRRRA'S TEMPORARY RIGHT OF ENTRY AGREEMENT, FORM 6". THIS FORM IS AVAILABLE ON SCRRRA'S WEBSITE AT WWW.METROLINKTRAINS.COM ("ABOUT US", AND "ENGINEERING AND CONSTRUCTION").
8. THE PIPELINE CROSSING CONSTRUCTION WILL BE DONE AS PER SCRRRA ENGINEERING STANDARD ES5001.
9. ANY PROPOSED EXCAVATION THAT MAY OCCUR IN SCRRRA RIGHT-OF-WAY OR THAT MAY AFFECT OPERATIONS ON SCRRRA TRACKS MUST ADHERE TO THE DESIGN, SUBMITTAL AND REVIEW REQUIREMENTS PRESENTED IN SCRRRA'S EXCAVATION SUPPORT GUIDELINES AND SHALL NOT PROCEED WITHOUT ACCEPTANCE BY SCRRRA. THE GUIDELINES ARE AVAILABLE ON SCRRRA'S WEBSITE WWW.METROLINKTRAINS.COM, (ABOUT US, AND ENGINEERING AND CONSTRUCTION).

**RECORD
DRAWINGS**


APPROVED BY: *[Signature]*

DATE: 2/9/17

| | | | | | | | |
|---|---|-----------------------------|--|--|--|--|--|
| <p>Don't Dig...Until You Call U.S.A. Toll Free 1-800-227-2600</p> <p>for the location of buried utility lines.</p> <p>Don't disrupt vital services.</p> <p>TWO WORKING DAYS BEFORE YOU DIG</p> | <p>BENCH MARK B.M. NO. S 327-1935 3.9 MI. NW FROM WINCHESTER 3.9 MI. NW ALONG THE ATCHISON, TOPEKA AND SANTA FE RAILWAY FROM THE STATION AT WINCHESTER, RIVERSIDE COUNTY, AT MENEFEE SIDING, 199 YRDS. NW OF THE SE SWITCH STAND, 72 FT. E. OF MILEPOST 6, 16.5 FT. NE. OF THE CENTERLINE OF THE TRACK AND 4.5 FT. NE. OF THE STATION SIGN. A STANDARD DISK, STAMPED R 327 1935 AND SET IN THE TOP OF A CONCRETE POST. E.L. 1478.07</p> | REVISIONS | | RIVERSIDE COUNTY FLOOD CONTROL AND WATER CONSERVATION DISTRICT | | <p>ROMOLAND MDP LINE A-3 STAGE 1</p> <p>TITLE SHEET SCRRRA AND RCTC NOTES</p> | <p>PROJECT NO. 4-0-00431</p> <p>DRAWING NO. 4-871</p> <p>SHEET NO. 1A OF 25</p> |
| | | | | | | | |
| | | DESIGNED BY: ROHINI MUSTAFA | RECOMMENDED FOR APPROVAL BY: <u><i>[Signature]</i></u> | APPROVED BY: <u><i>[Signature]</i></u> | | | |
| | | DRAWN BY: MICHAEL ARMENTA | DATE: <u>9/23/2014</u> | DATE: <u>22 Sept 2014</u> | | | |
| REF. | DESCRIPTION | APPR. | DATE | | | | |

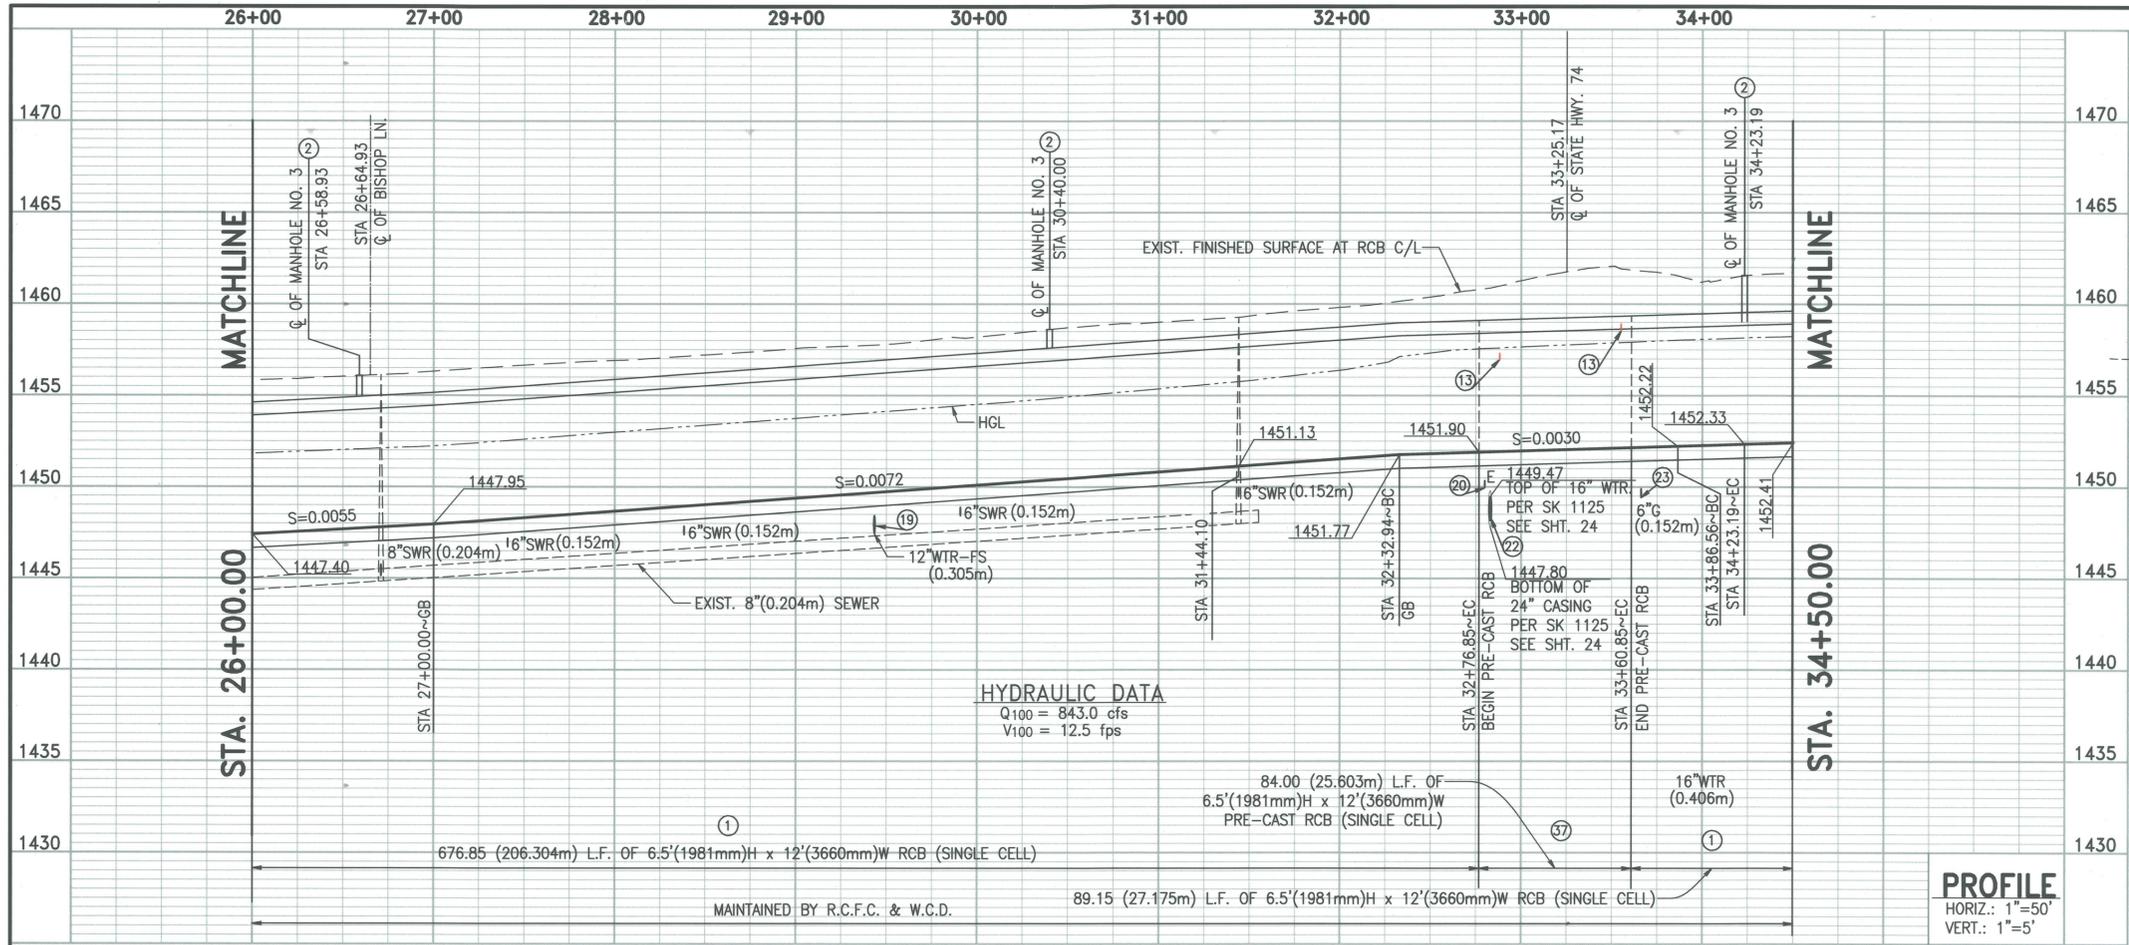

NOTE: CONTRACTOR SHALL PROTECT IN PLACE ALL UTILITIES CROSSING OR PARALLELING THE CHANNEL UNLESS OTHERWISE NOTED.

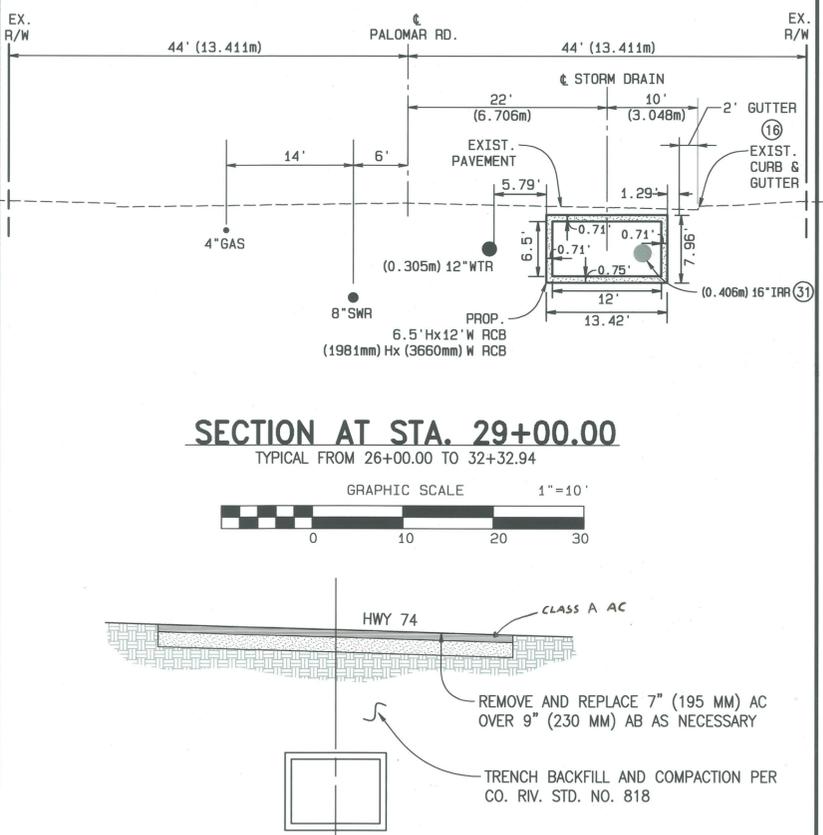


SECTION AT STA. 33+25.17
N.T.S.

CONSTRUCTION NOTES


- ① CONSTRUCT 6.5'(1981mm)Hx12.0'(3660mm)W RCB (SINGLE CELL) PER CALTRANS STD. D80
- ② CONSTRUCT MANHOLE NO. 3 PER RCFWCWD STD. DWG. MH253
- ⑬ EXISTING TELEPHONE LINE TO BE REMOVED & REPLACED BY OTHERS
- ⑭ EXISTING IMPROVEMENTS TO BE REMOVED AND REPLACED
- ⑰ EXISTING FIRE SERVICE TO BE REMOVED AND REPLACED AS SHOWN
- ⑳ EXISTING ELECTRIC LINE TO BE REMOVED AND REPLACED BY SCE
- ㉑ EXISTING 16"(0.406m) WATER LINE TO BE RELOCATED PER SK-1125 SEE SHEET 24
- ㉒ EXISTING 6"(0.152m) GAS LINE RELOCATED BY OTHERS AS SHOWN
- ㉓ EXISTING TRAFFIC SIGNAL DETECTOR SENSORS TO BE REMOVED AND REPLACED
- ㉔ EXISTING 16"(0.406m) IRRIGATION LINE TO BE REMOVED
- ㉕ REMOVE AND REPLACE 7" (195 MM) AC OVER 9" (230 MM) AB AS NECESSARY PER SECTION HEREON
- ㉖ INSTALL PRE-CAST 6.5'(1981mm)Hx12.0'(3660mm)W RCB (SINGLE CELL) PER DETAIL ON SHT. NO. 20

| Δ | R | T | L | BC | EC |
|-----------|--------------------|-----------------|------------------|---------------|---------------|
| 05°01'54" | 500.00' (152.400m) | 21.97' (6.697m) | 43.91' (13.384m) | STA. 32+32.94 | STA. 32+76.85 |
| 04°11'50" | 500.00' (152.400m) | 18.32' (5.584m) | 36.63' (11.165m) | STA. 33+86.56 | STA. 34+23.19 |

CALTRANS PERMIT NUMBER: 08-05-N-MC-0356
IP 050154 MS 4051

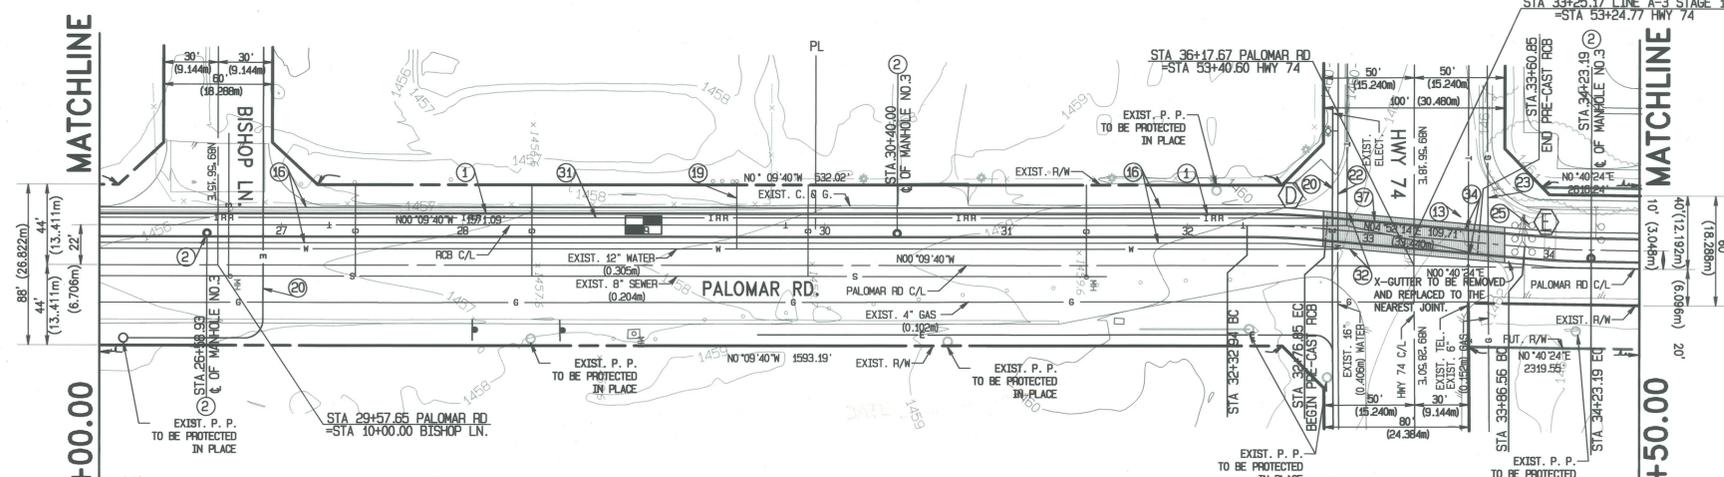

SEAL-COUNTY COUNTY OF RIVERSIDE
TRANSPORTATION DEPARTMENT
 APPROVED BY: *Alan French* 12-18-07
 ALAN D. FRENCH, P.E. DATE
 R.C.E. 45702 EXP. 12-31-08
 CIVIL 12/18/07
 RECOMMENDED BY: *Albert A. Webb* DATE

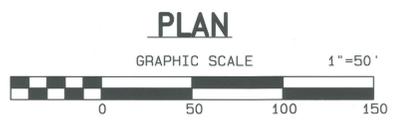

ALBERT A. 3788 McCRAY ST. RIVERSIDE, CA. 92506
WEBB ASSOCIATES PH. (951) 686-1070
 PREPARED BY: *Albert A. Webb* DATE: 12-13-07
 R.C.E. NO. C44762 EXP. DATE 3-31-08

Don't Dig...Until You Call U.S.A. Toll Free 1-800-227-2600
 for the location of buried utility lines.
 Don't disrupt vital services.
 TWO WORKING DAYS BEFORE YOU DIG

| REF. | DESCRIPTION | APPR. | DATE |
|------|-------------|-------|------|
| | | | |

DESIGNED BY: J.C.C.
 DRAWN BY: R.R.
 DATE DRAWN: Dec 2007
 CHECKED BY: *[Signature]*


RIVERSIDE COUNTY FLOOD CONTROL AND WATER CONSERVATION DISTRICT
 RECOMMENDED FOR APPROVAL BY: *[Signature]*
 DATE: 12/18/07

APPROVED BY: *[Signature]*
 DATE: 1-3-2008


ROMOLAND MDP
LINE A-3 STAGE 1
 STA. 26+00.00 TO STA. 34+50.00

PROJECT NO. 4-0-00431
 DRAWING NO. 4-871
 SHEET NO. 4 OF 25


6:\2003\03-0338\DWG\PROJ\0333\LINE_A3.prd 12/10/2007

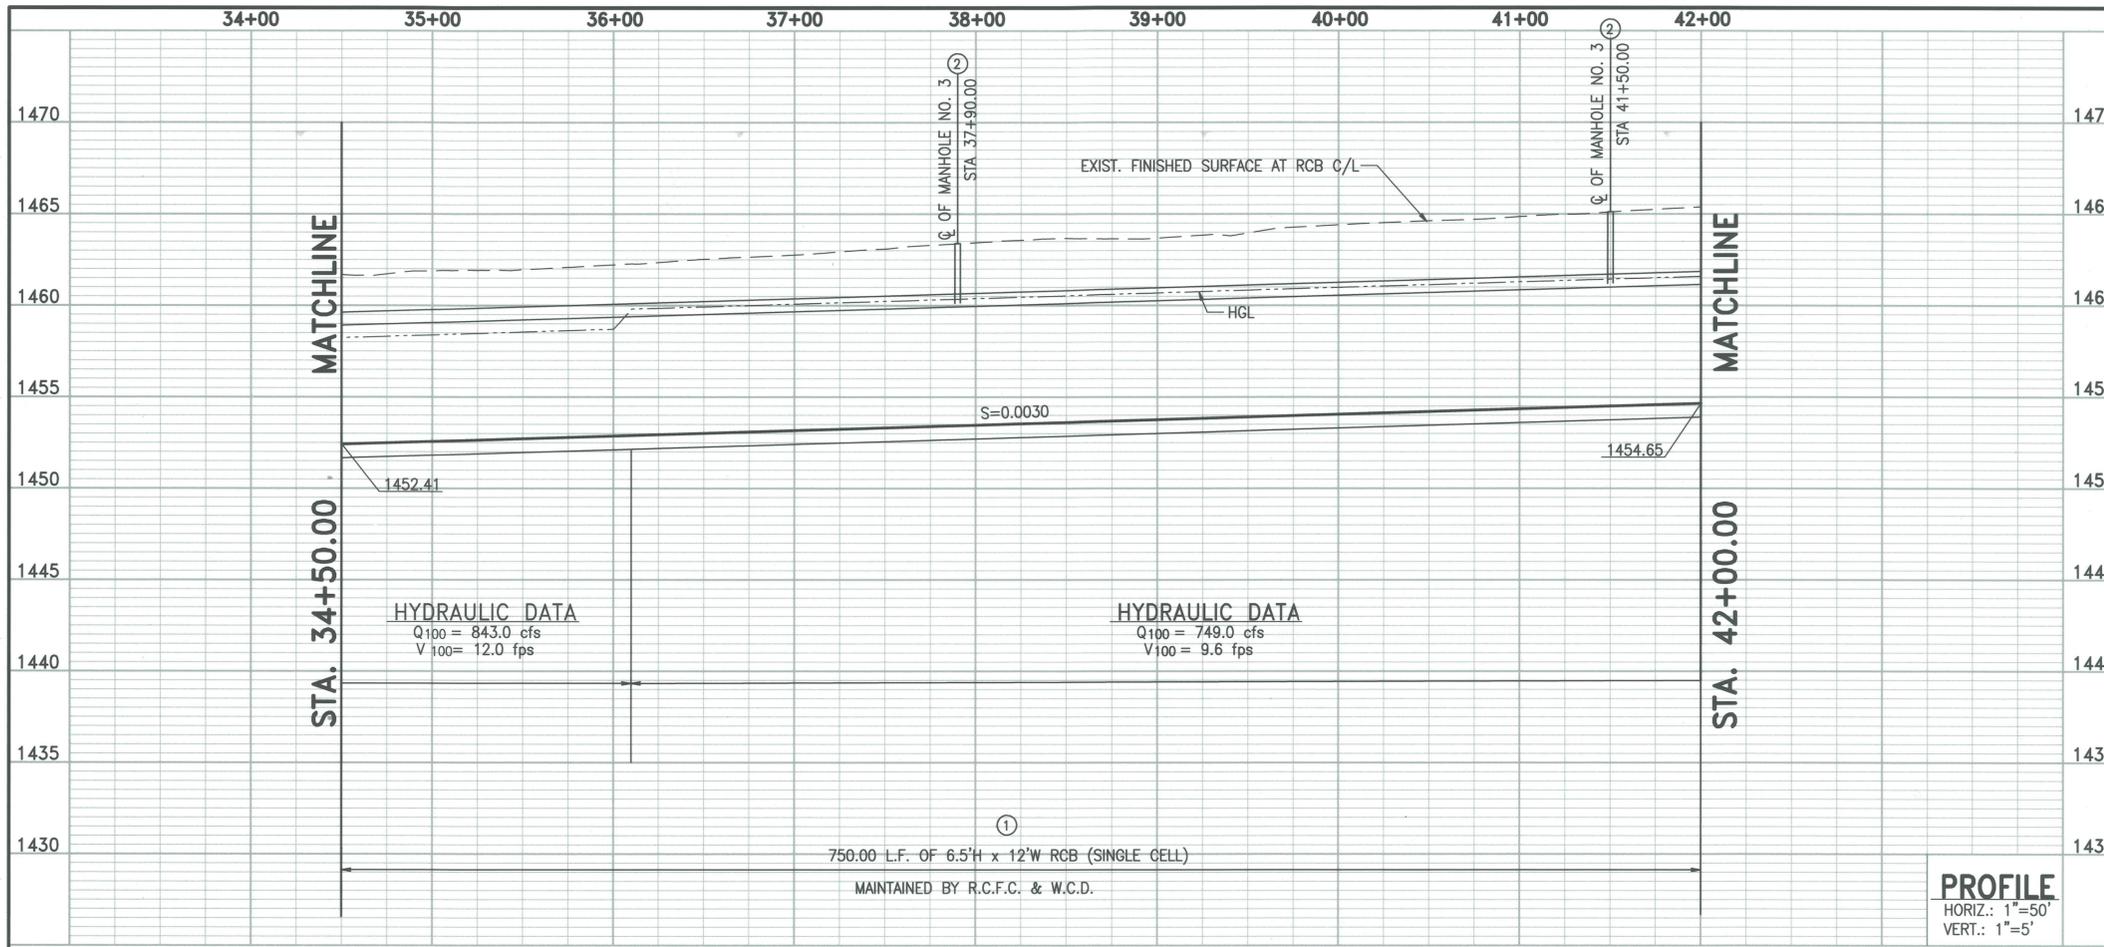

NOTE: CONTRACTOR SHALL PROTECT IN PLACE ALL UTILITIES CROSSING OR PARALLELING THE CHANNEL UNLESS OTHERWISE NOTED.

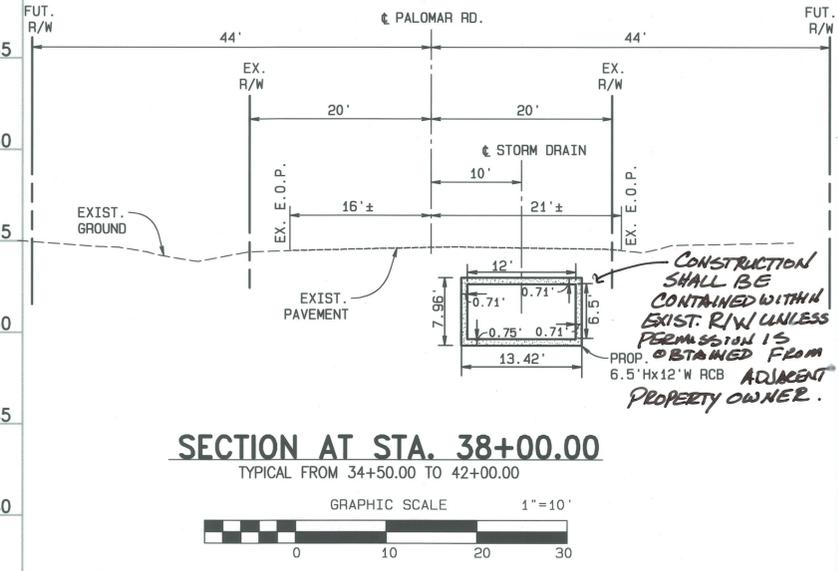


CONSTRUCTION SHALL BE CONTAINED WITHIN EXIST. R/W UNLESS PERMISSION IS OBTAINED FROM 6.5'Hx12'W RCB ADJACENT PROPERTY OWNER.

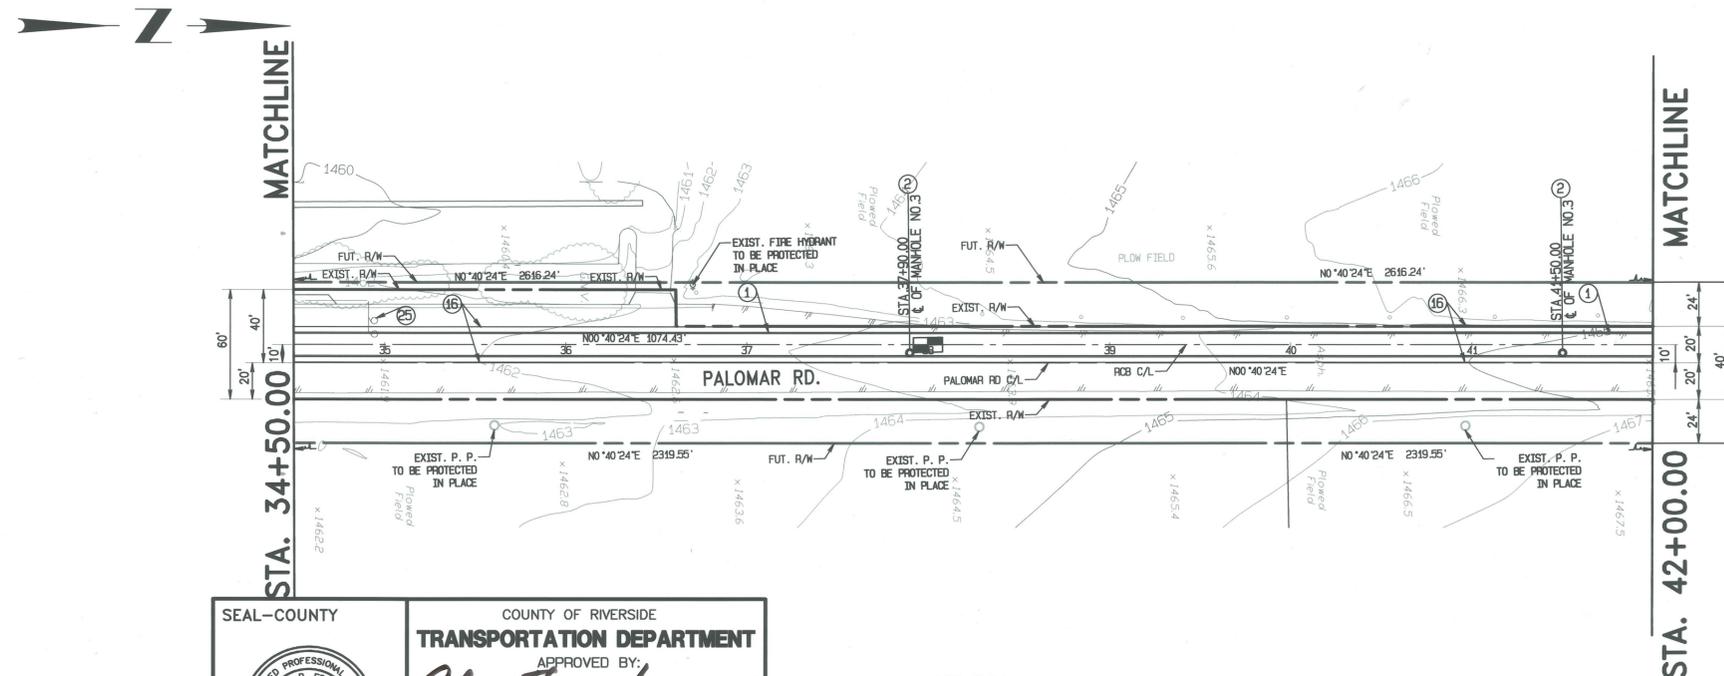

CONSTRUCTION NOTES

- ① CONSTRUCT 6.5'Hx12.0'W RCB (SINGLE CELL) PER CALTRANS STD. D80
- ② CONSTRUCT MANHOLE NO. 3 PER RCFWCD STD. DWG. MH253
- ⑬ EXISTING IMPROVEMENTS TO BE REMOVED AND REPLACED AS NECESSARY
- ⑮ EXISTING TRAFFIC SIGNAL DETECTOR SENSORS TO BE REMOVED AND REPLACED AS NECESSARY

SEAL-COUNTY COUNTY OF RIVERSIDE
TRANSPORTATION DEPARTMENT
 APPROVED BY: *Alan French* 12-18-07
 ALAN D. FRENCH, P.E. DATE
 R.C.E. 45702 EXP. 12-31-08
 RECOMMENDED BY: *HP* 12/18/07
 DATE

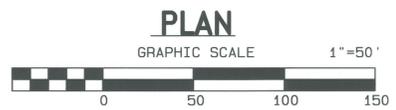

RECORD DRAWING

IP 050154 MS 4051

ALBERT A. WEBB ASSOCIATES
 3788 McCRAY ST. RIVERSIDE, CA. 92506
 PH. (951) 686-1070
 PREPARED BY: *Albert Webb* DATE: 12/18/07
 R.C.E. NO. C44762 EXP. DATE 3-31-08

Don't Dig...Until You Call U.S.A. Toll Free 1-800-227-2600
 for the location of buried utility lines.
 Don't disrupt vital services.
 TWO WORKING DAYS BEFORE YOU DIG

PERMANENT BENCH MARK
 B.M. NO. S 327-1935
 3.9 MI. NW FROM WINCHESTER
 AND SANTA FE RAILWAY FROM THE STATION
 AT WINCHESTER, RIVERSIDE COUNTY, AT
 MENEFEE SIDING, 198 YDS. NW OF THE
 SE SWITCH STAND, 72 FT. E OF MILEPOST 6,
 16.5 FT. NE OF THE CENTERLINE OF THE TRACK,
 AND 4.5 FT. NE OF THE STATION SIGN. A
 STANDARD DISK, STAMPED P 327 1935 AND
 SET IN THE TOP OF A CONCRETE POST.
 ELEVATION: 1478.07

| REF. | DESCRIPTION | APPR. | DATE |
|------|-------------|-------|------|
| | | | |
| | | | |

DESIGNED BY: J.C.C.
 DRAWN BY: R.R.
 DATE DRAWN: Dec 2007
 CHECKED BY:

RIVERSIDE COUNTY FLOOD CONTROL AND WATER CONSERVATION DISTRICT
 RECOMMENDED FOR APPROVAL BY: *John Olson*
 DATE: 12/18/07

APPROVED BY: *Shant E. P. K. W.*
 DATE: 1-3-2008

ROMOLAND MDP
LINE A-3 STAGE 1
 STA. 34+50.00 TO STA. 42+00.00

PROJECT NO. 4-0-00431
 DRAWING NO. 4-871
 SHEET NO. 5 OF 25

G:\2003\03-0338\DWG\PRO\0338BLINE_A3.prt 12/10/2007